


SEEDING  
END WIDTH SQ. YDS.

153  
306

LAKE COUNTY  
LAK-1-1038

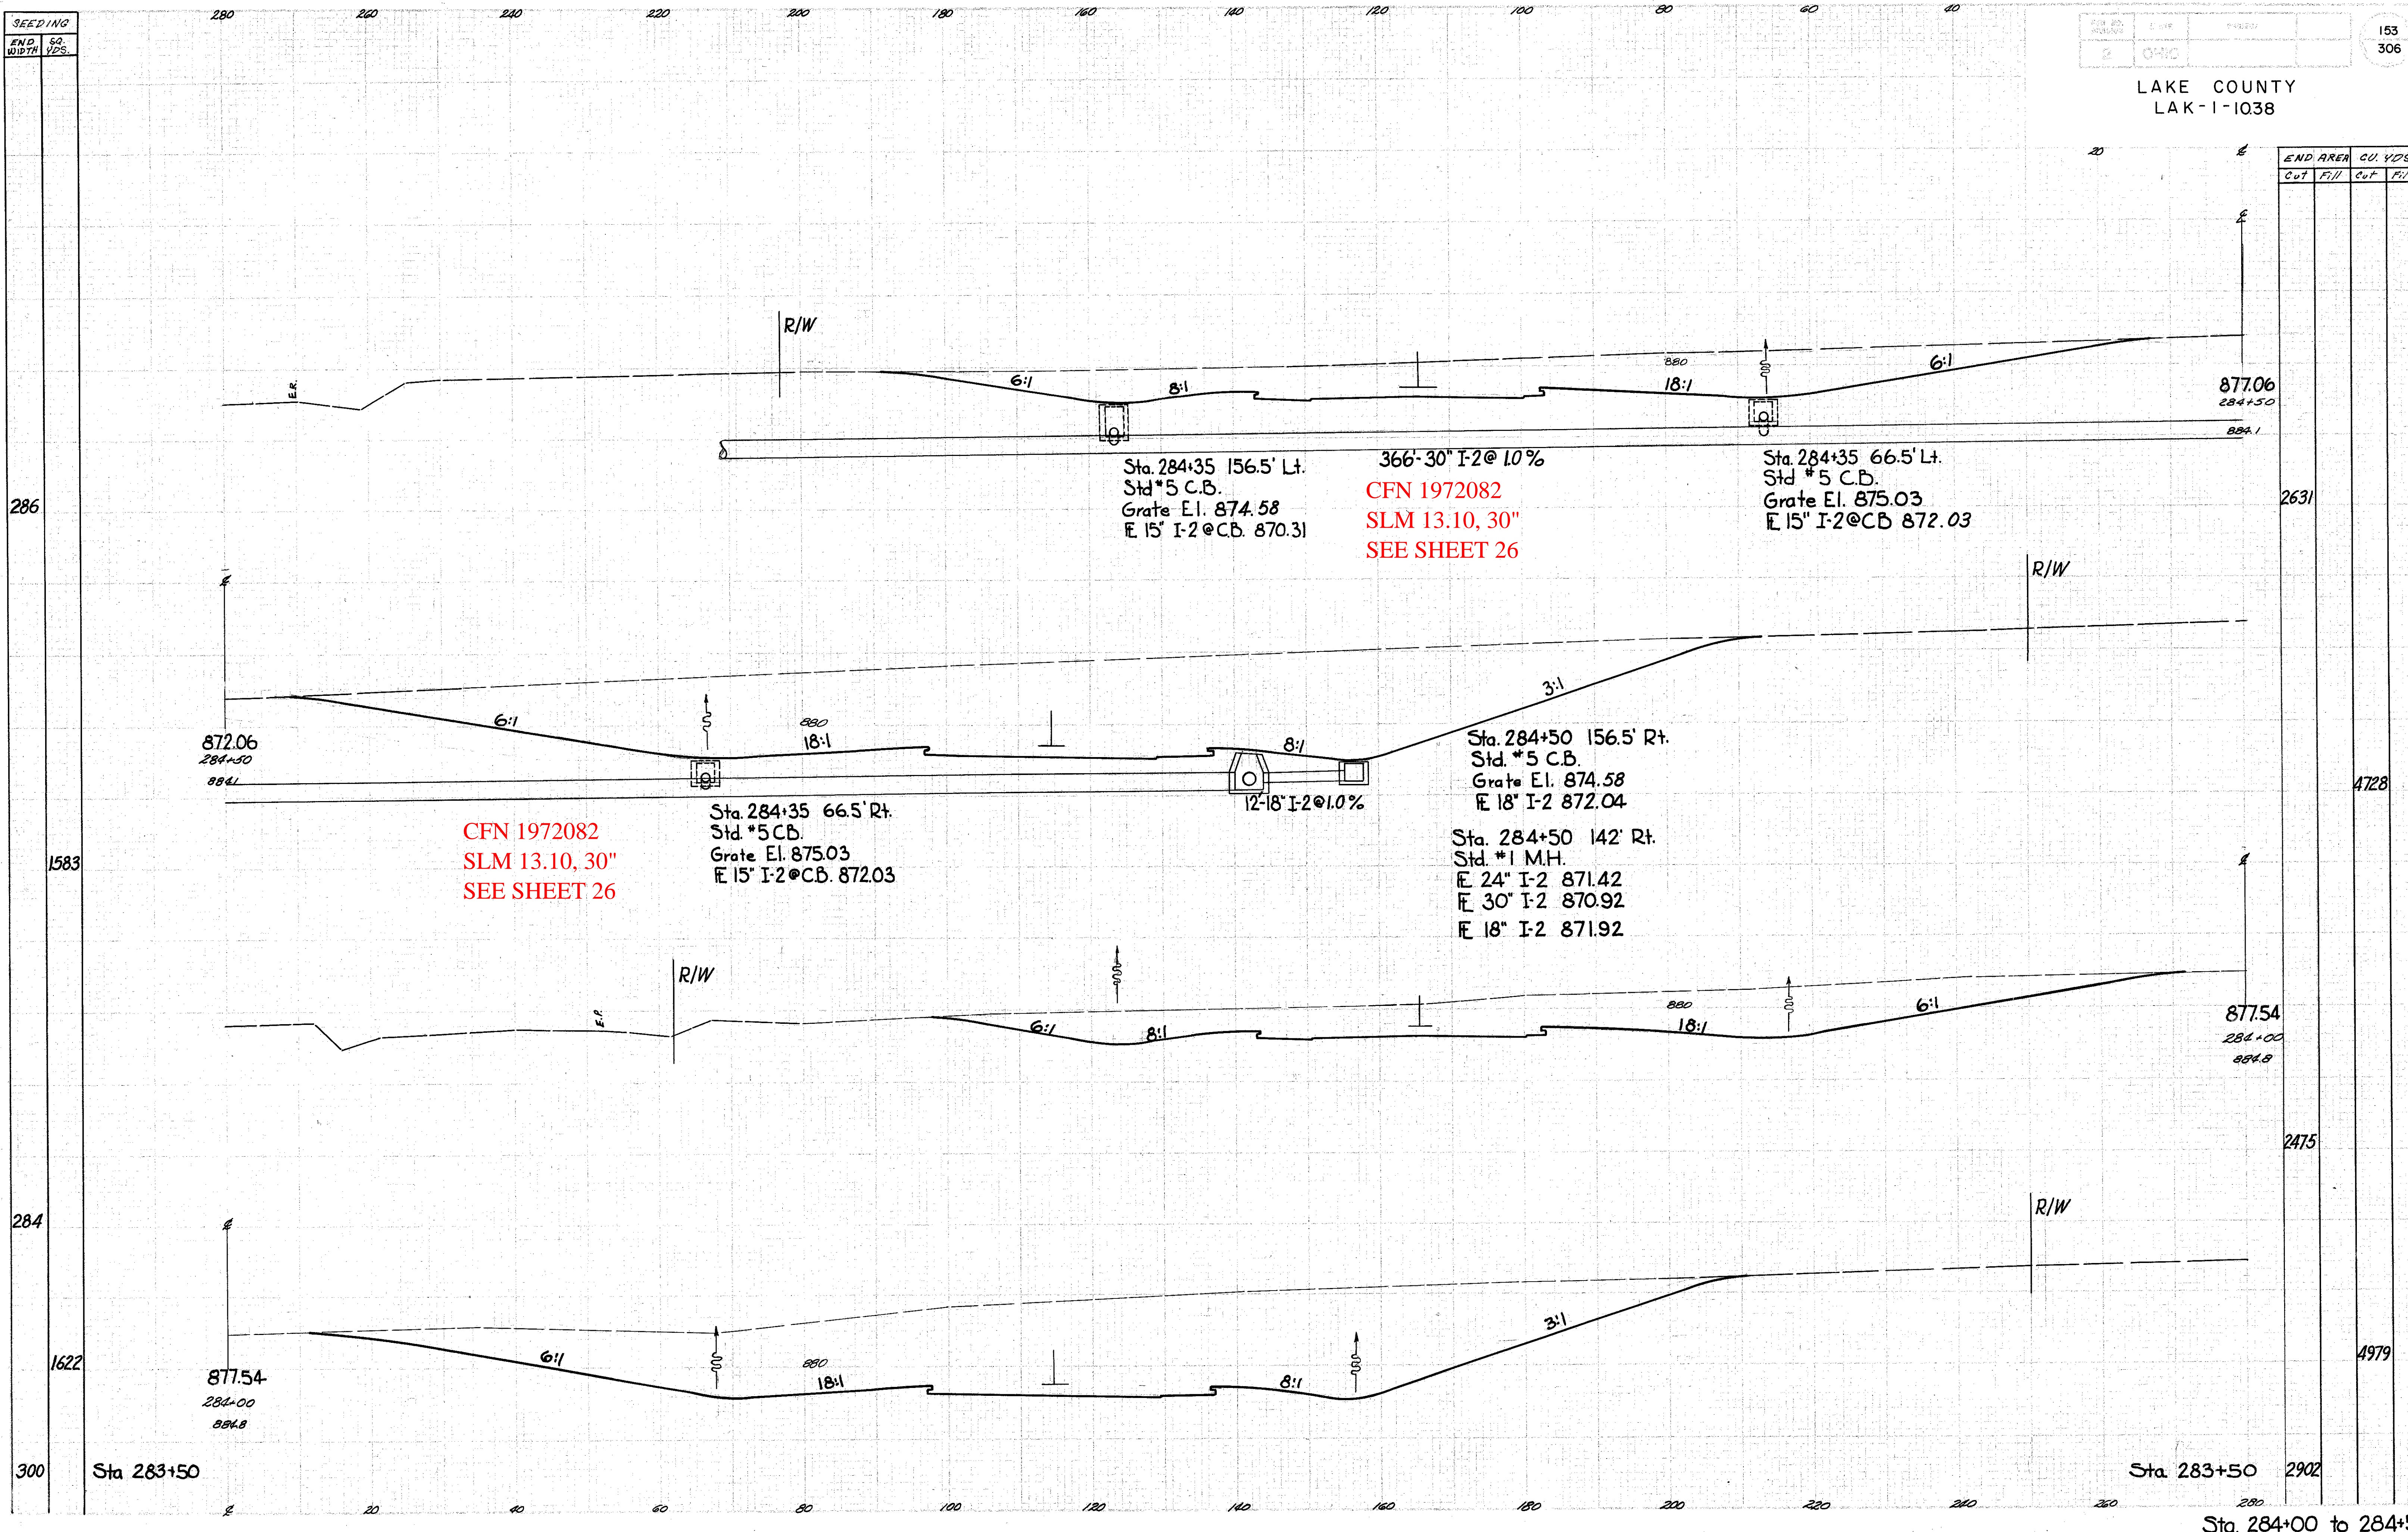

Sta. 284+35 156.5' Lt.  
Std. #5 C.B.  
Grate El. 874.58  
E 15" I-2 @ C.B. 870.31

366'-30" I-2 @ 1.0%  
CFN 1972082  
SLM 13.10, 30"  
SEE SHEET 26

Sta. 284+35 66.5' Lt.  
Std. #5 C.B.  
Grate El. 875.03  
E 15" I-2 @ C.B. 872.03

Sta. 284+35 66.5' Rt.  
Std. #5 C.B.  
Grate El. 875.03  
E 15" I-2 @ C.B. 872.03

CFN 1972082  
SLM 13.10, 30"  
SEE SHEET 26

Sta. 284+50 156.5' Rt.  
Std. #5 C.B.  
Grate El. 874.58  
E 18" I-2 872.04

Sta. 284+50 142' Rt.  
Std. #1 M.H.  
E 24" I-2 871.42  
E 30" I-2 870.92  
E 18" I-2 871.92

286

2631

1583

4728

284

2475

1622

4979

300

Sta 283+50

Sta. 283+50

2902

Sta. 284+00 to 284+50

END AREA		CU. YDS.	
Cut	Fill	Cut	Fill