LAKE COUNTY
LAK-1-10.38

CFN 1972078
SLM 13.71, 24"
SEE SHEET 183

SLM 13.72, 21"
SEE BELOW

CFN 1972080
SLM 13.74, 15"
SEE SHEET 180

HERMITAGE RD
SLM 13.70, MM 199.71

SLM 13.71, 15"
SEE BELOW

SLM 13.72, 24"
SEE BELOW

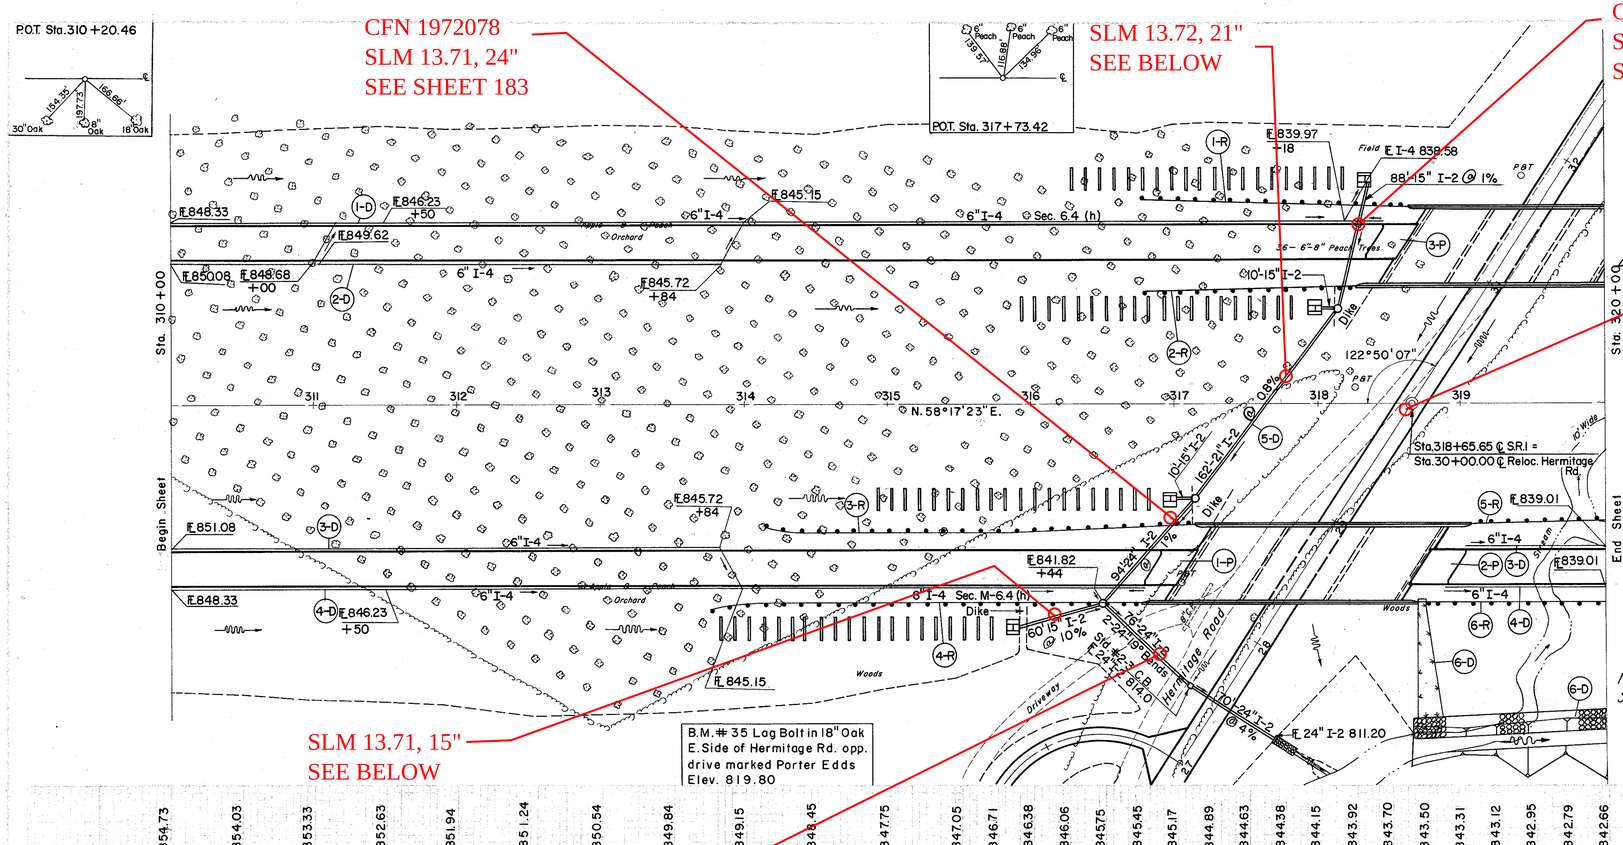

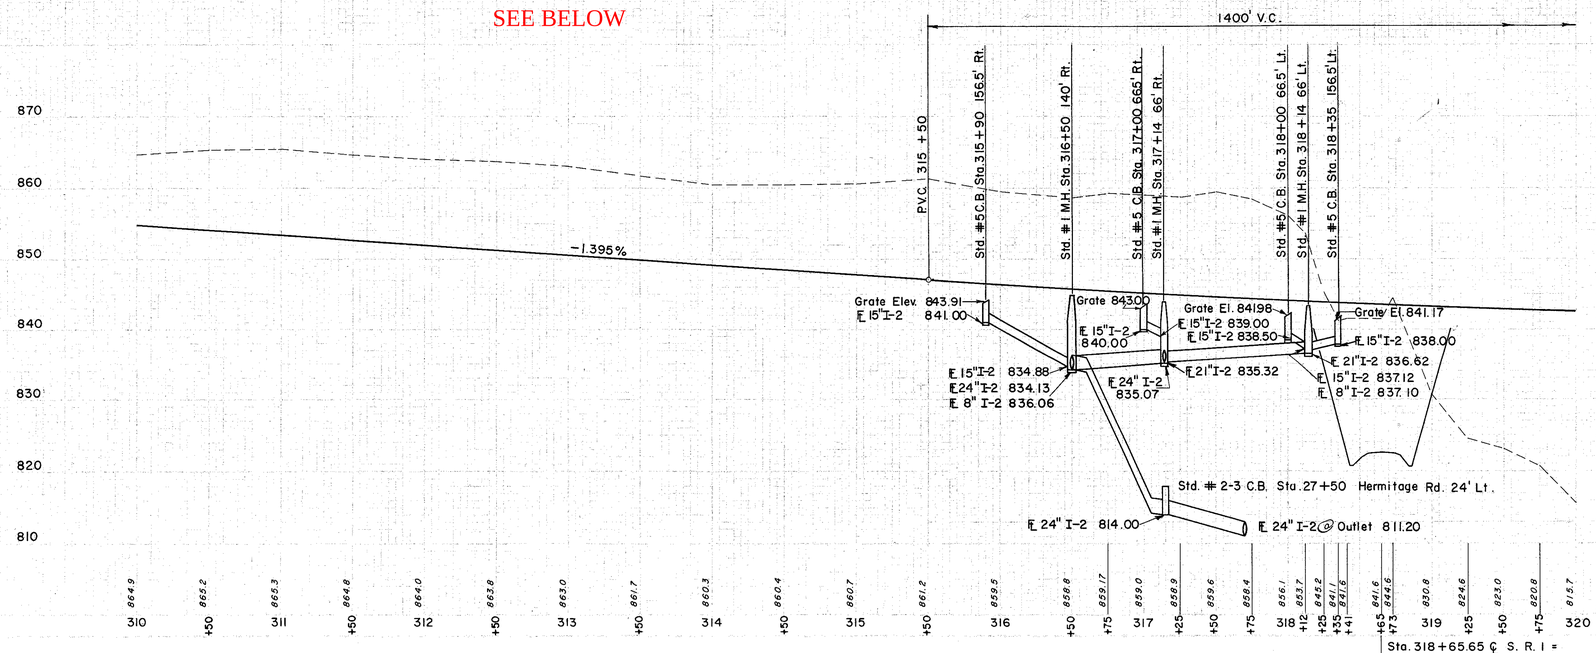

(D) DRAINAGE

REF. NO.	STATION FROM	STATION TO	SIDE OR ℄	CLASS "A" STORM SWR. UNDER PAVEMENT SEC. M-6.5 (b) or M-6.8 (b) 15"	24"	CLASS "A" STORM SWR. SEC. M-6.5 (a) OR SEC. M-6.6(a) (a) OR SEC. M-6.8 (a) 15"	24"	CL. "A" STM. SWR. SEC. M-6.6(b) or M-6.8(b) 21"	24"	6" PIPE UNDERDRAIN SHALLOW	DEEP	SEC. M-6.4 (c)
1-D	310+00	318+45	LT.							430		494
2-D	310+00	313+85	LT.									
3-D	310+00	320+00	RT.							378		
4-D	310+00	320+00	RT.							482		
5-D	315+90	318+35	—							112		308
6-D	318+65	320+00	RT.								400	
				88	164	80		76	162			
				I-2						I-4		
				L.F.								

REF. NO.	STATION FROM	STATION TO	SIDE OR ℄	6" 60° WYE SEC. M-6.4(h)	24" 19° BENDS SEC. M-6.4(h)	8" OUTLET PIPE SEC. M-6.4(a)	I-5
1-D	310+00	318+45	LT.	2		10	
2-D	310+00	313+85	LT.	1			
3-D	310+00	320+00	RT.		2		
4-D	310+00	320+00	RT.	2			
5-D	315+90	318+35	—	1			
6-D	318+65	320+00	RT.		2	10	

REF. NO.	STATION FROM	STATION TO	SIDE OR ℄	E-3 CHANNEL EXC.	E-2 EXC. FOR STRUCT.	S-1 CONC. FOR STRUCT. CL. "E"	L-10 SODDING FOR SPECIAL BERM & SLOPE PROTECT.	SODDING	I-10 DUMPED ROCK CHANNEL PROTECT.	I-8 STD. # 2-3 CATCH BASIN	STD. # 1 M.H.	STD. #5 CATCH BASIN	24" 19° BENDS SEC. M-6.4(a)	6" 60° WYE SEC. M-6.4(h)	8" OUTLET PIPE SEC. M-6.4(a)
1-D	310+00	318+45	LT.	334	2	0.4	111	2.15	175	1	3	4	2	2	10
2-D	310+00	313+85	LT.												
3-D	310+00	320+00	RT.												
4-D	310+00	320+00	RT.												
5-D	315+90	318+35	—												
6-D	318+65	320+00	RT.												
				C.Y.	C.Y.	C.Y.	S.Y.		C.Y.	EACH					
				I-4											

(P) PAVEMENT

REF. NO.	STATION FROM	STATION TO	SIDE OR ℄	I-7 REINF. CONC. APPROACH SLAB (LT-15") S.Y.
1-P	316+86.08	317+11.08	RT.	67
2-P	318+72.44	318+97.44	RT.	67
3-P	318+45.86	318+70.86	LT.	67
		TOTAL		201

(R) ROADWAY

REF. NO.	STATION FROM	STATION TO	SIDE OR ℄	SIDE BEAM, STD. (MP) (DEEP) 2-15 GUARD RAIL, STEEL ℄ L.F.
1-R	316+75.5	318+63	LT.	187.5
2-R	316+77	318+27	LT.	150.0
3-R	314+16	317+16	RT.	300.0
4-R	313+78	316+78	RT.	300.0
5-R	319+09	320+09	RT.	100
6-R	318+71	320+04.5	RT.	137.5
		TOTAL		1175.0

EXCAVATION	115,311 C.Y.
EMBANKMENT	14,595 C.Y.
EARTH BORROW	17,222 C.Y.
	18

STA. 310+00 TO STA. 320+00