SLM 3.25, 27"
SEE BELOW

SLM 3.14=
MM 189.15

CFN 1971952
SLM 3.25, 30"
SEE BELOW

SLM 3.29, 30"
SEE SHEET 154

SR 91
SLM 3.28=
MM 189.29

old CFN 430900335
new CFN 1849711
SLM 3.35, 36"
SEE SHEET 22,
266 AND 300

SFN 4303547
SLM 3.19, SEE
SHEET 265

SLM 3.20, 30"
SEE BELOW

CFN 1971951
SLM 3.20, 30"
SEE BELOW

SEE 1993 CUY/LAK-271/90/271X/90X-14.85/2.76/0.00/2.76
PLANS FOR MODIFICATIONS TO STORM SEWERS

| FED. RD. DIVISION | STATE | PROJECT | |
|---|---|---|---|
| 2 | OHIO | I-1103 (19) | |

21
312

LAKE COUNTY
LAK-I-2.16

~LEGEND~
1. Standard Longitudinal Joint.
2. Standard Key Joint without Tie Bars.
3. Expansion Joint without Dowels (Location Red Lines)
4. Expansion Joint with Dowels.

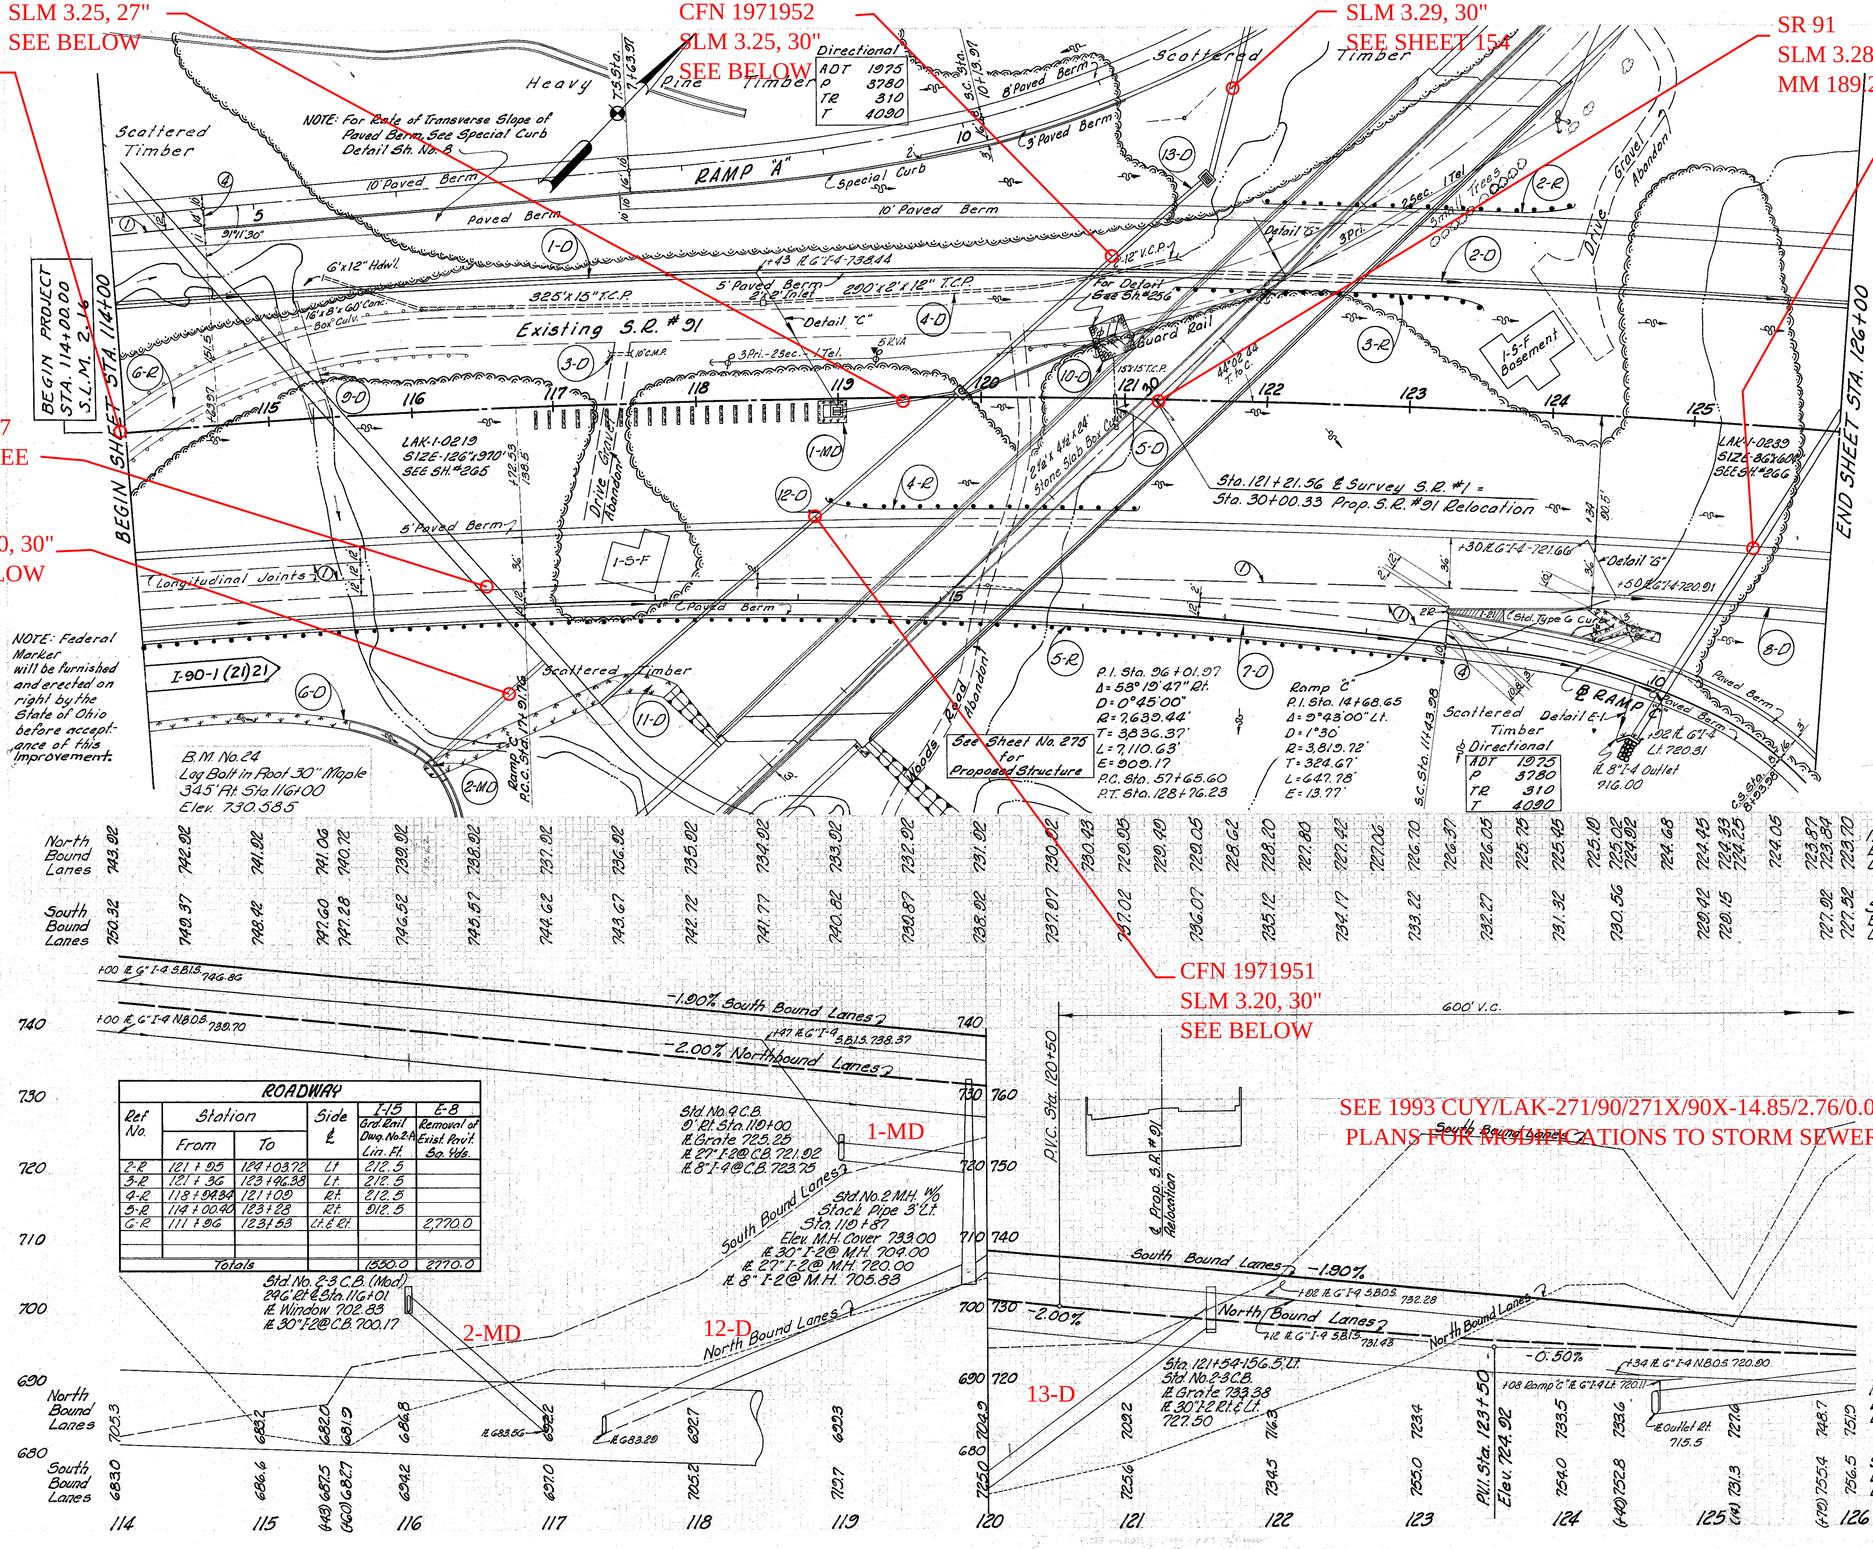


| ROADWAY | | | | | |
|---|---|---|---|---|---|
| Ref. No. | Station From | Station To | Side ℄ | I-15 Grd Rail Dwg. No. 2-A Lin. Ft. | E-8 Removal of Exist. Pavt. Sq. Yds. |
| 2-R | 121+05 | 124+03.72 | Lt. | 212.5 | |
| 3-R | 121+36 | 123+96.38 | Lt. | 212.5 | |
| 4-R | 118+94.34 | 121+05 | Rt. | 212.5 | |
| 5-R | 114+00.40 | 123+28 | Rt. | 912.5 | |
| 6-R | 111+96 | 123+53 | Lt. & Rt. | | 2,770.0 |
| | | | | | |
| | | | | | |
| | Totals | | | 1550.0 | 2770.0 |

| DRAINAGE | | | | |