LAKE COUNTY
LAK-1-2.16

Seeding End Width	Sq.Yd.
117	
1196	
159	
2245	
245	
2678	

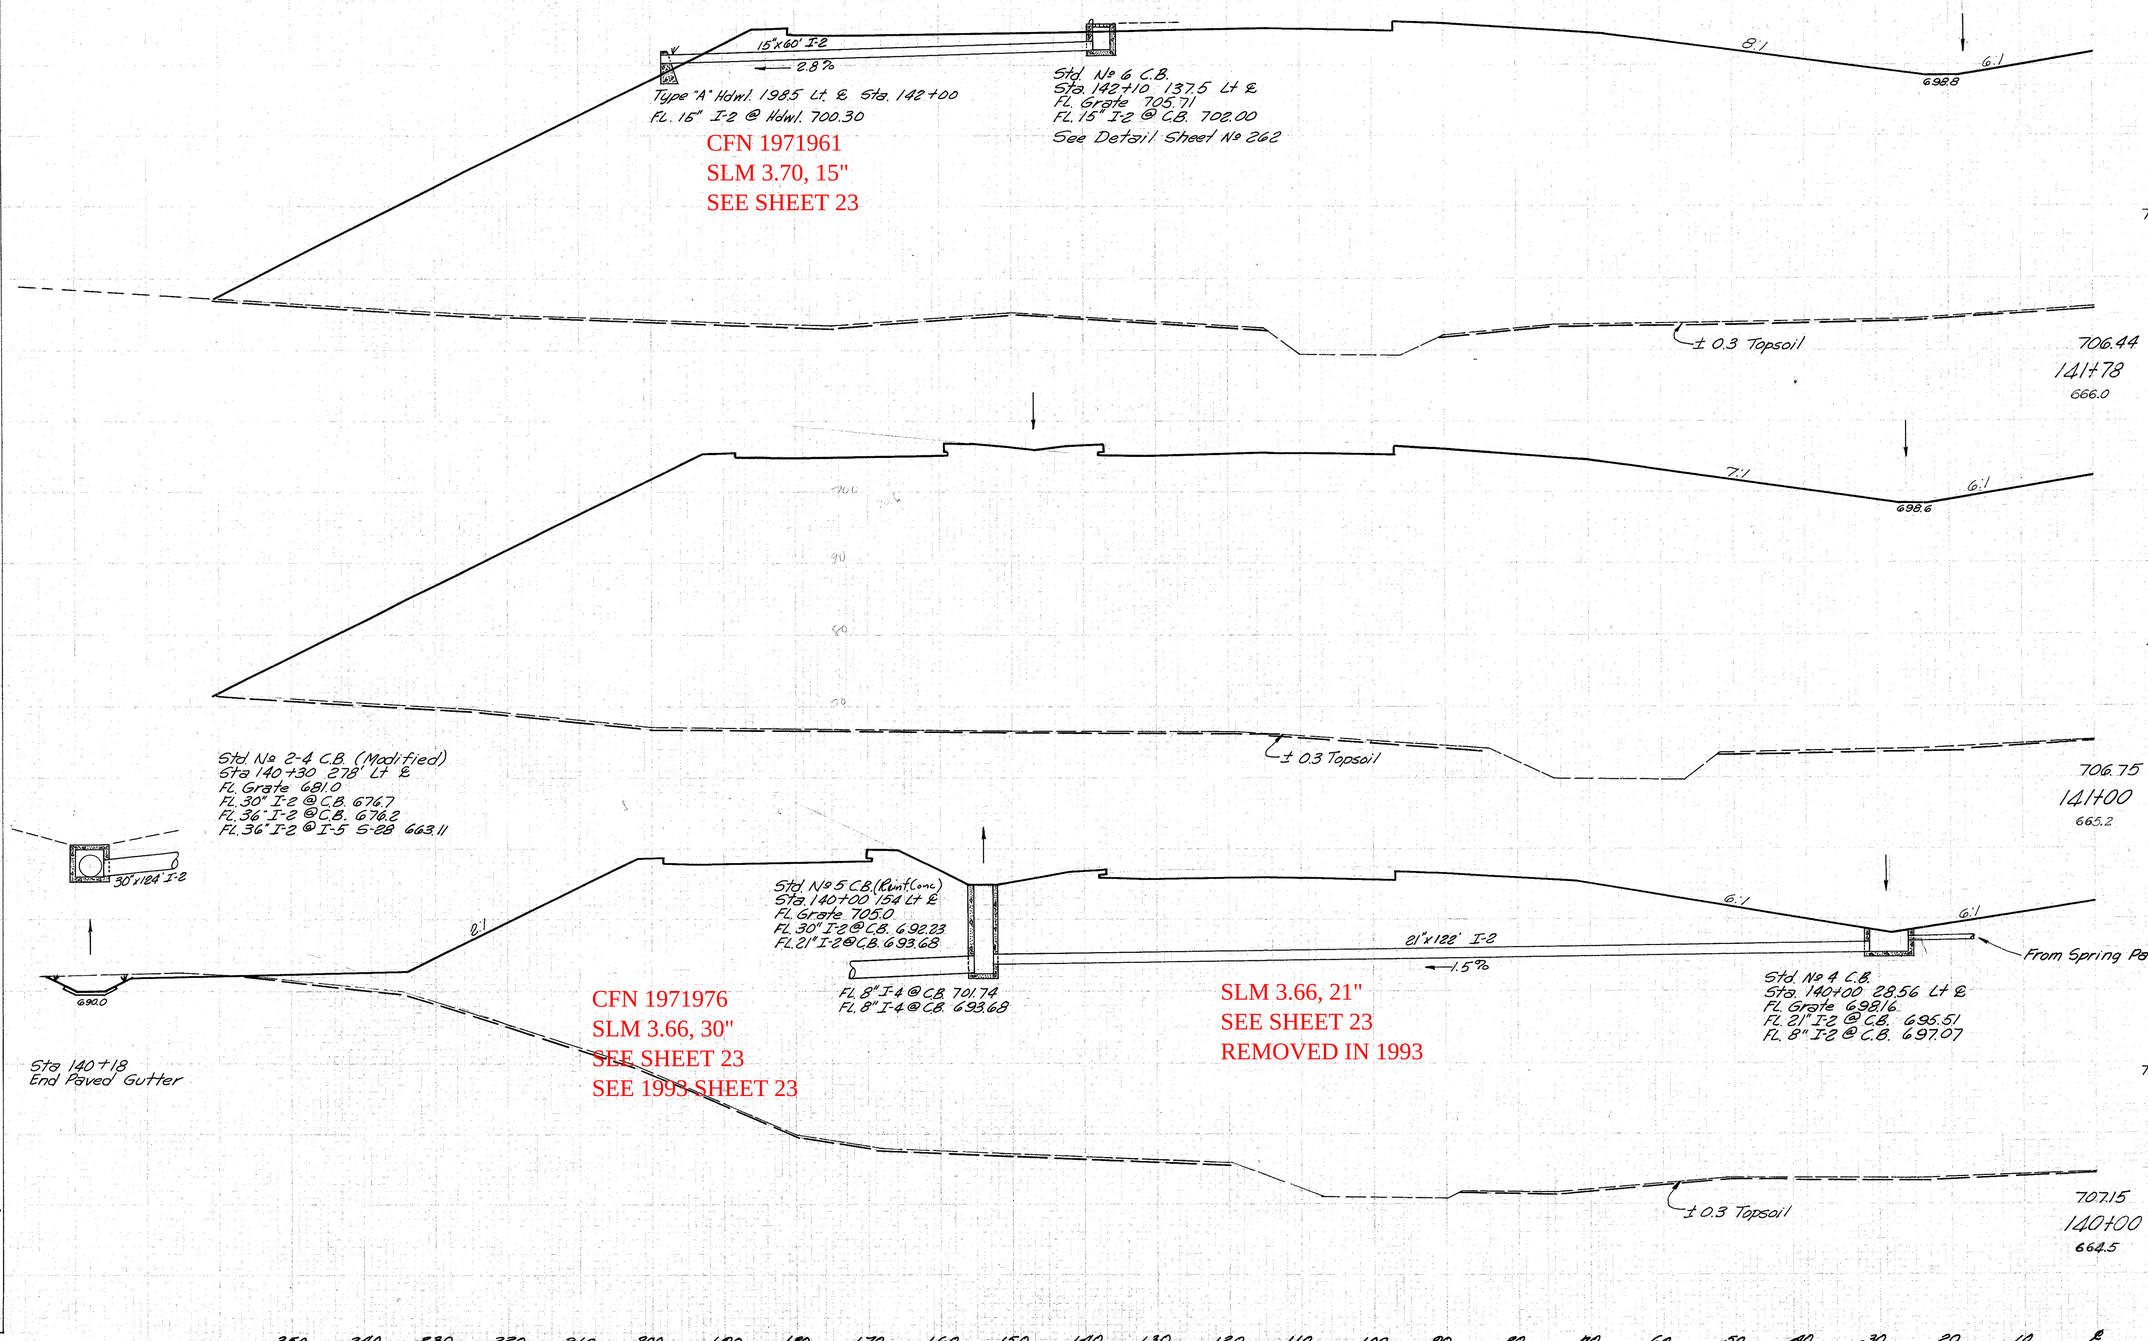

	End Area Cut	End Area Fill	Volume Cut	Volume Fill
Topsoil	72			
	0	3069		
Topsoil	205		25989	
Topsoil	70			
	0	8923		
Topsoil	257			
	20		32280	
Topsoil	69			
	11		8508	
Topsoil	270			
	35		28372	