2 OHIO I-1103 (19)
81
312

LAKE COUNTY
LAK-1-2.16

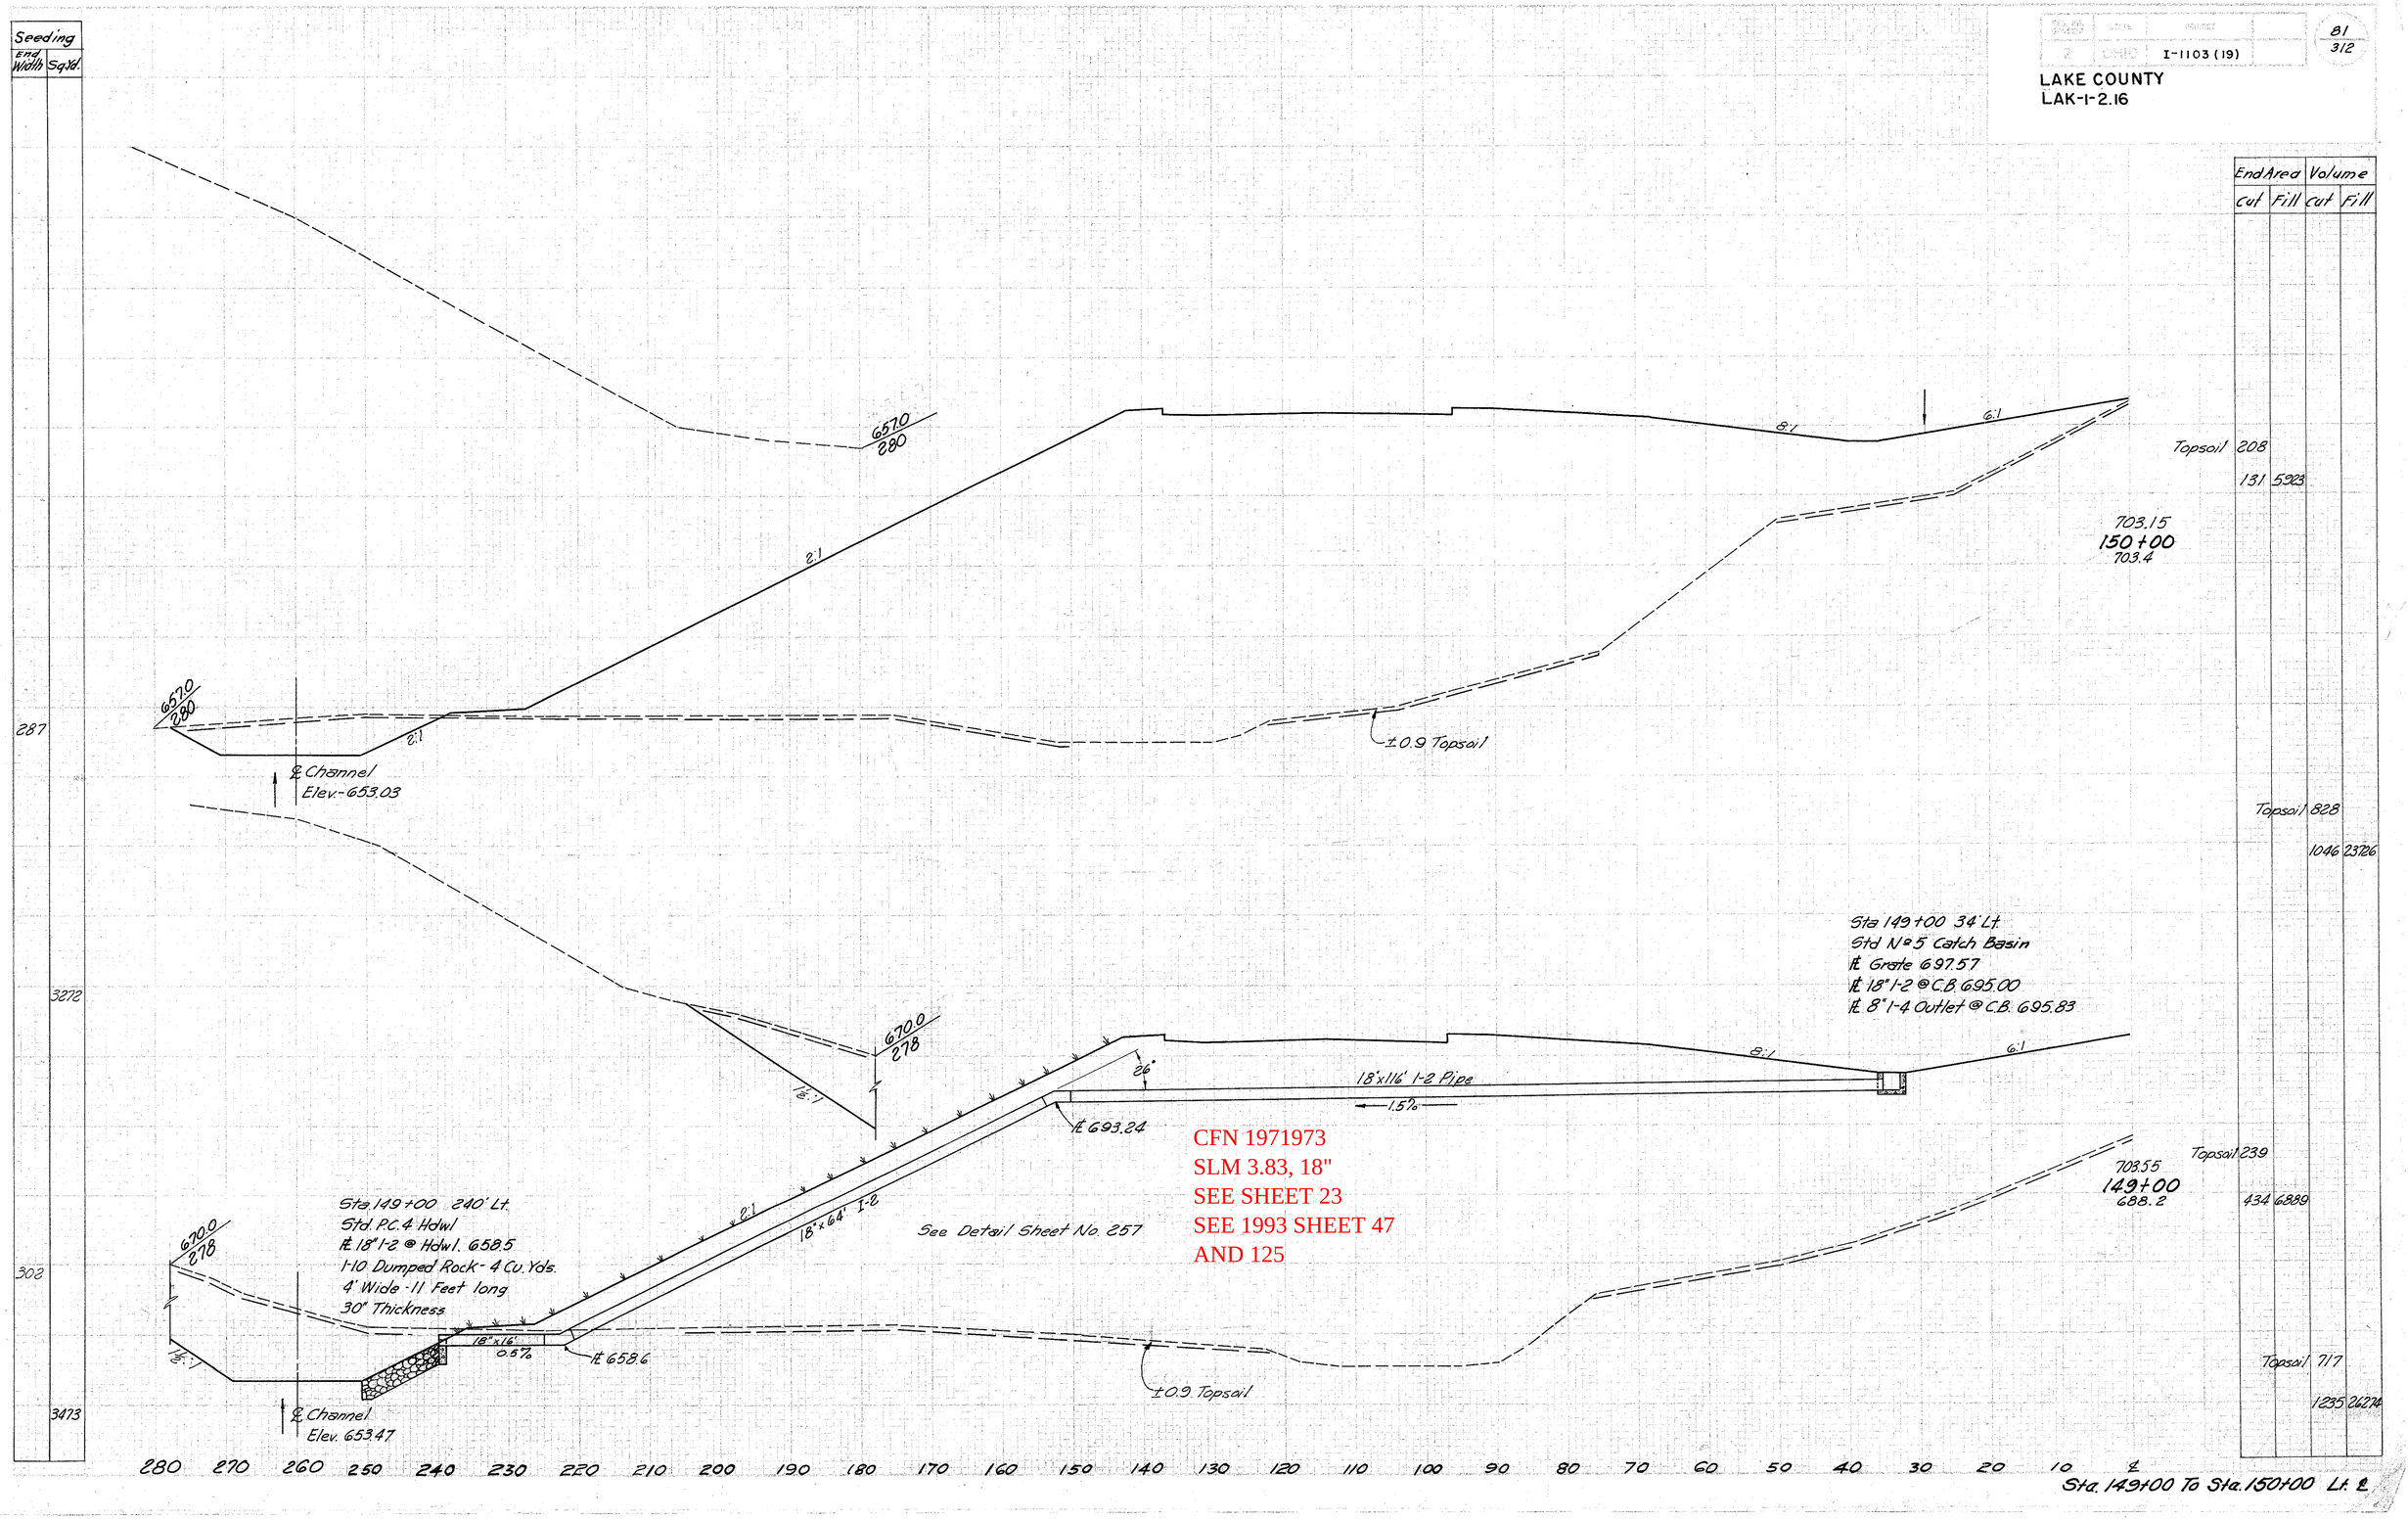

CFN 1971973
SLM 3.83, 18"
SEE SHEET 23
SEE 1993 SHEET 47
AND 125

Sta. 149+00 To Sta. 150+00 Lt. ℄