


LAKE COUNTY
LAK-1-402

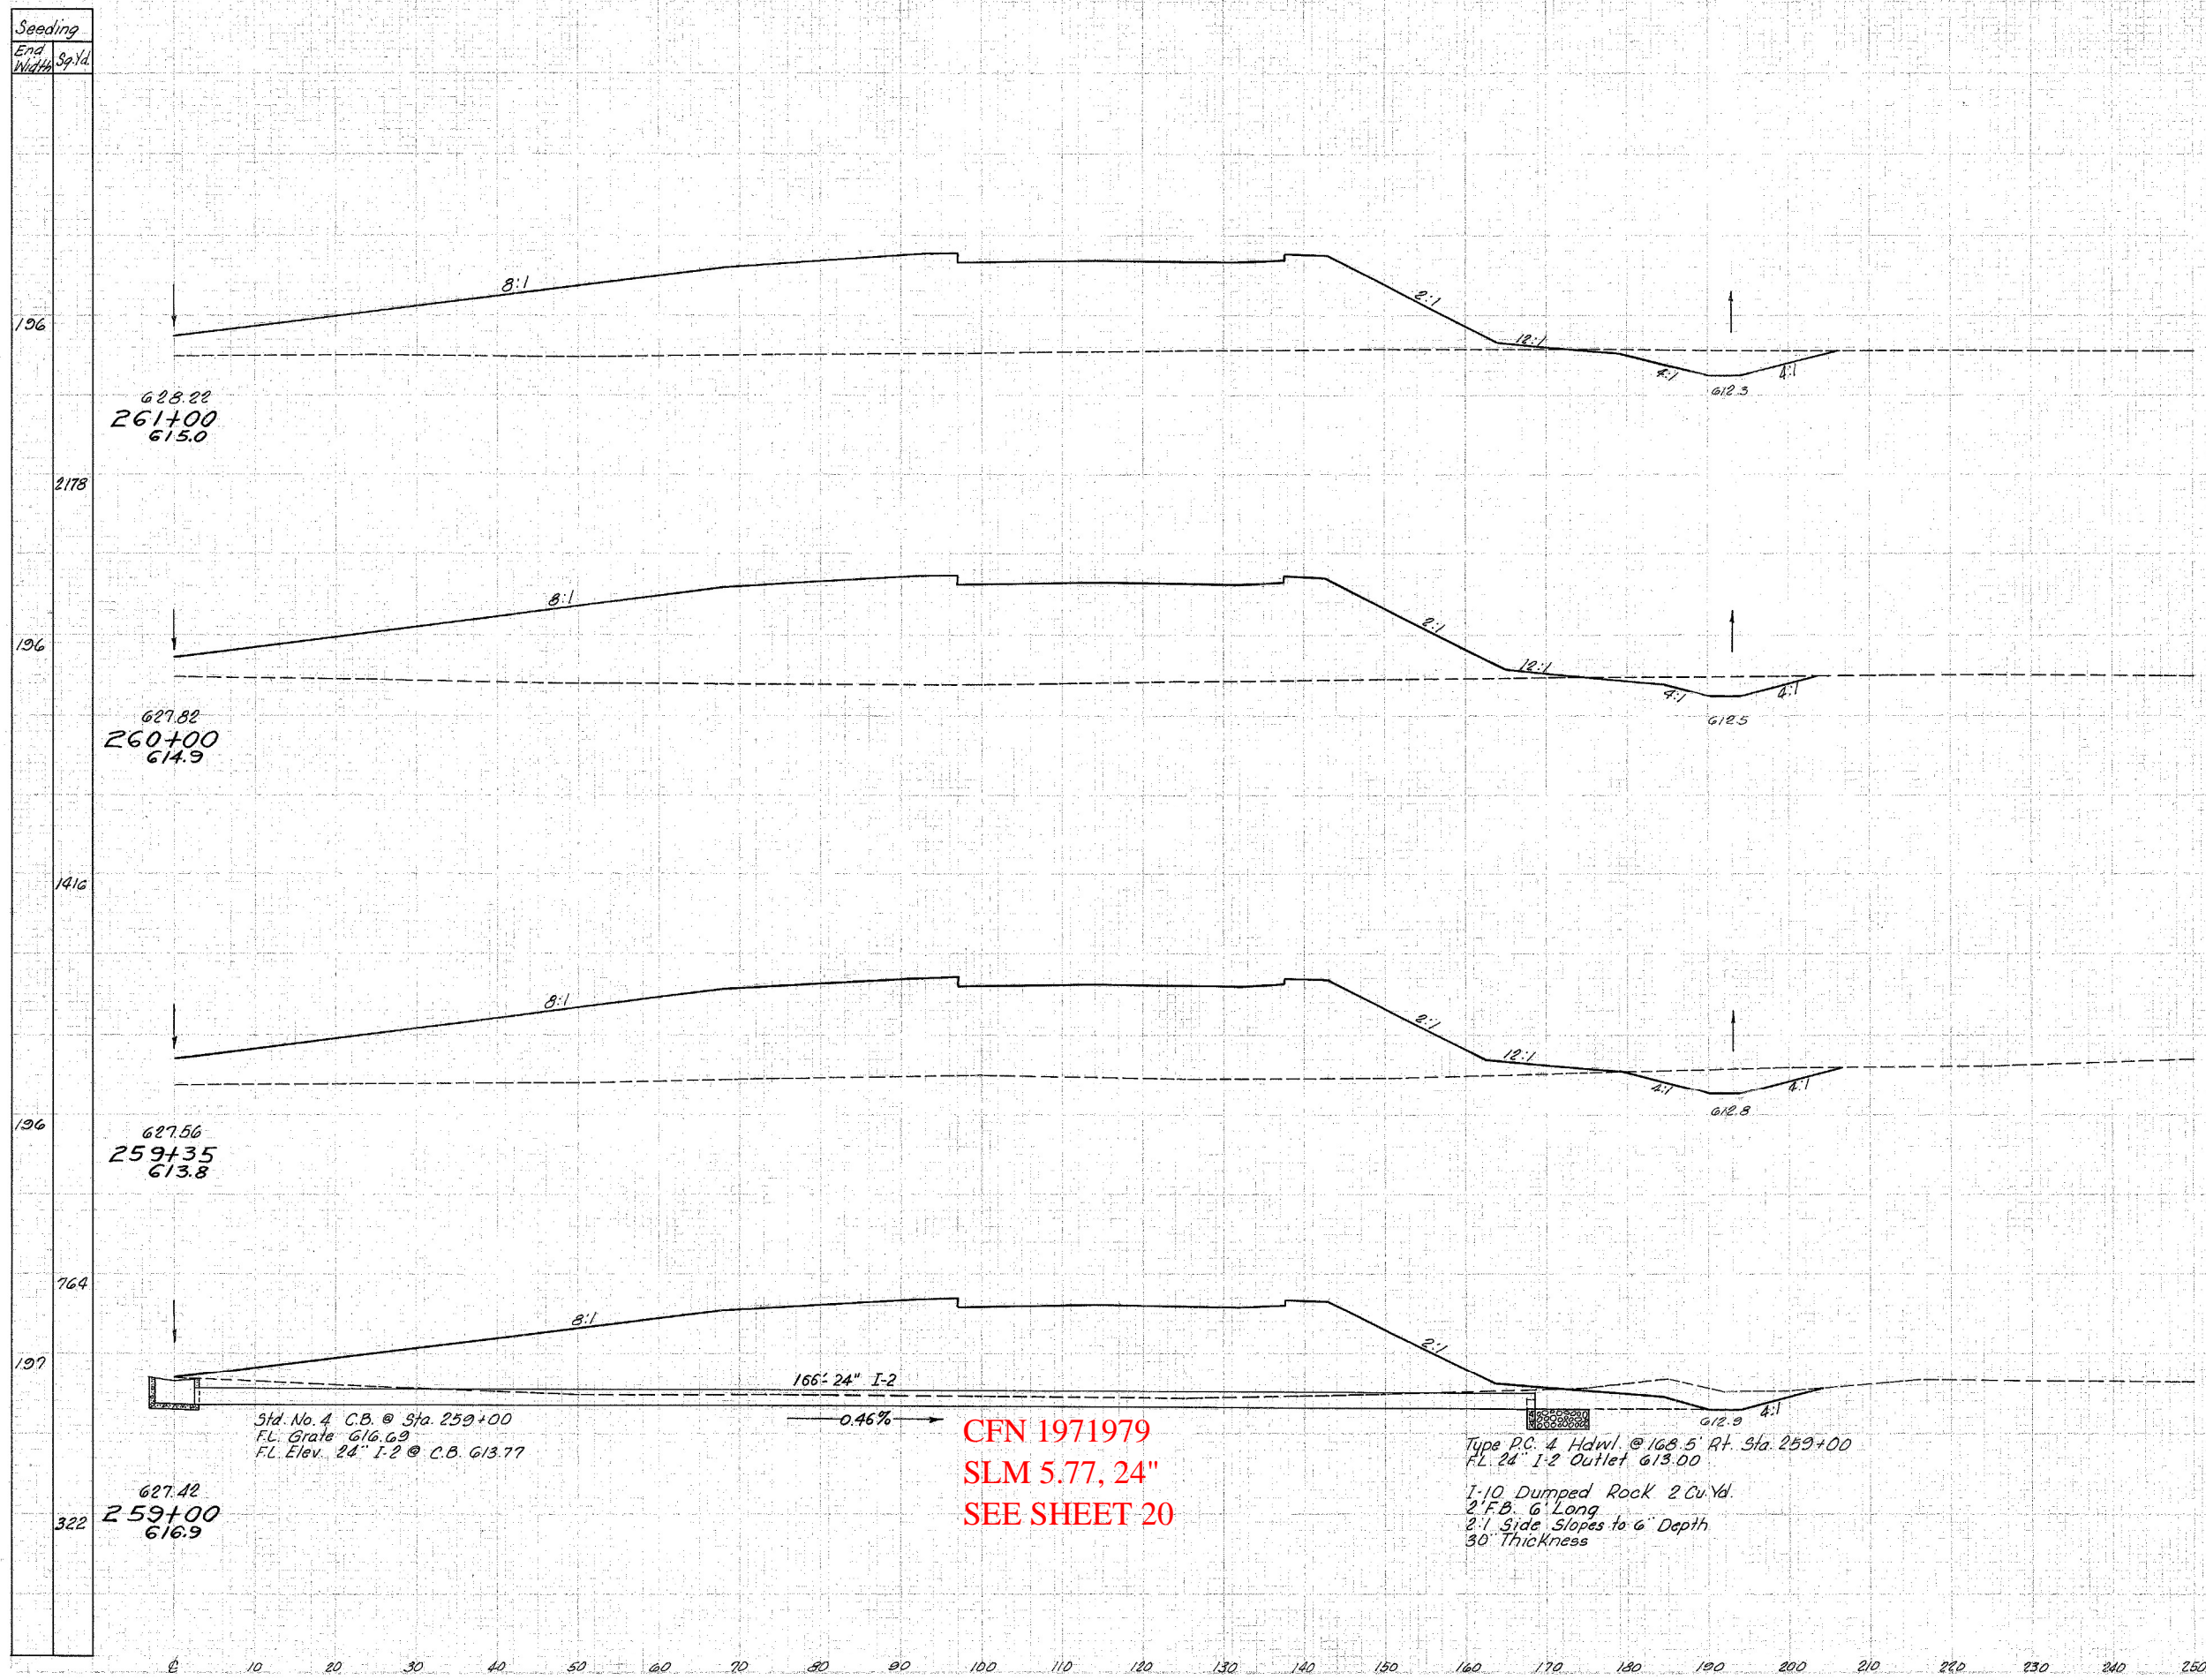

End Area		Volume	
Cut	Fill	Cut	Fill
55	1468		
		174	5617
39	1566		
		109	3687
51	1498		
		64	1872
48	1390		
		28	697

Sta. 259+00 to Sta. 261+00 Rt. &