


Seeding
End Area
Width

FED. RD. DIVISION	STATE	PROJECT	171
2	OHIO	1-1103 (18)	458

CUYAHOGA & LAKE COUNTIES
CUY-1-15.91
LAK-1-0.00

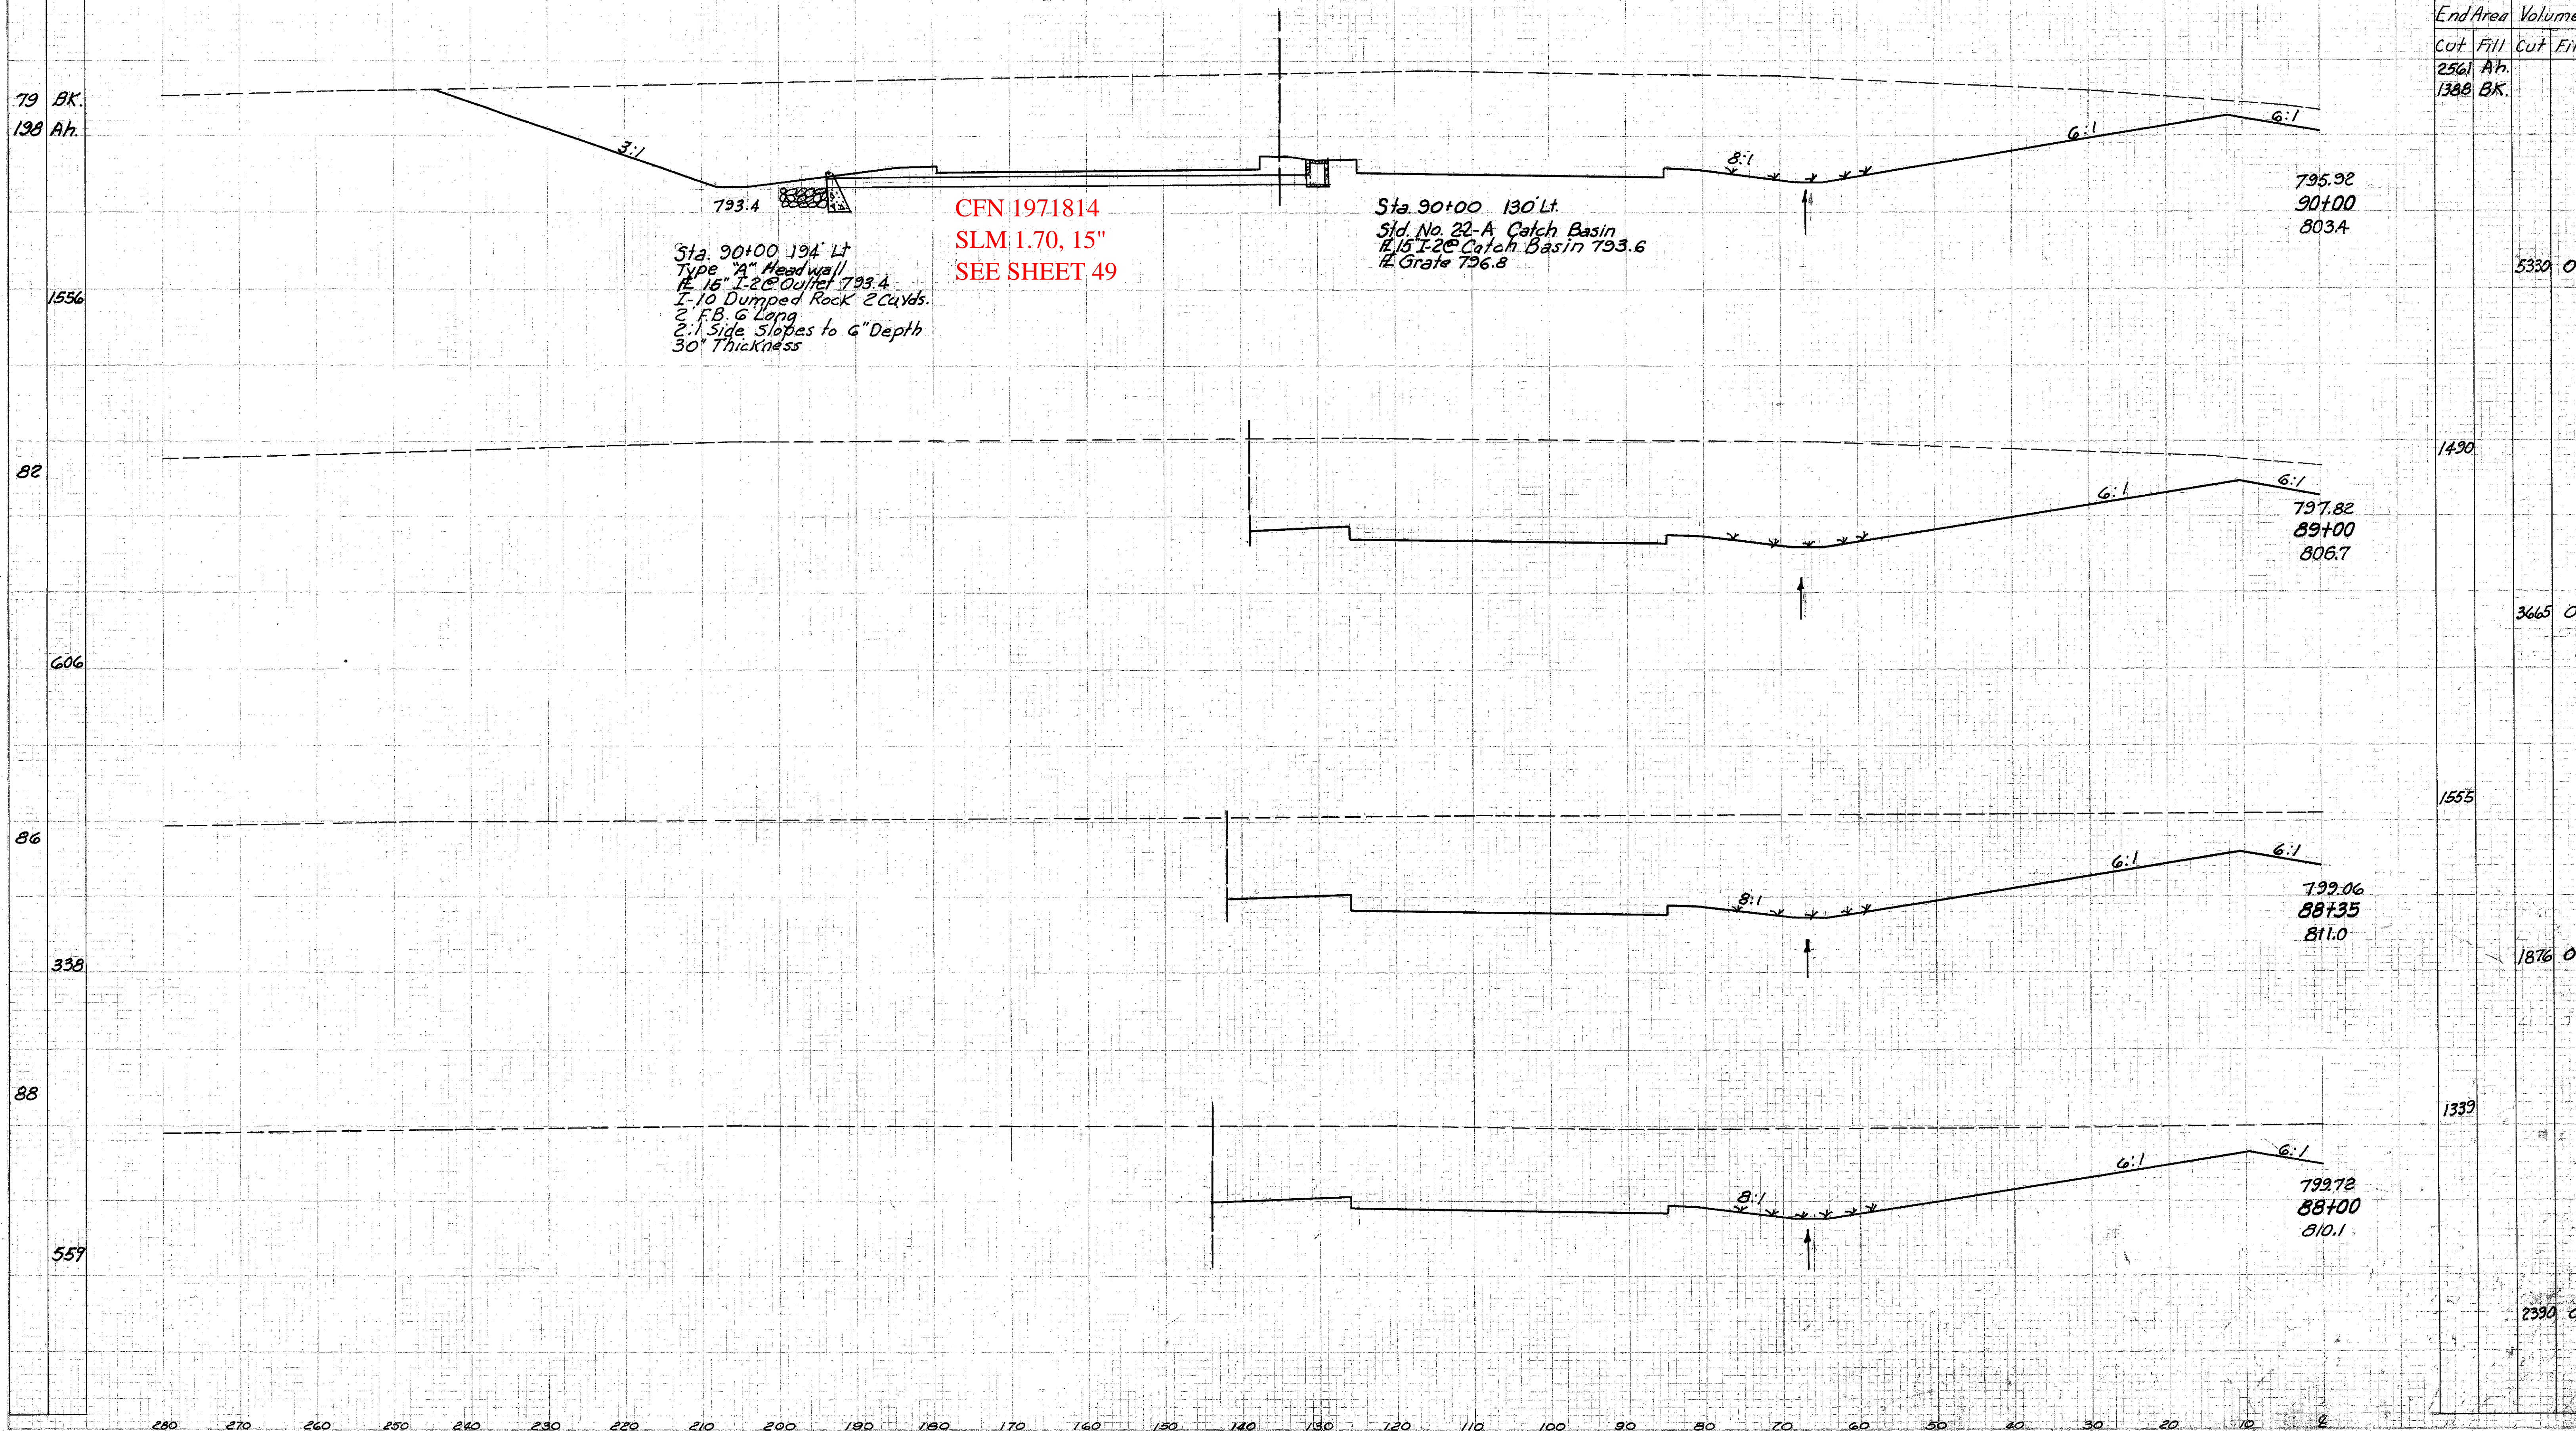

Sta. 90+00 194 Lt
Type "A" Headwall
1.10 Dumped Rock 2 Cuyds.
2' F.B. 6' Long
2:1 Side Slopes to 6" Depth
30" Thickness

CFN 1971814
SLM 1.70, 15"
SEE SHEET 49

Sta. 90+00 130 Lt.
Std. No. 22-A Catch Basin
1/2" Grate 796.8

End Area		Volume	
Cut	Fill	Cut	Fill

Sta. 88+00 to Sta. 90+00 Lt. & Ft.