


Seeding  
End  
Width SqYd.

CUYAHOGA & LAKE COUNTIES  
CUY-I-15.91  
LAK-I-0.00

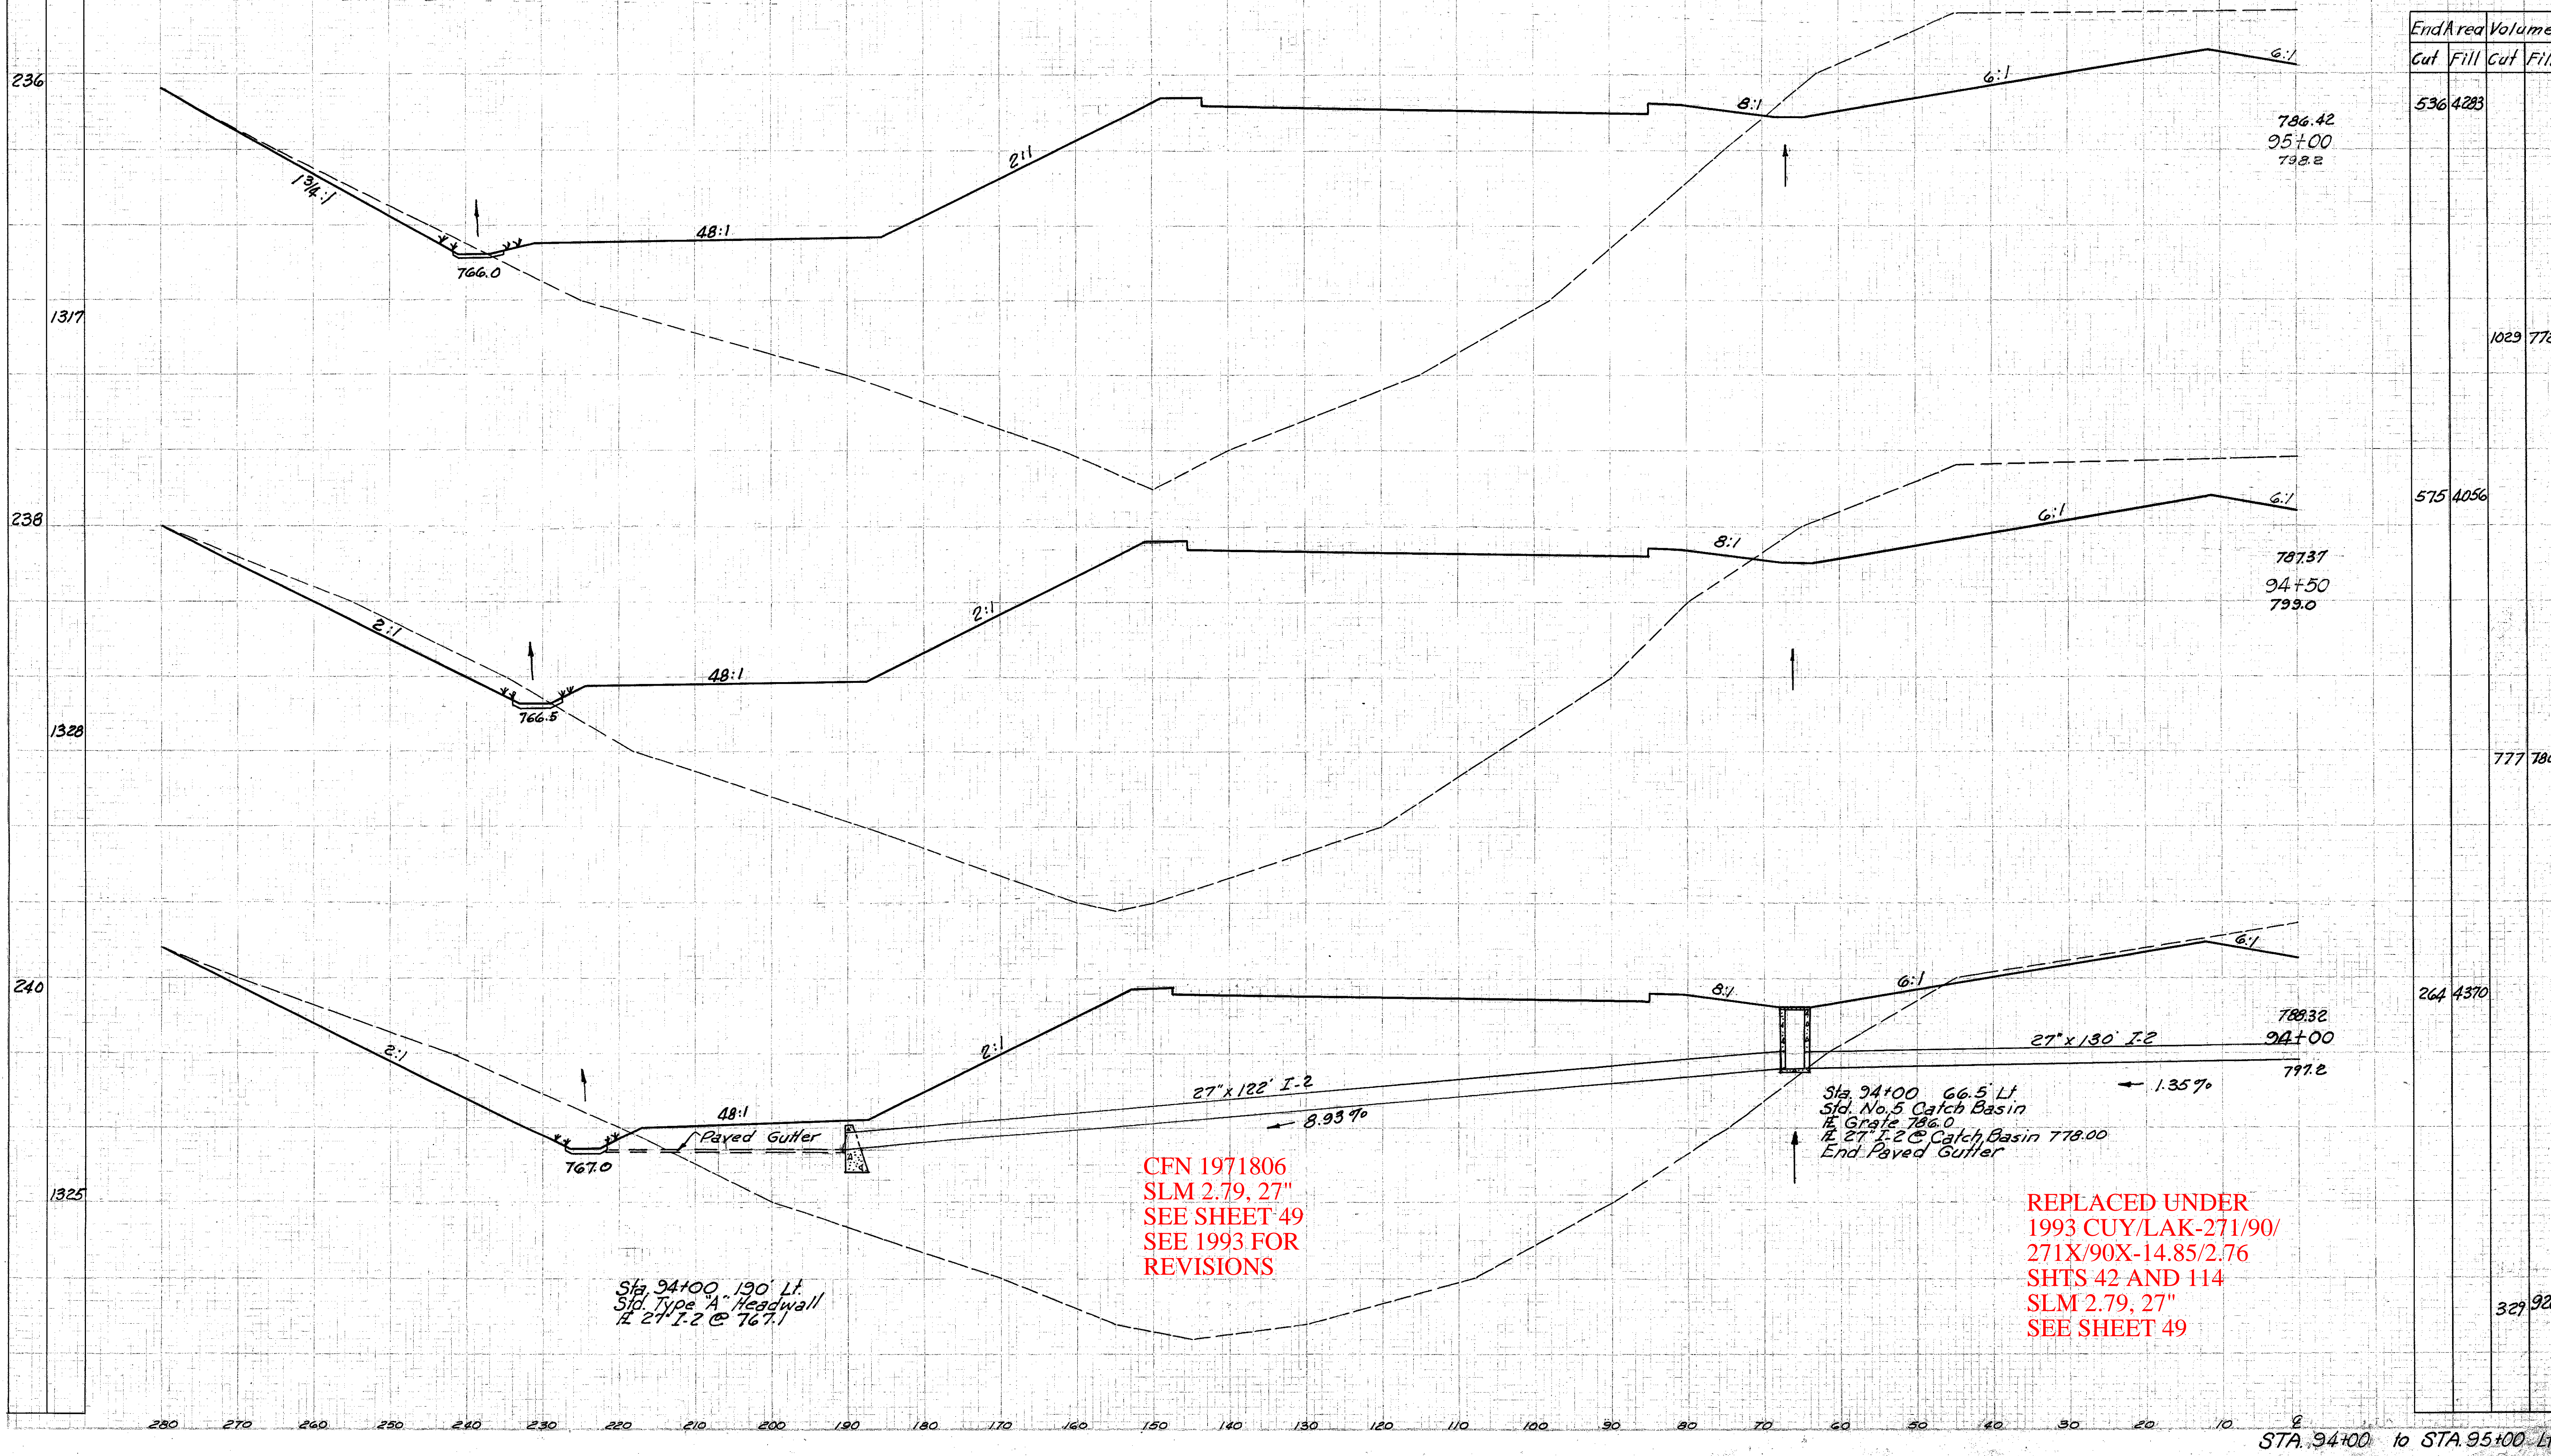

End Area		Volume	
Cut	Fill	Cut	Fill
536.4	283		
575	4056		
264	4370		
		329	926

CFN 1971806  
SLM 2.79, 27"  
SEE SHEET 49  
SEE 1993 FOR  
REVISIONS

REPLACED UNDER  
1993 CUY/LAK-271/90/  
271X/90X-14.85/2.76  
SHTS 42 AND 114  
SLM 2.79, 27"  
SEE SHEET 49

Sta 94+00 190 Lt.  
Std. Type A Headwall  
R 27' I-2 @ 767.1

Sta 94+00 66.5 Lt.  
Std. No. 5 Catch Basin  
R Grate 766.0  
R 27' I-2 @ Catch Basin 778.00  
End Paved Gutter

STA. 94+00 to STA. 95+00 LK