
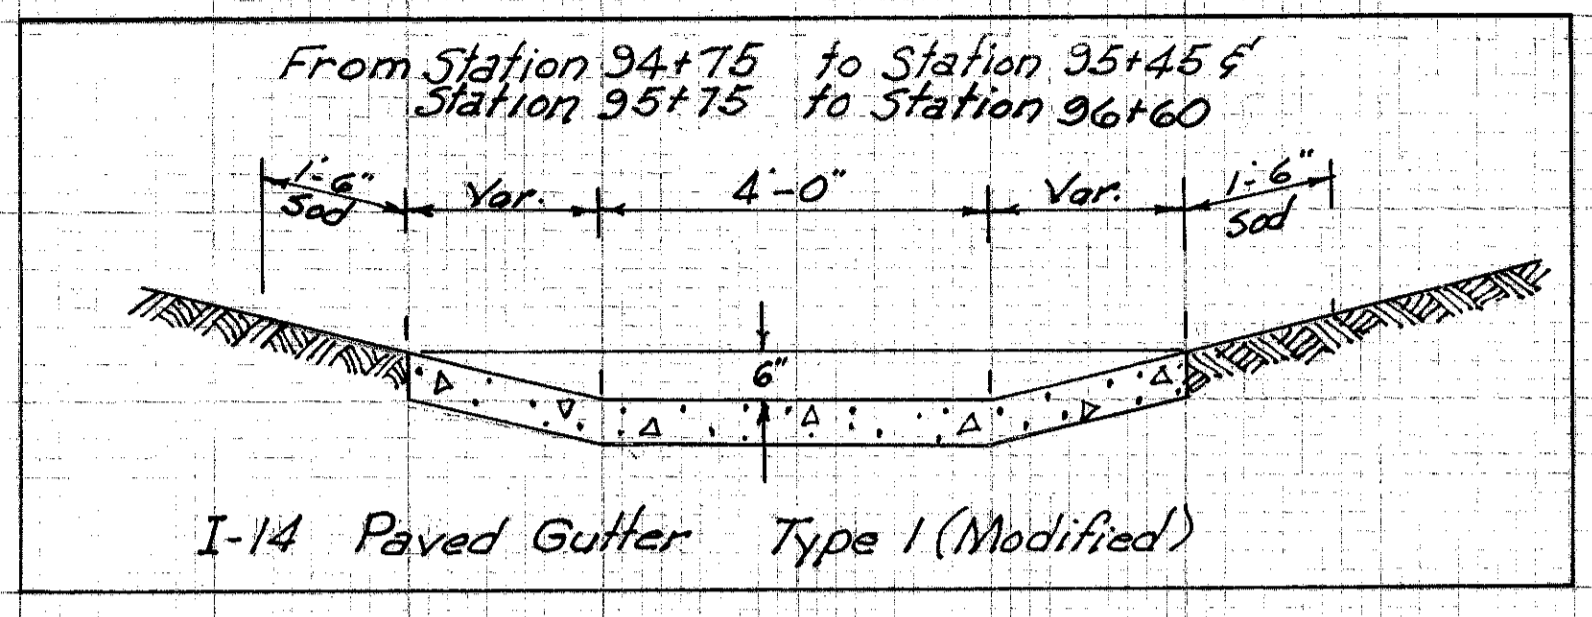


Seeding
End Width Sq. Yd.

CUYAHOGA & LAKE COUNTIES
CUY-I-15.91
LAK-I-0.00

End Area	Volume
Cut	Fill

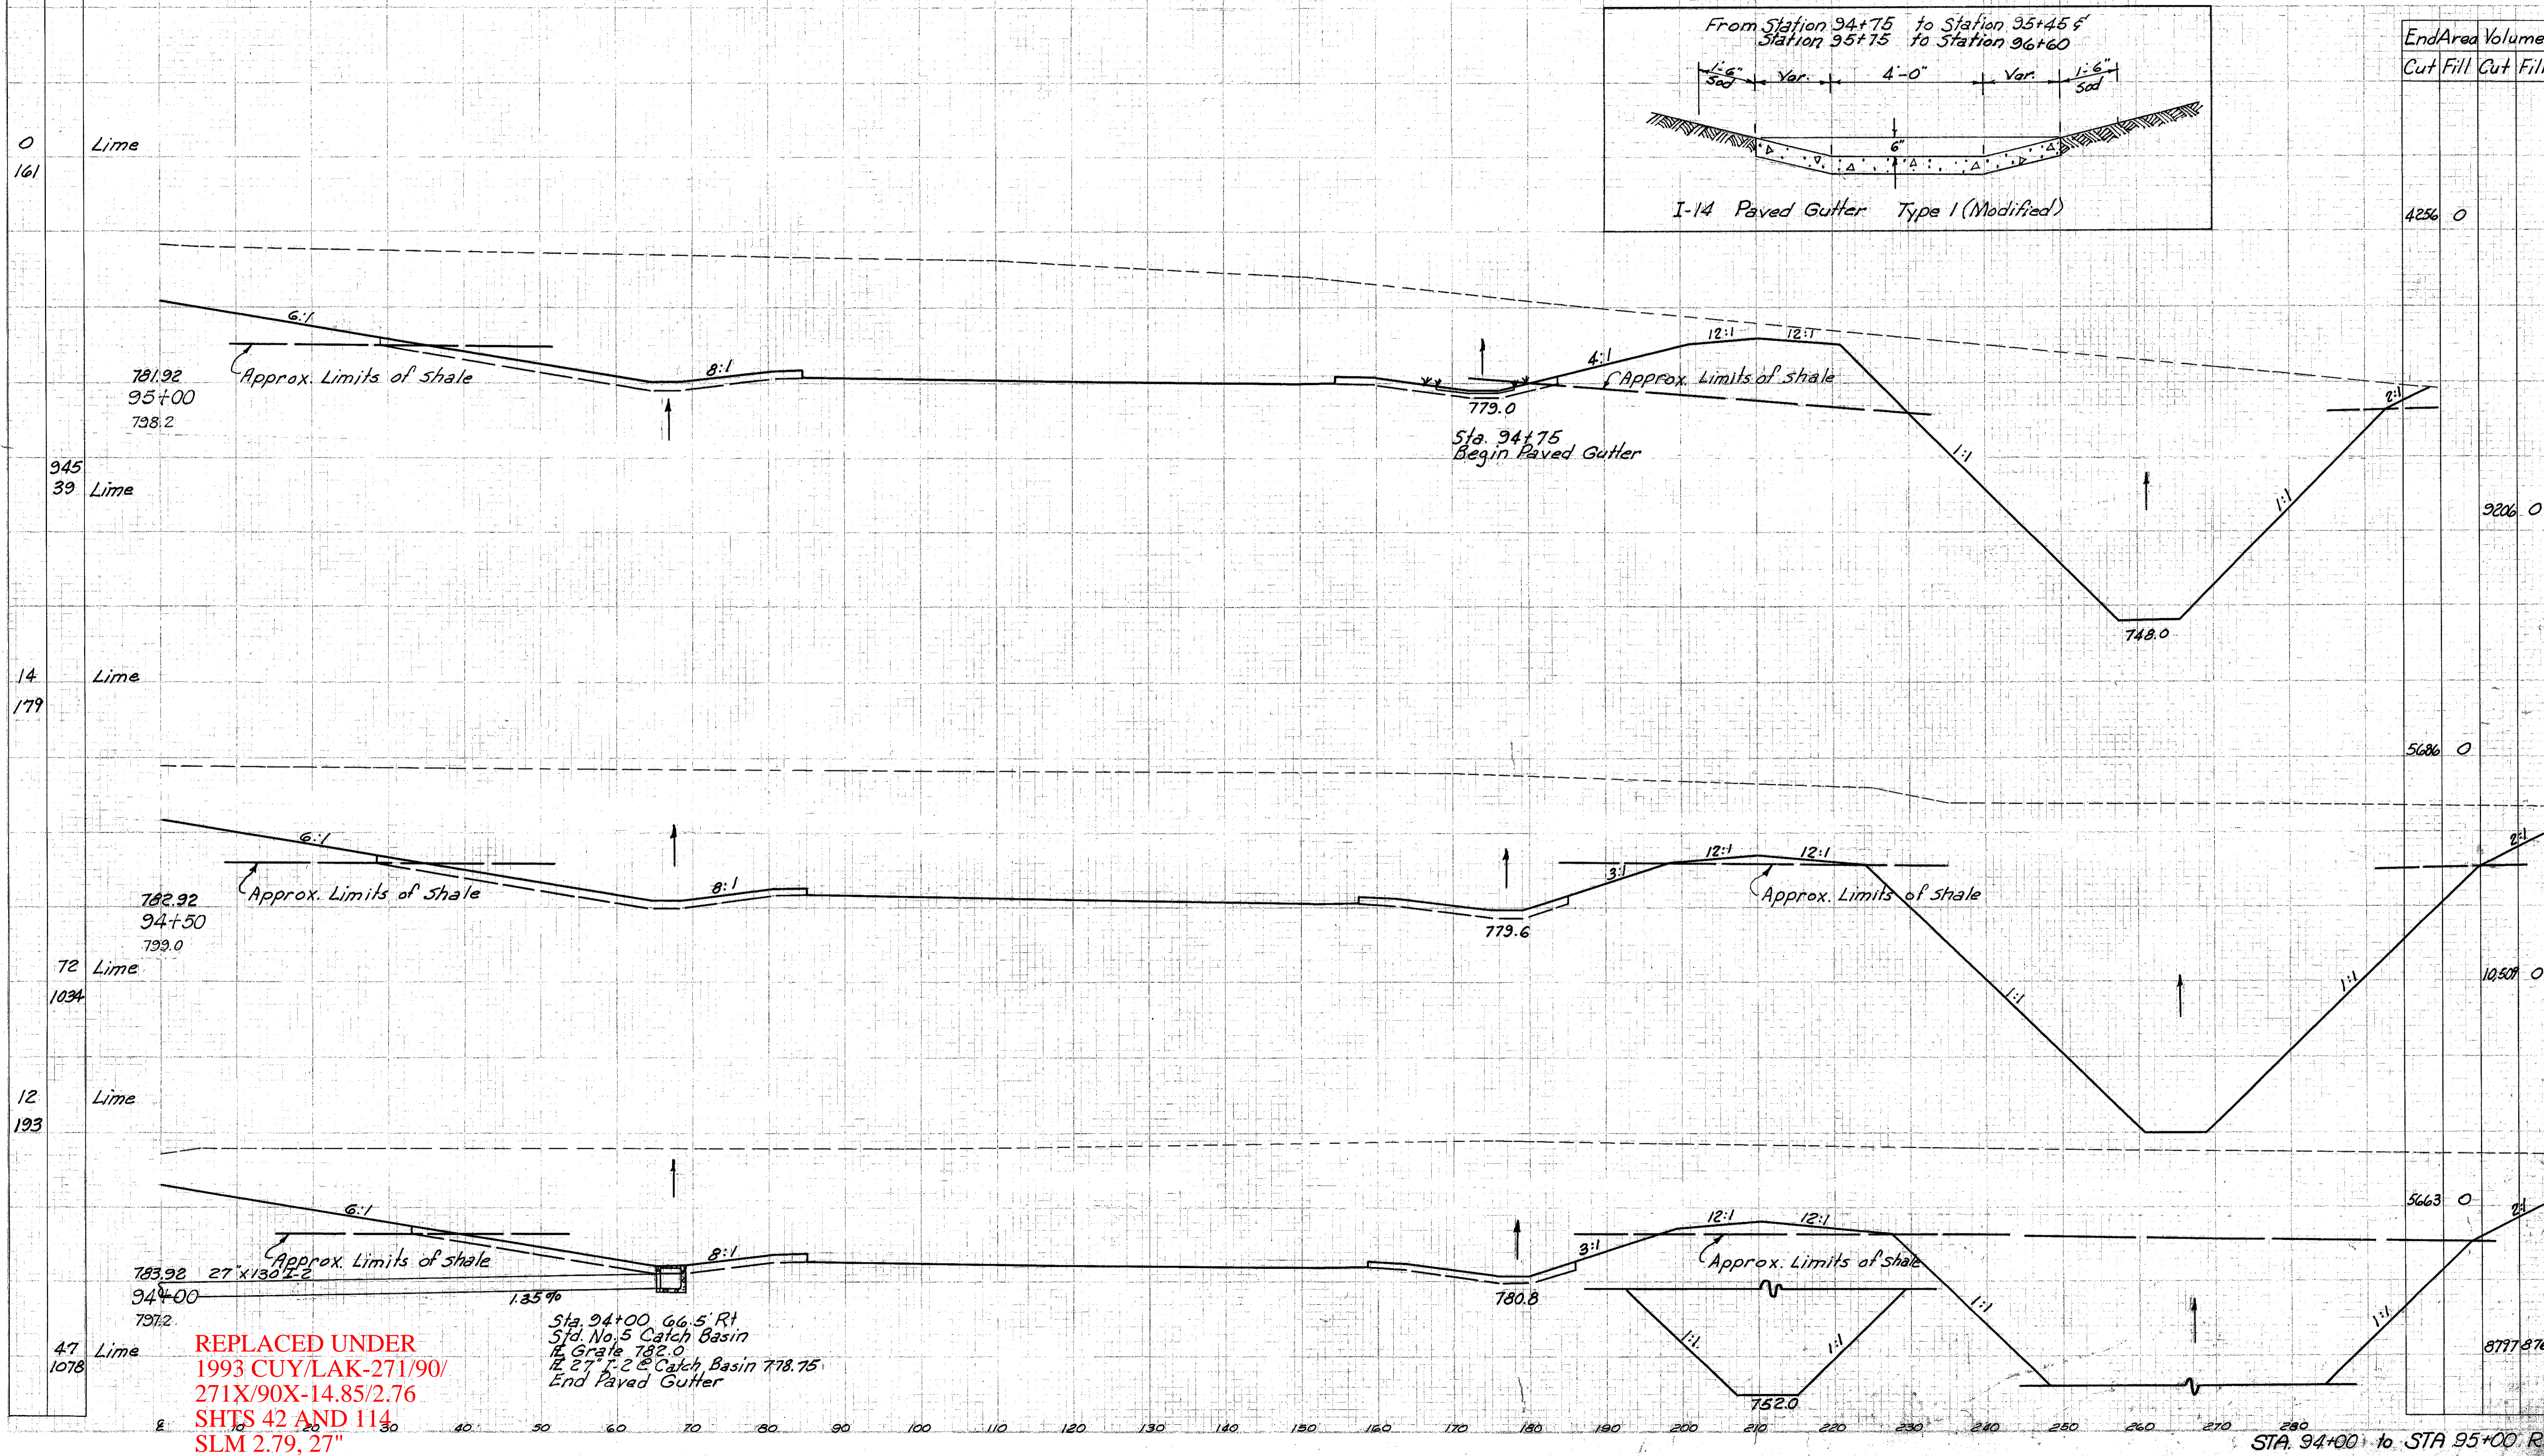

4256	0
------	---

9206	0
------	---

5686	0
------	---

10507	0
-------	---

5663	0
------	---

8777	8766
------	------

**REPLACED UNDER
1993 CUY/LAK-271/90/
271X/90X-14.85/2.76
SHTS 42 AND 114
SLM 2.79, 27"
SEE SHEET 49**

Sta. 94+00 66.5' Rt
Std. No. 5 Catch Basin
12 Grate 782.0
12 27" x 27" Catch Basin 778.75
End Paved Gutter

STA. 94+00 to STA 95+00 RT