


Seeding  
End Width Sq. Yd.

FED. RD. DISTRICT	STATE	PROJECT
2	OHIO	I-1103(18)

297  
458

CUYAHOGA & LAKE COUNTIES  
CUI-1-15.91  
LAK-1-0.00

End Area Volume  
Cut Fill Cut Fill

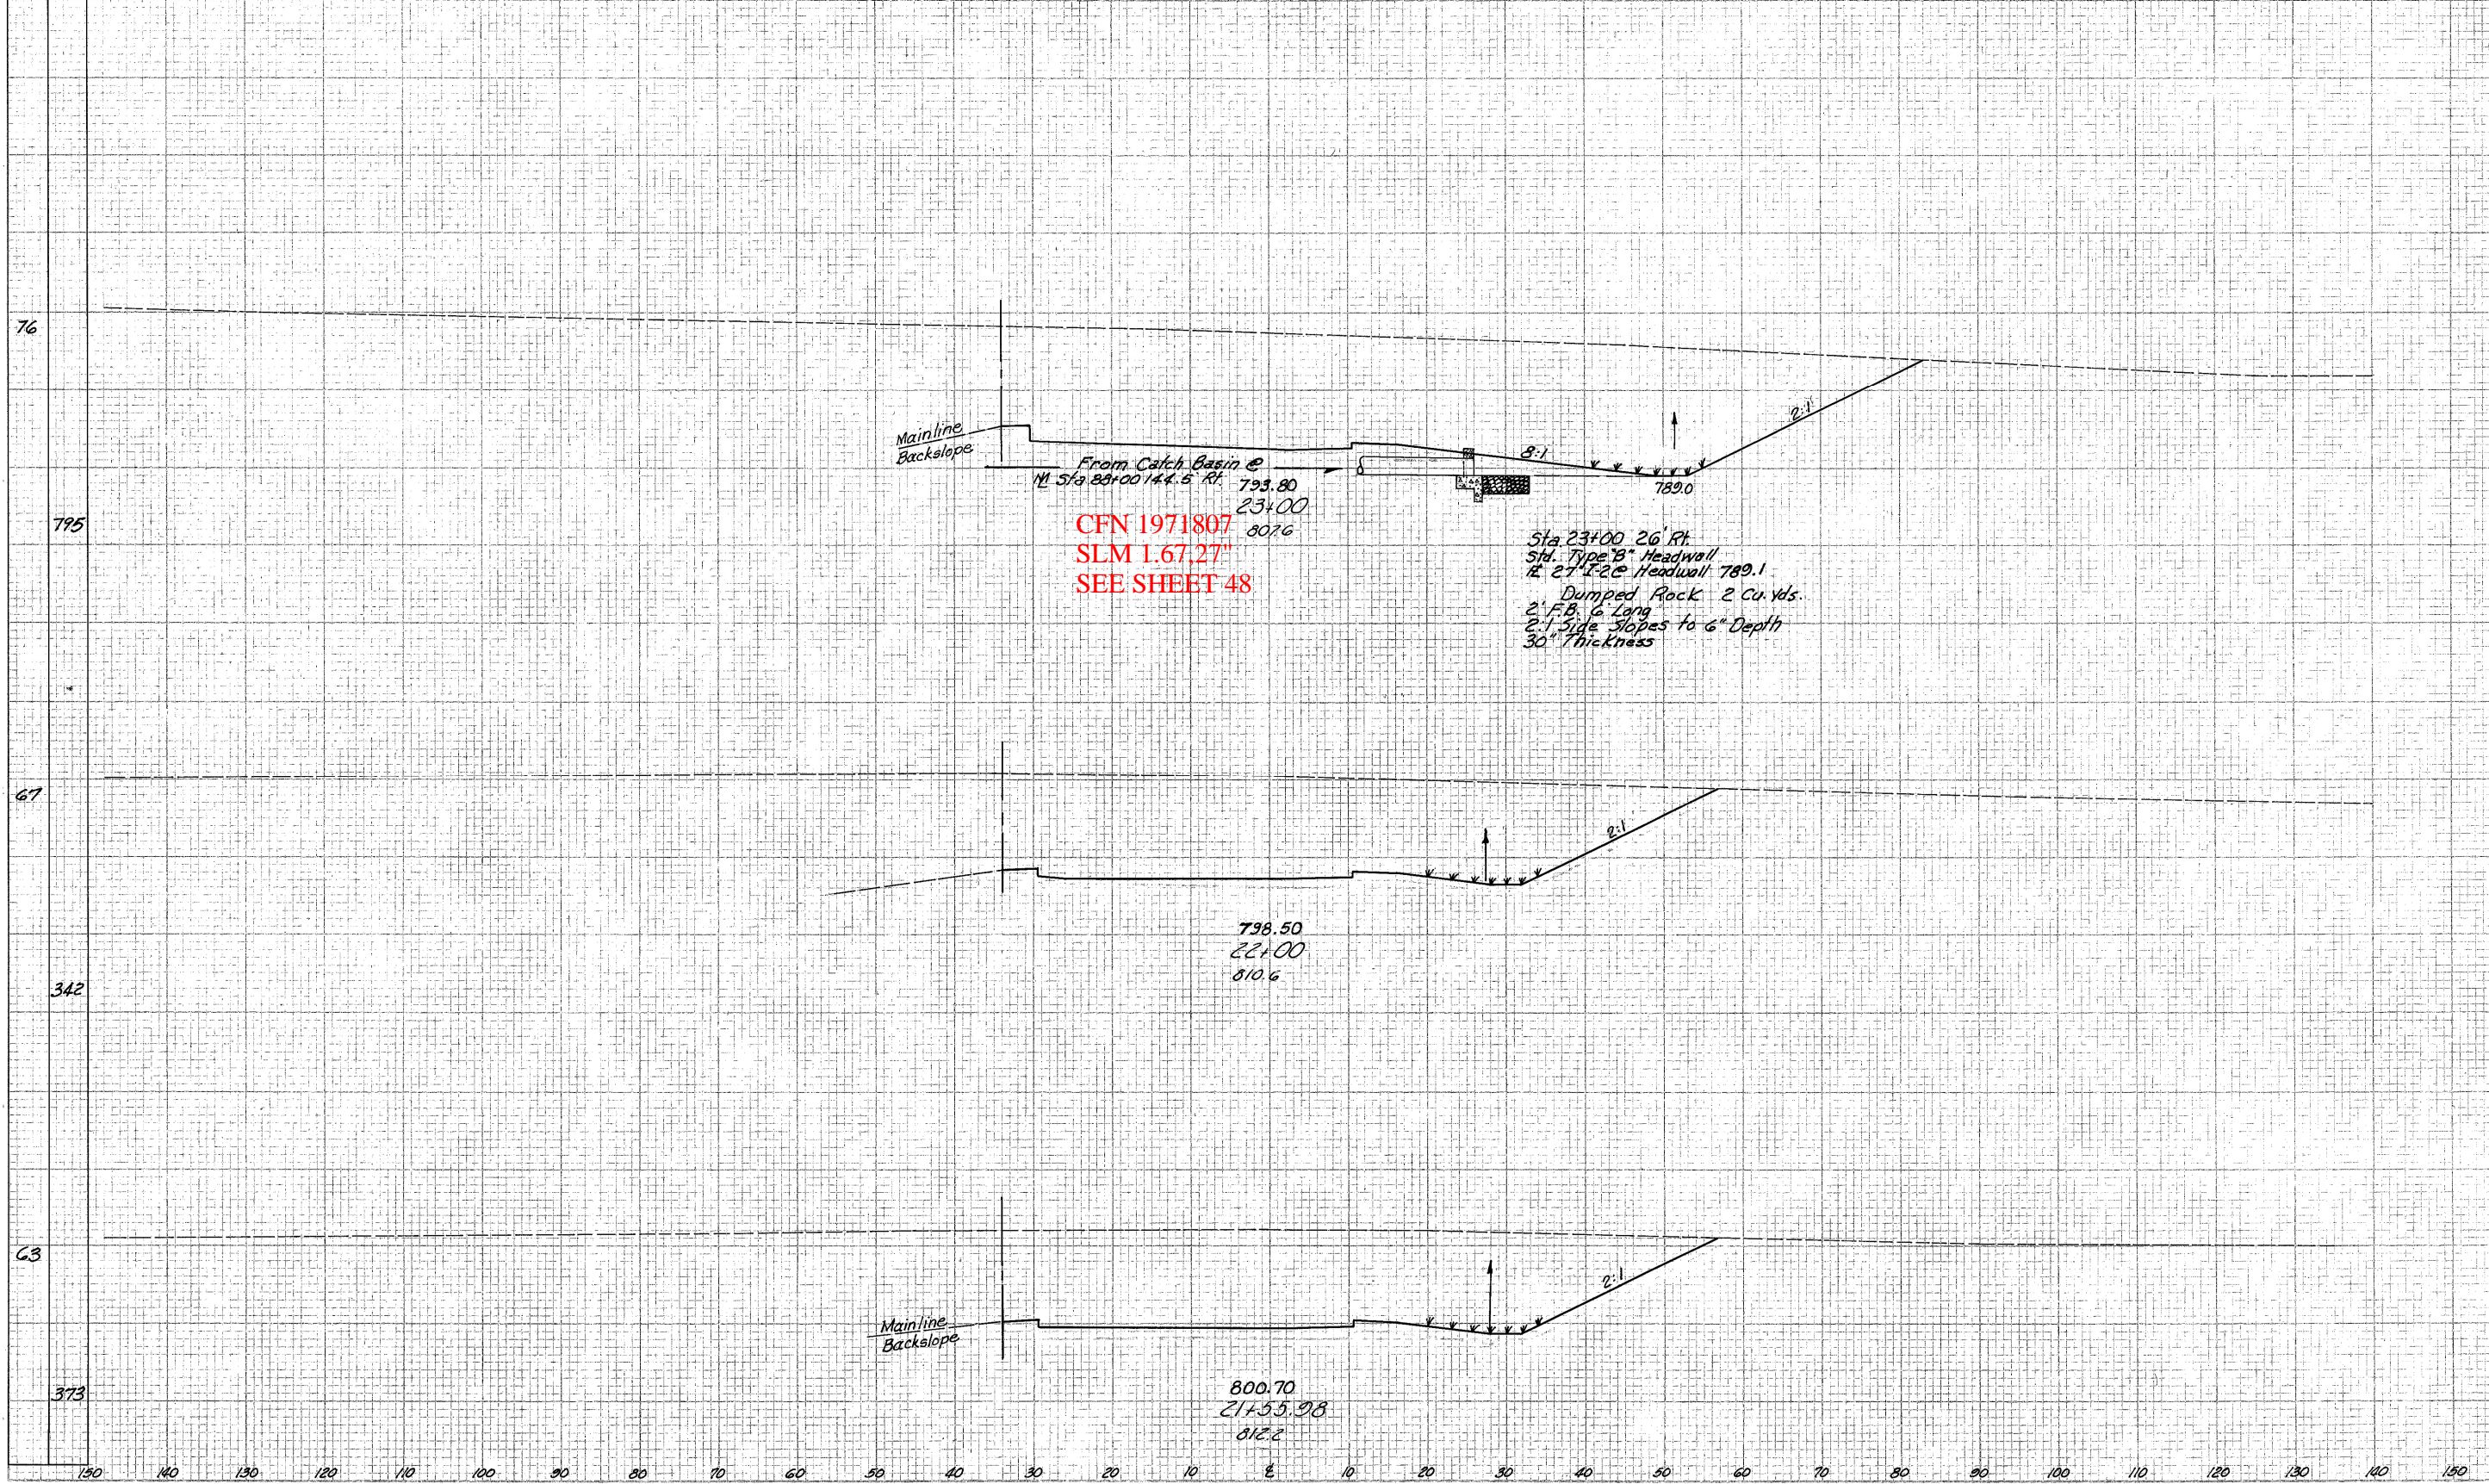

1546

4774

1032

1632

970

1901

EUCLID SPUR INTERCHANGE - Ramp "B" Sta. 21+55.98 To Sta. 23+00