FED. RD. DIVISION	STATE	PROJECT	
2	OHIO	I-1103 (18)	

48 / 458

CUYAHOGA & LAKE COUNTIES
CUY-I-15.91
LAK-I-0.00

CFN 1971813
SLM 1.66, 27"
SEE BELOW
AND 313

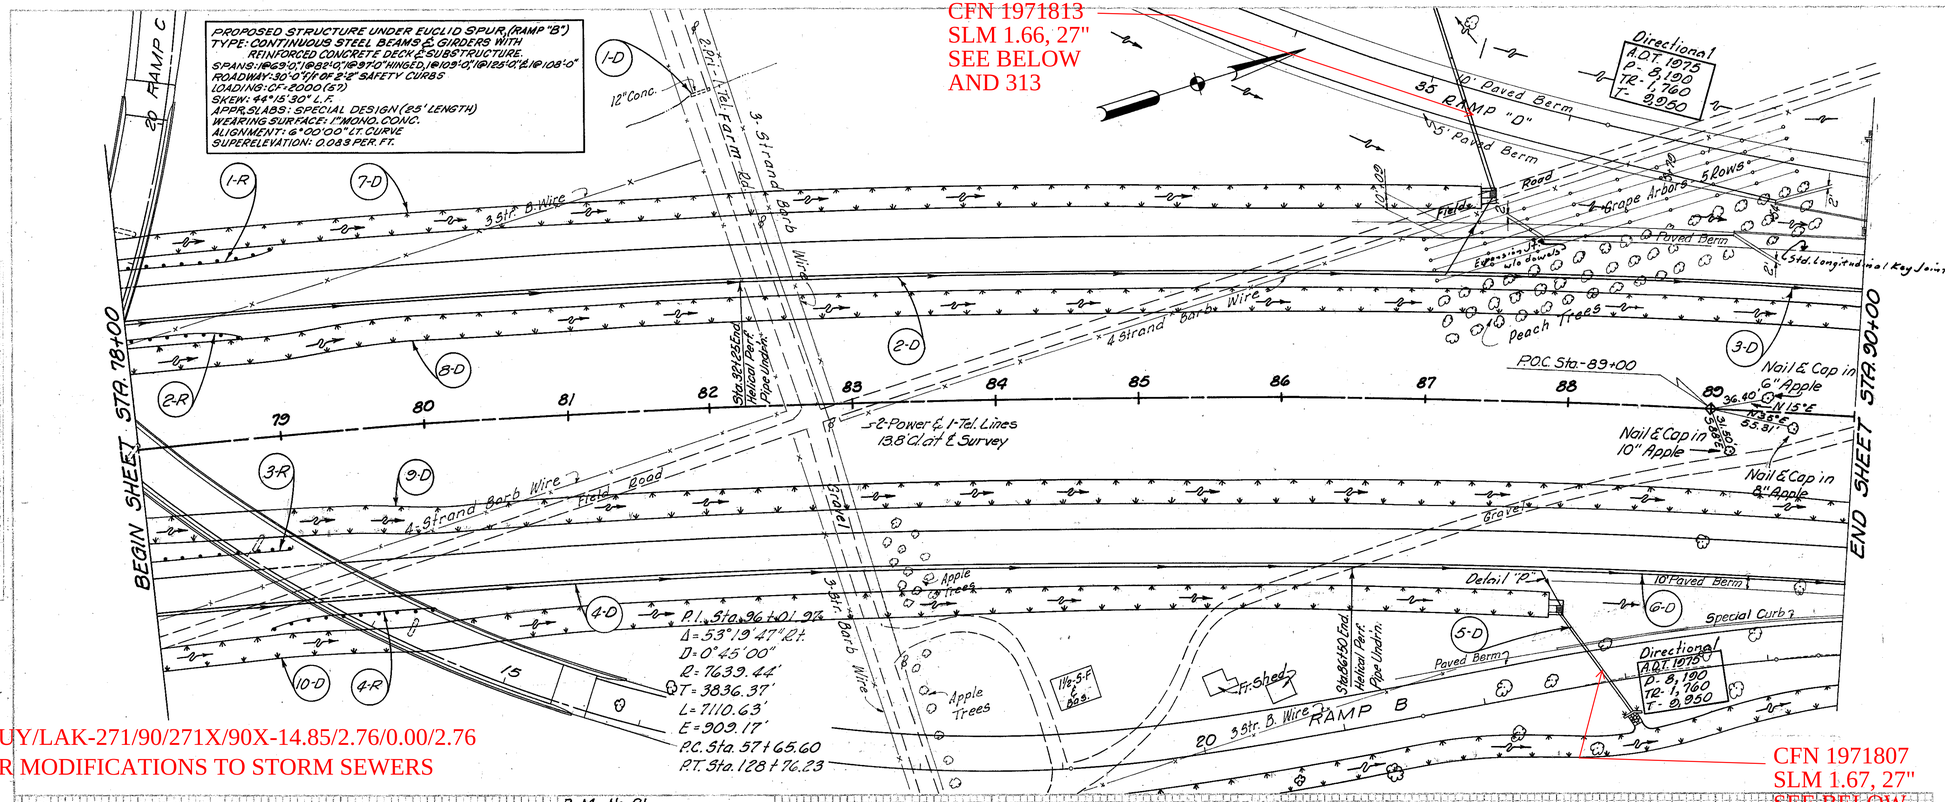

CFN 1971807
SLM 1.67, 27"
SEE BELOW
SHT 292 AND 297

SEE 1993 CUY/LAK-271/90/271X/90X-14.85/2.76/0.00/2.76
PLANS FOR MODIFICATIONS TO STORM SEWERS

B.M. No. 21
Spike in root twin Wild Cherry
3' Rt. ℄ Sta. 81+17
Elev. 820.608

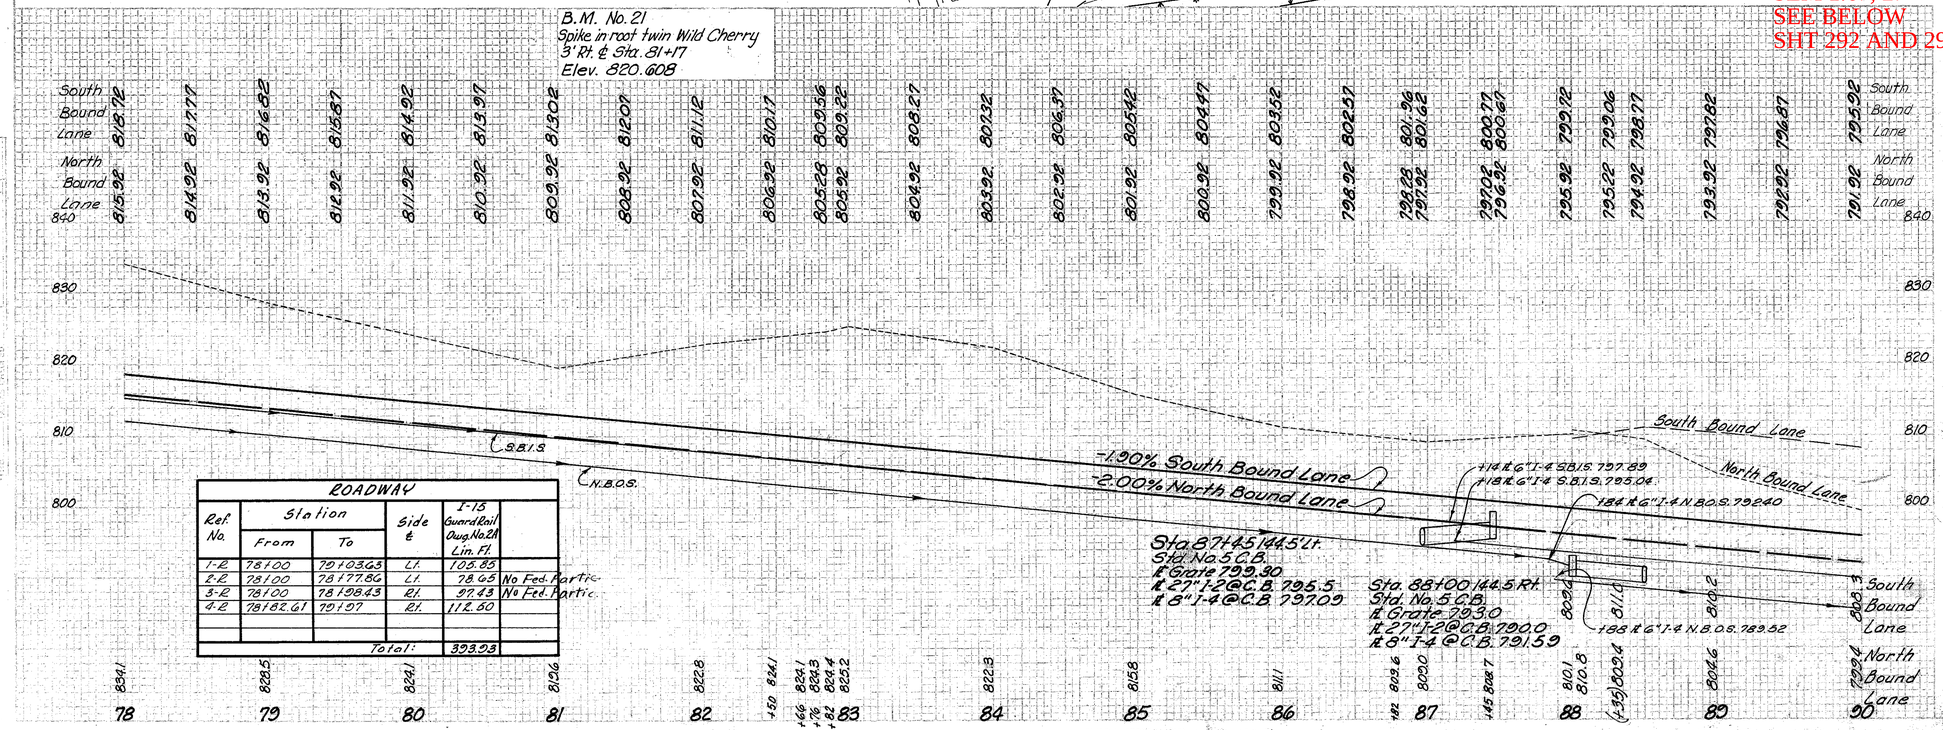

ROADWAY					
Ref. No.	Station From	Station To	Side ℄	I-15 Guard Rail Aug. No. 2A Lin. Ft.	
1-R	78+00	79+03.65	Lt.	105.85	
2-R	78+00	78+77.86	Lt.	78.65	No Fed. Partic.
3-R	78+00	78+98.43	Rt.	97.43	No Fed. Partic.
4-R	78+82.61	79+57	Rt.	112.50	
		Total:		393.93	

| DRAINAGE | | | | |