


SEEDING  
END BR  
WIDTH YDS

LAKE COUNTY  
LAK-1-6.97

45  
277

END AREA CU. YDS  
GUT R/W GUT R/W

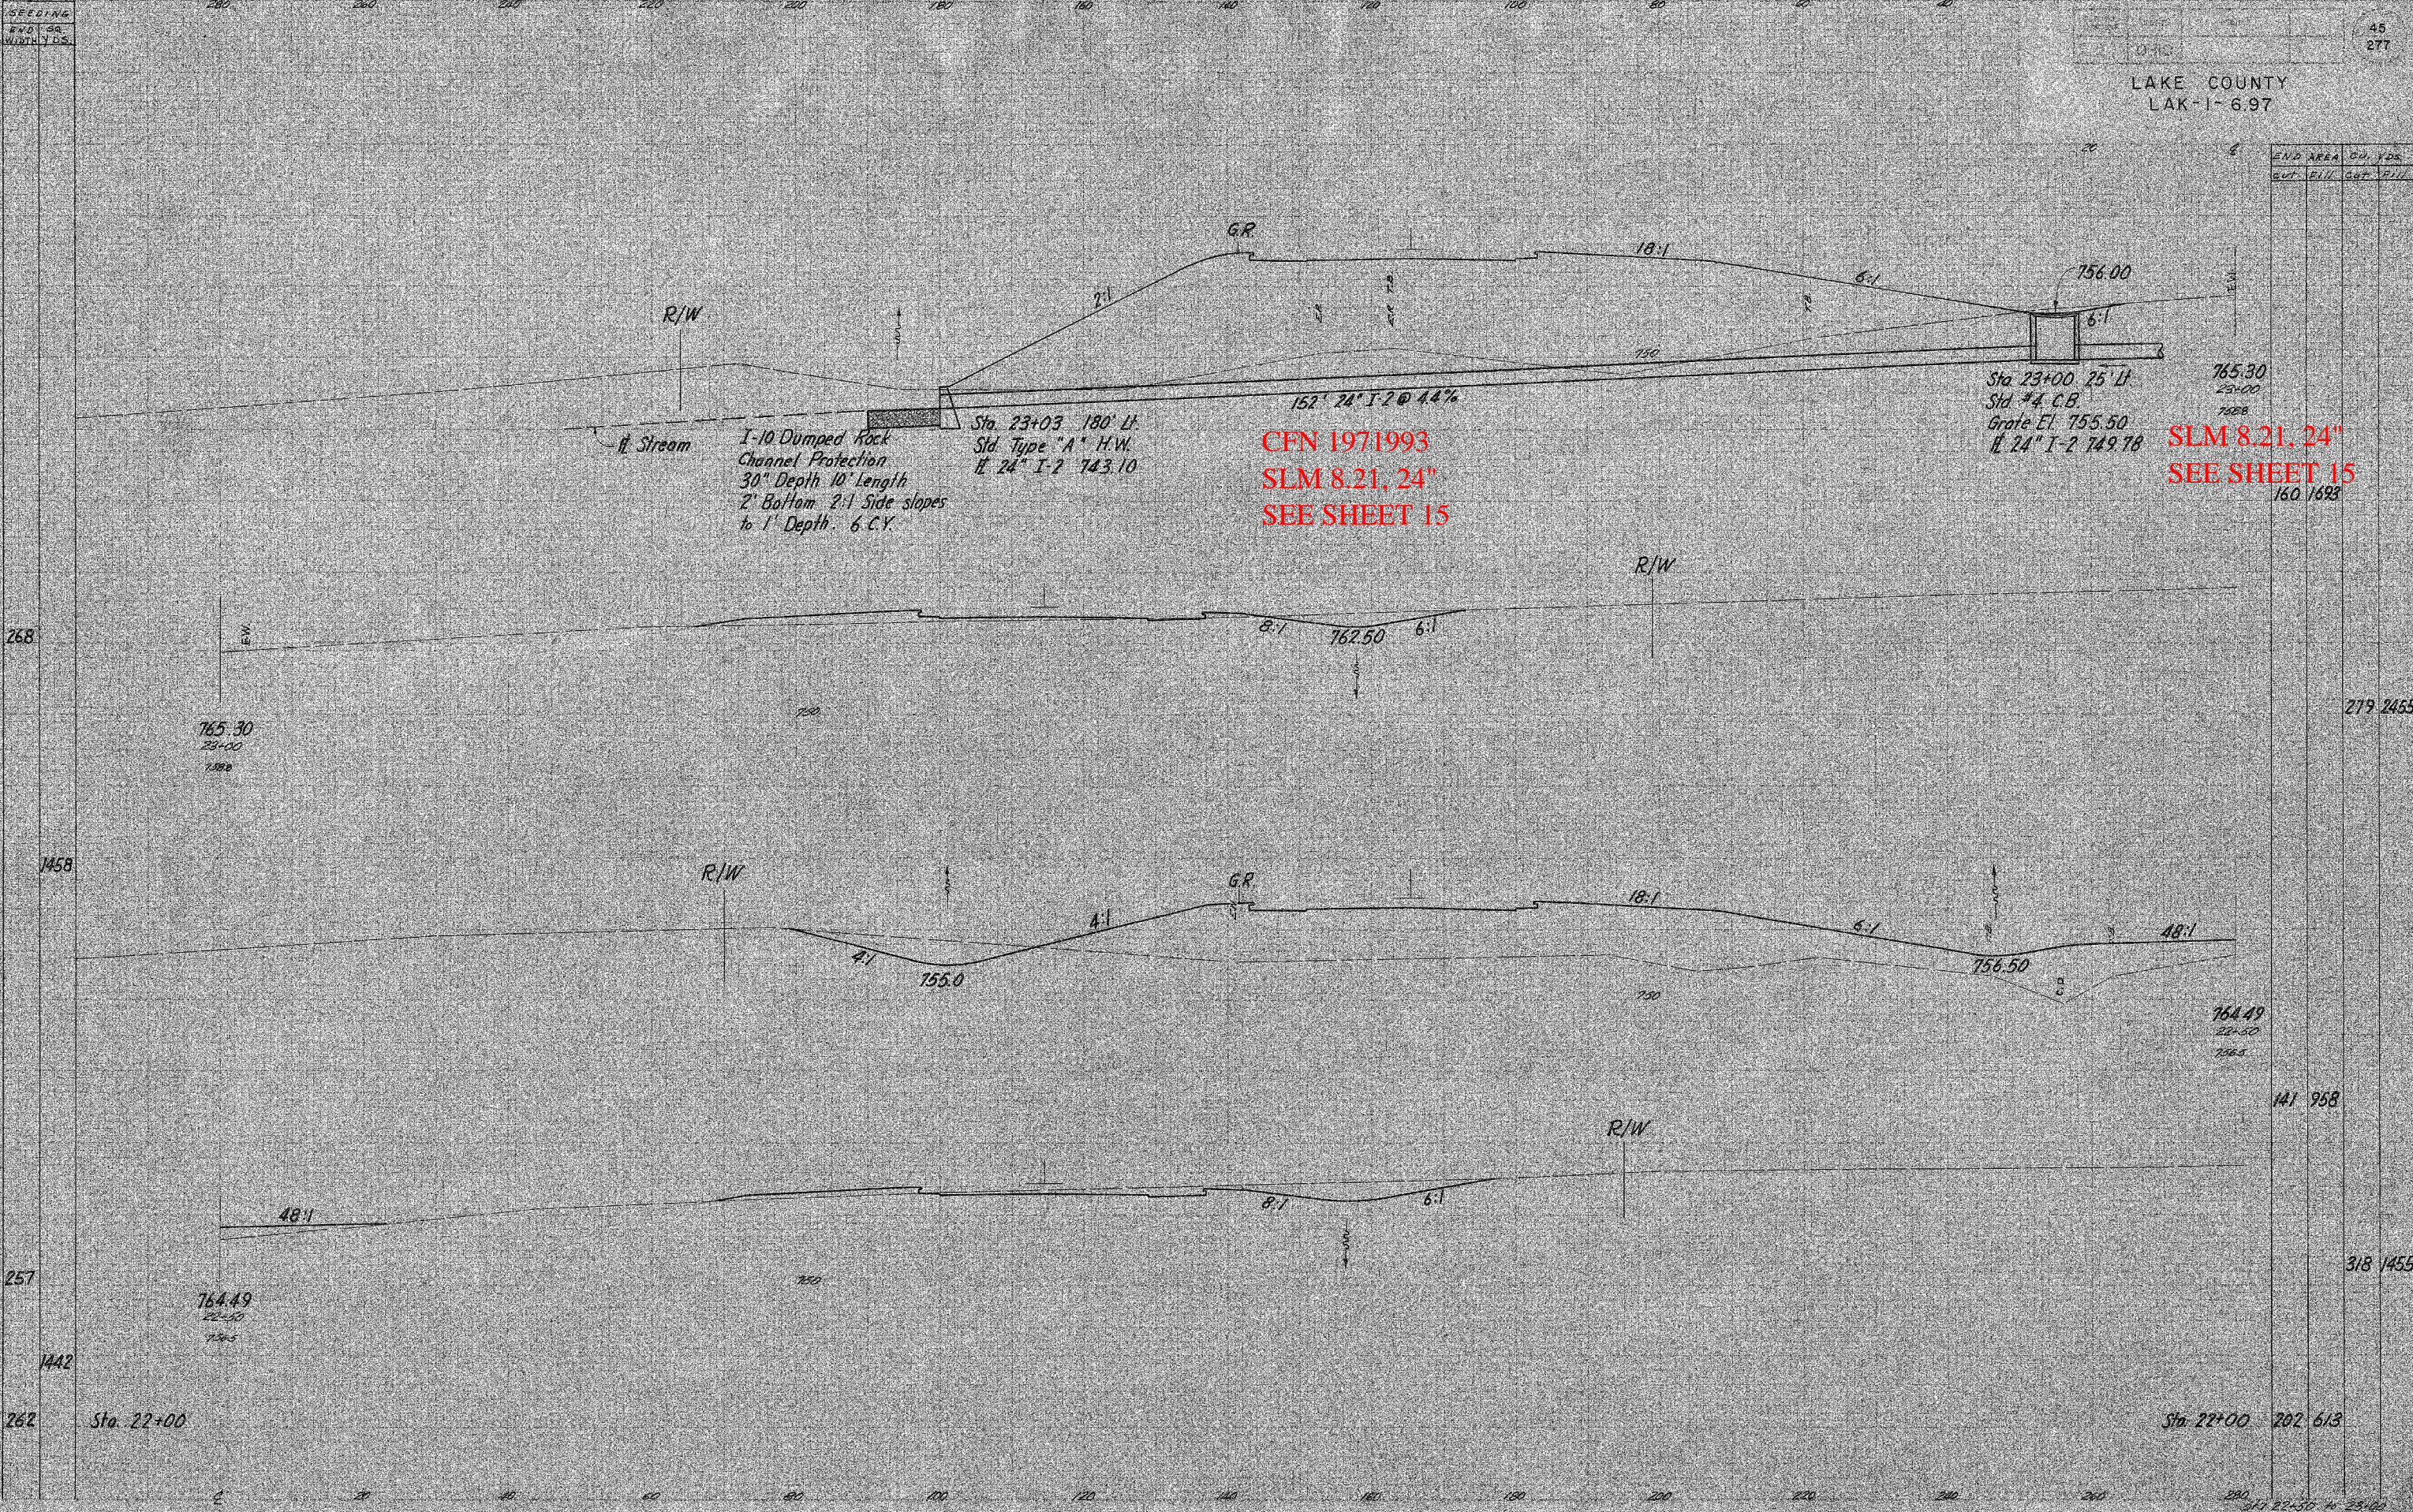

1-10 Dumped Rock  
Channel Protection  
30" Depth 10' Length  
2' Bottom 2:1 Side slopes  
to 1' Depth. 6 C.Y.

Sta. 23+03 180' Lt  
Std. Type "A" H.W.  
# 24" I-2 743.10

CFN 1971993  
SLM 8.21, 24"  
SEE SHEET 15

Sta. 23+00 25' Lt  
Std #4 C.B.  
Grate El. 755.50  
# 24" I-2 749.78

SLM 8.21, 24"  
SEE SHEET 15  
160.1693

279 2465

764.49  
22+50  
766.5

141 958

3/8 1455

Sta. 22+00 202 613

211 22+50 W 23+00