


CUYAHOGA COUNTY
 SEC. CUY-525-0.00, CUY-2-28.16
 LAKE COUNTY
 SEC. LAK.525-0.00

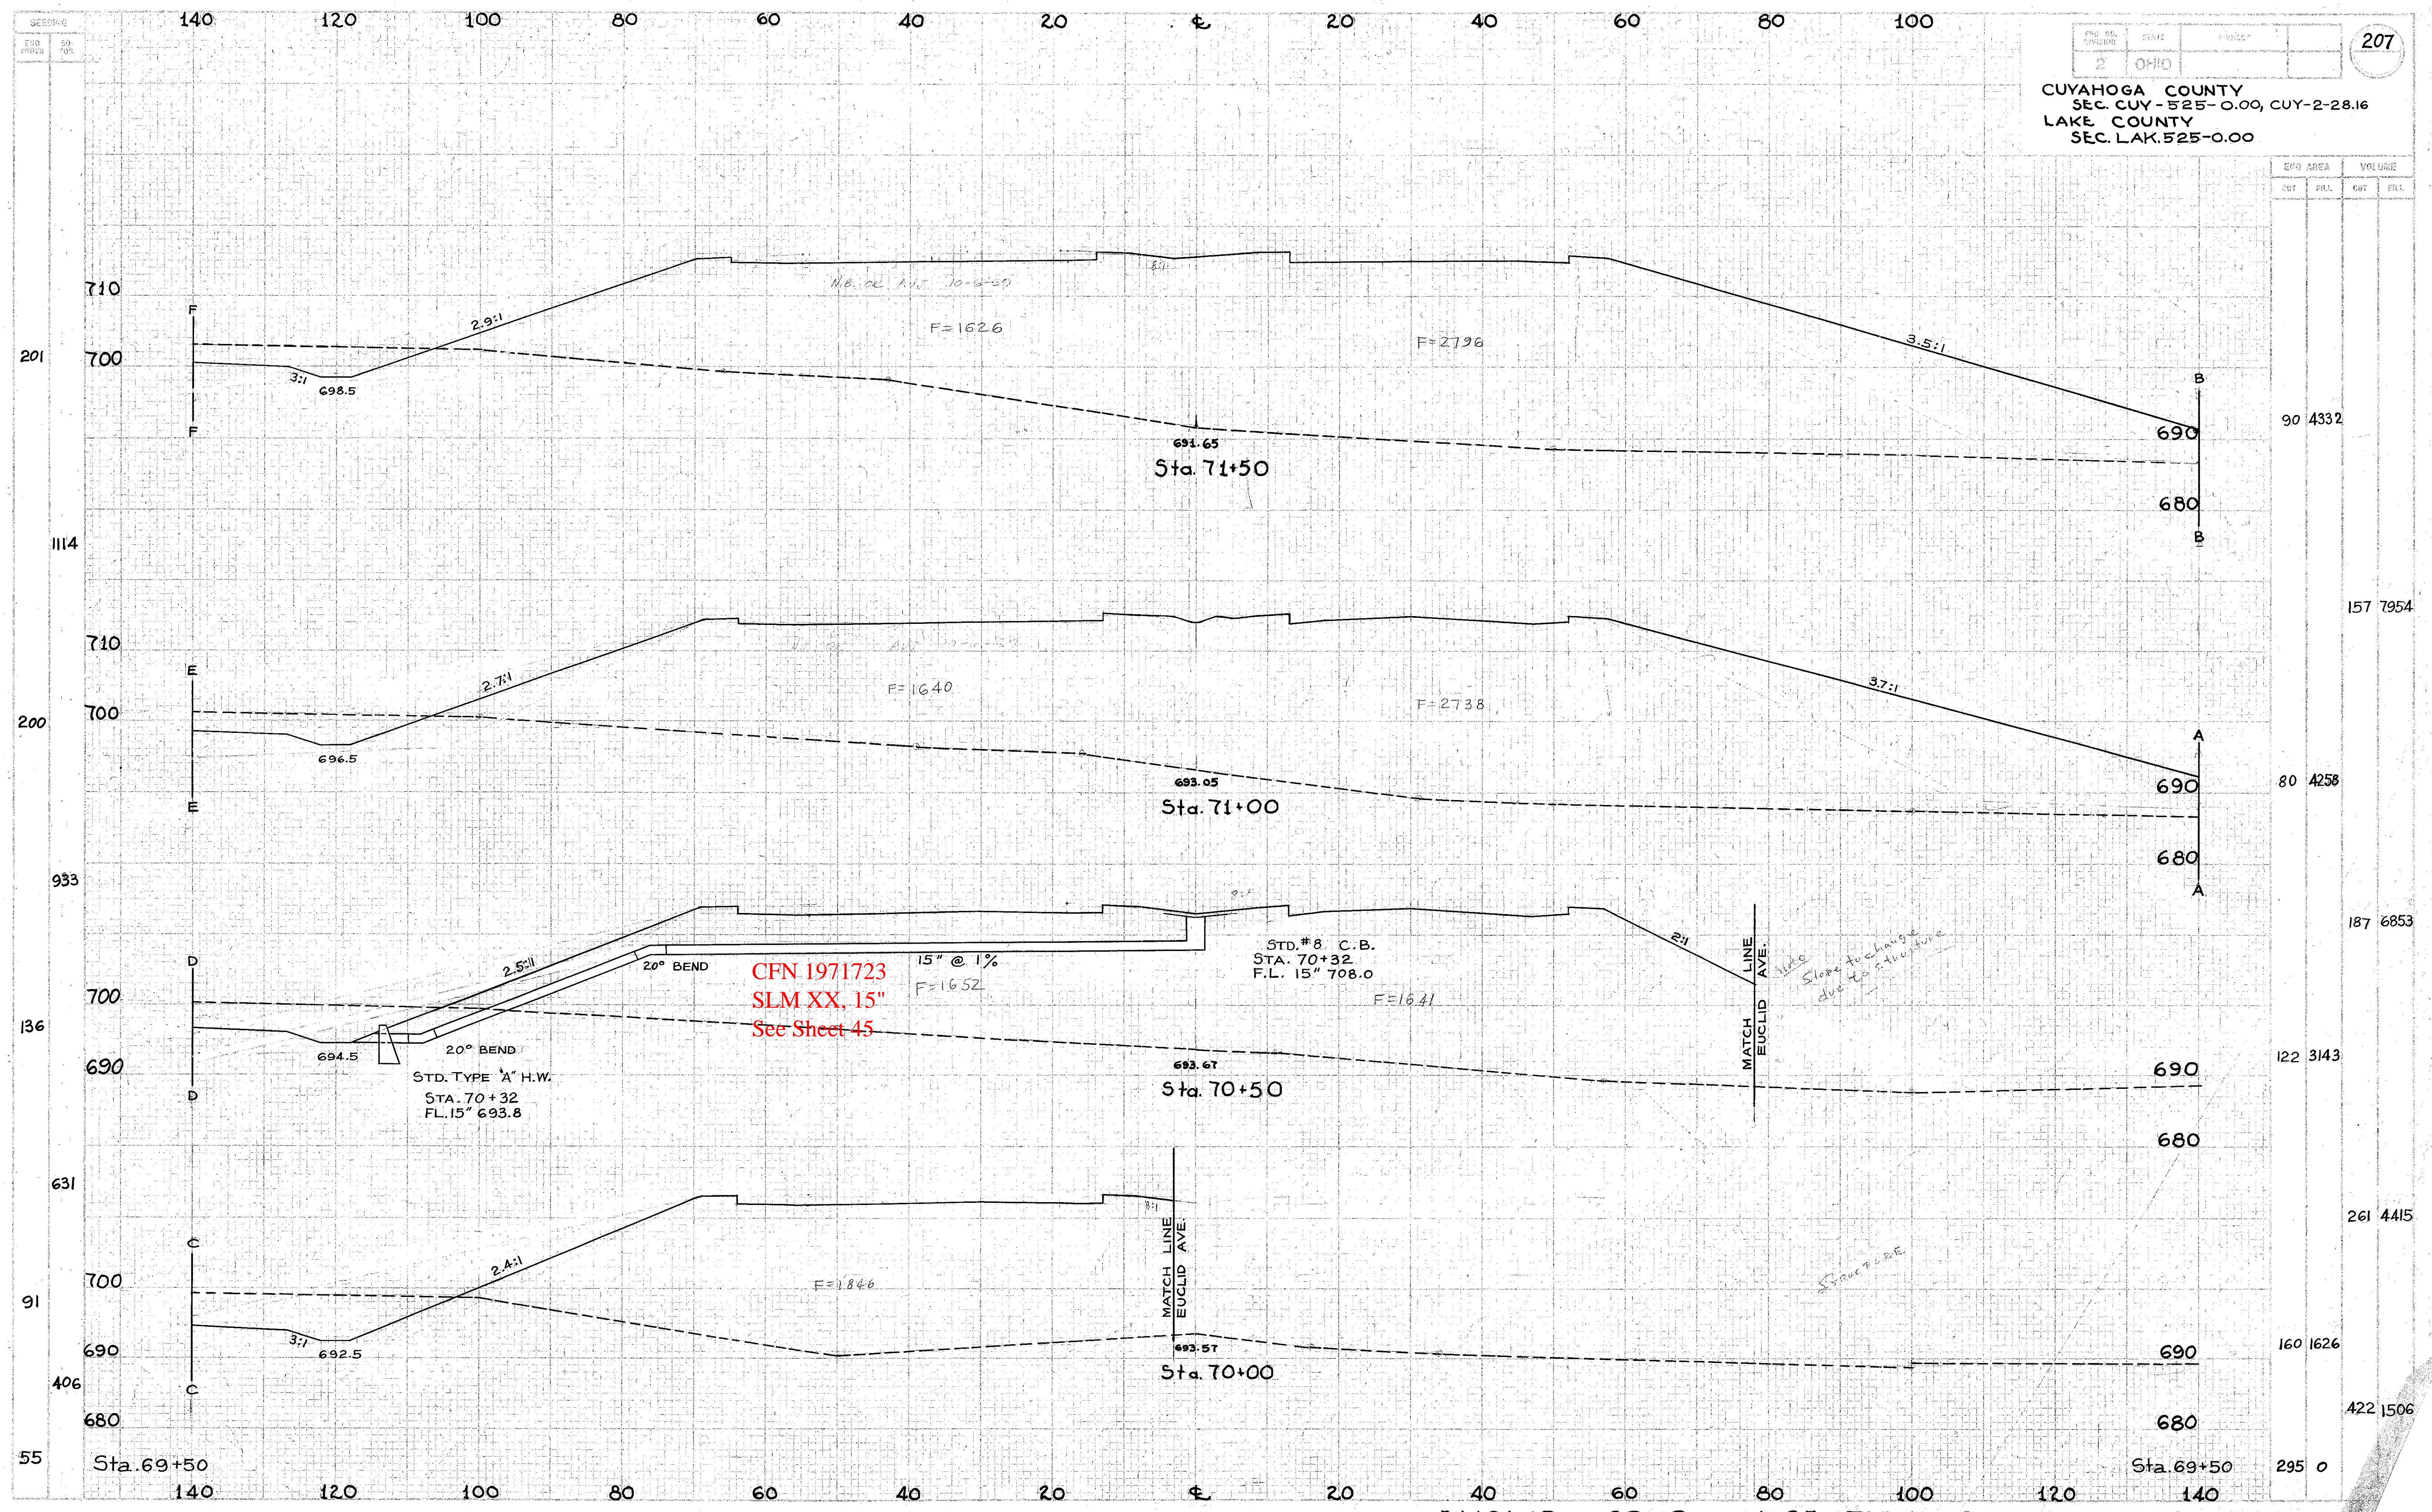

CFN 1971723
 SLM XX, 15"
 See Sheet 45

*Match line
 Slope to change

SPUR P&E

EUCLID SPUR X-SECTIONS STA. 70+00 To STA. 71+50