


CUYAHOGA COUNTY
 SEC. CUY - 525-0.00, CUY-2-28.16
 LAKE COUNTY
 SEC. LAK - 525-0.00

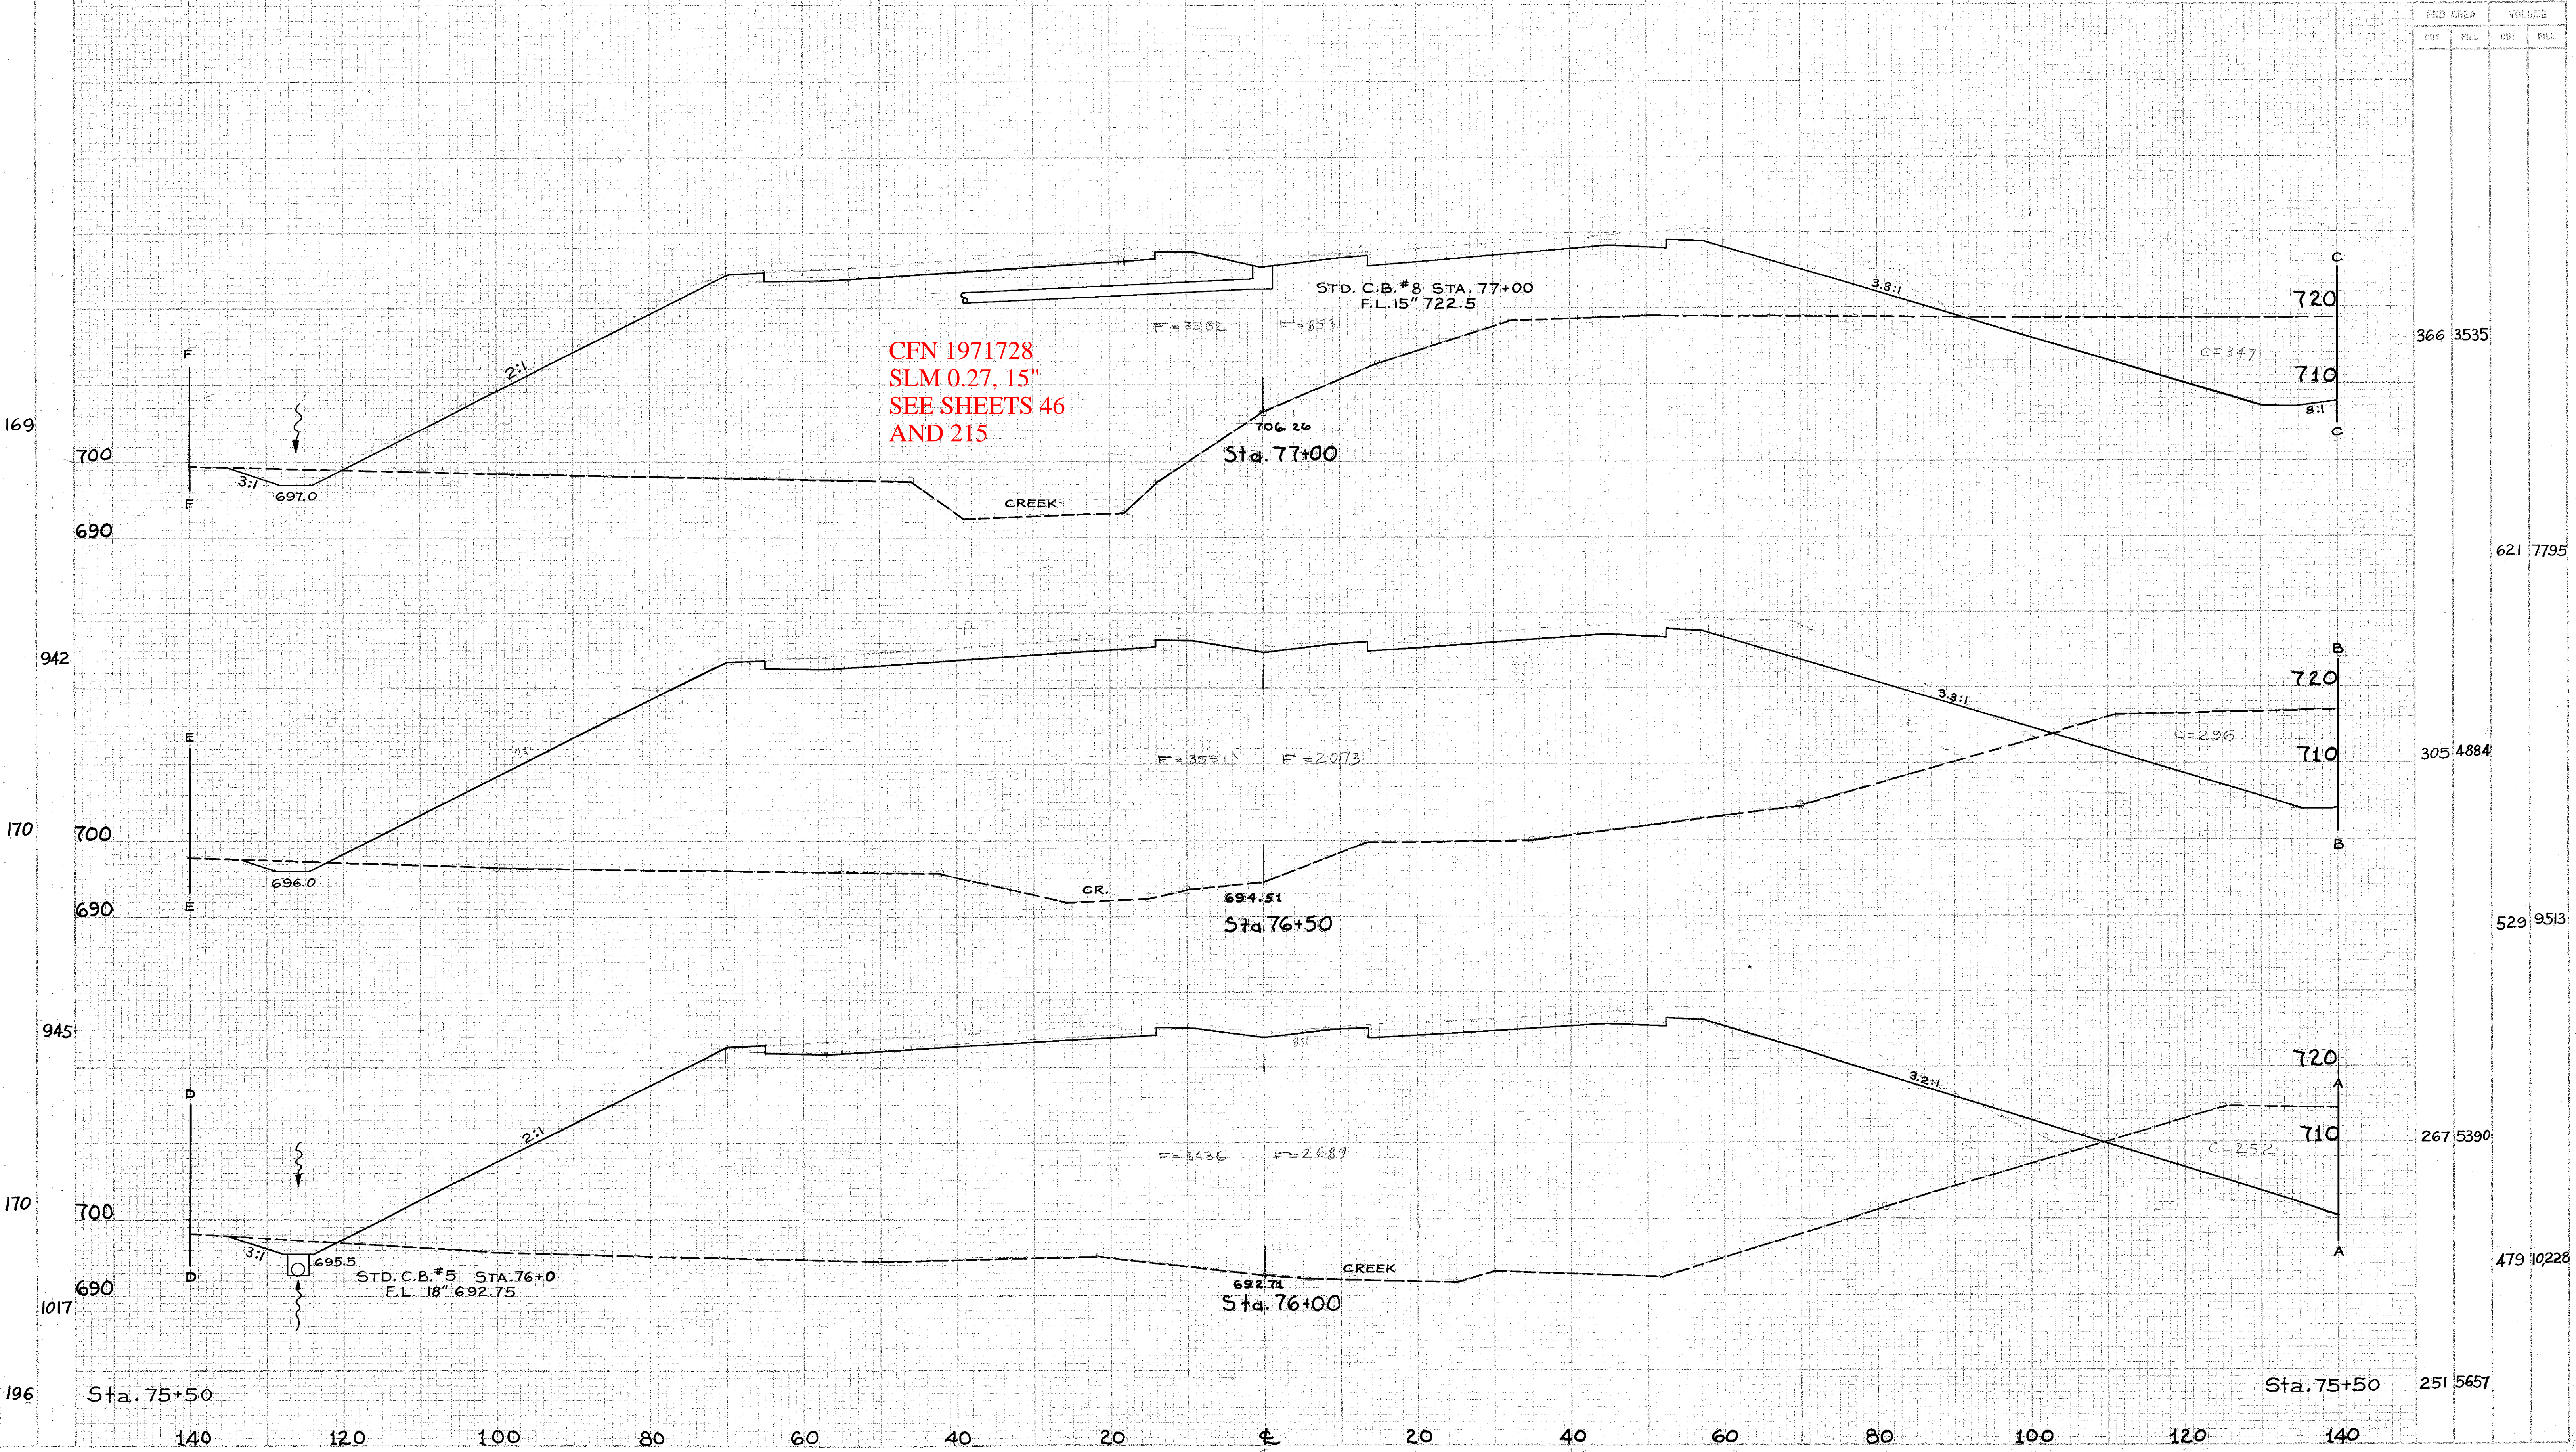

EUCLID SPUR X-SECTIONS STA. 76+00 TO STA. 77+00