


Seeding  
End Width  
Sq. Yd.

End Area		Volume	
Cut	Fill	Cut	Fill

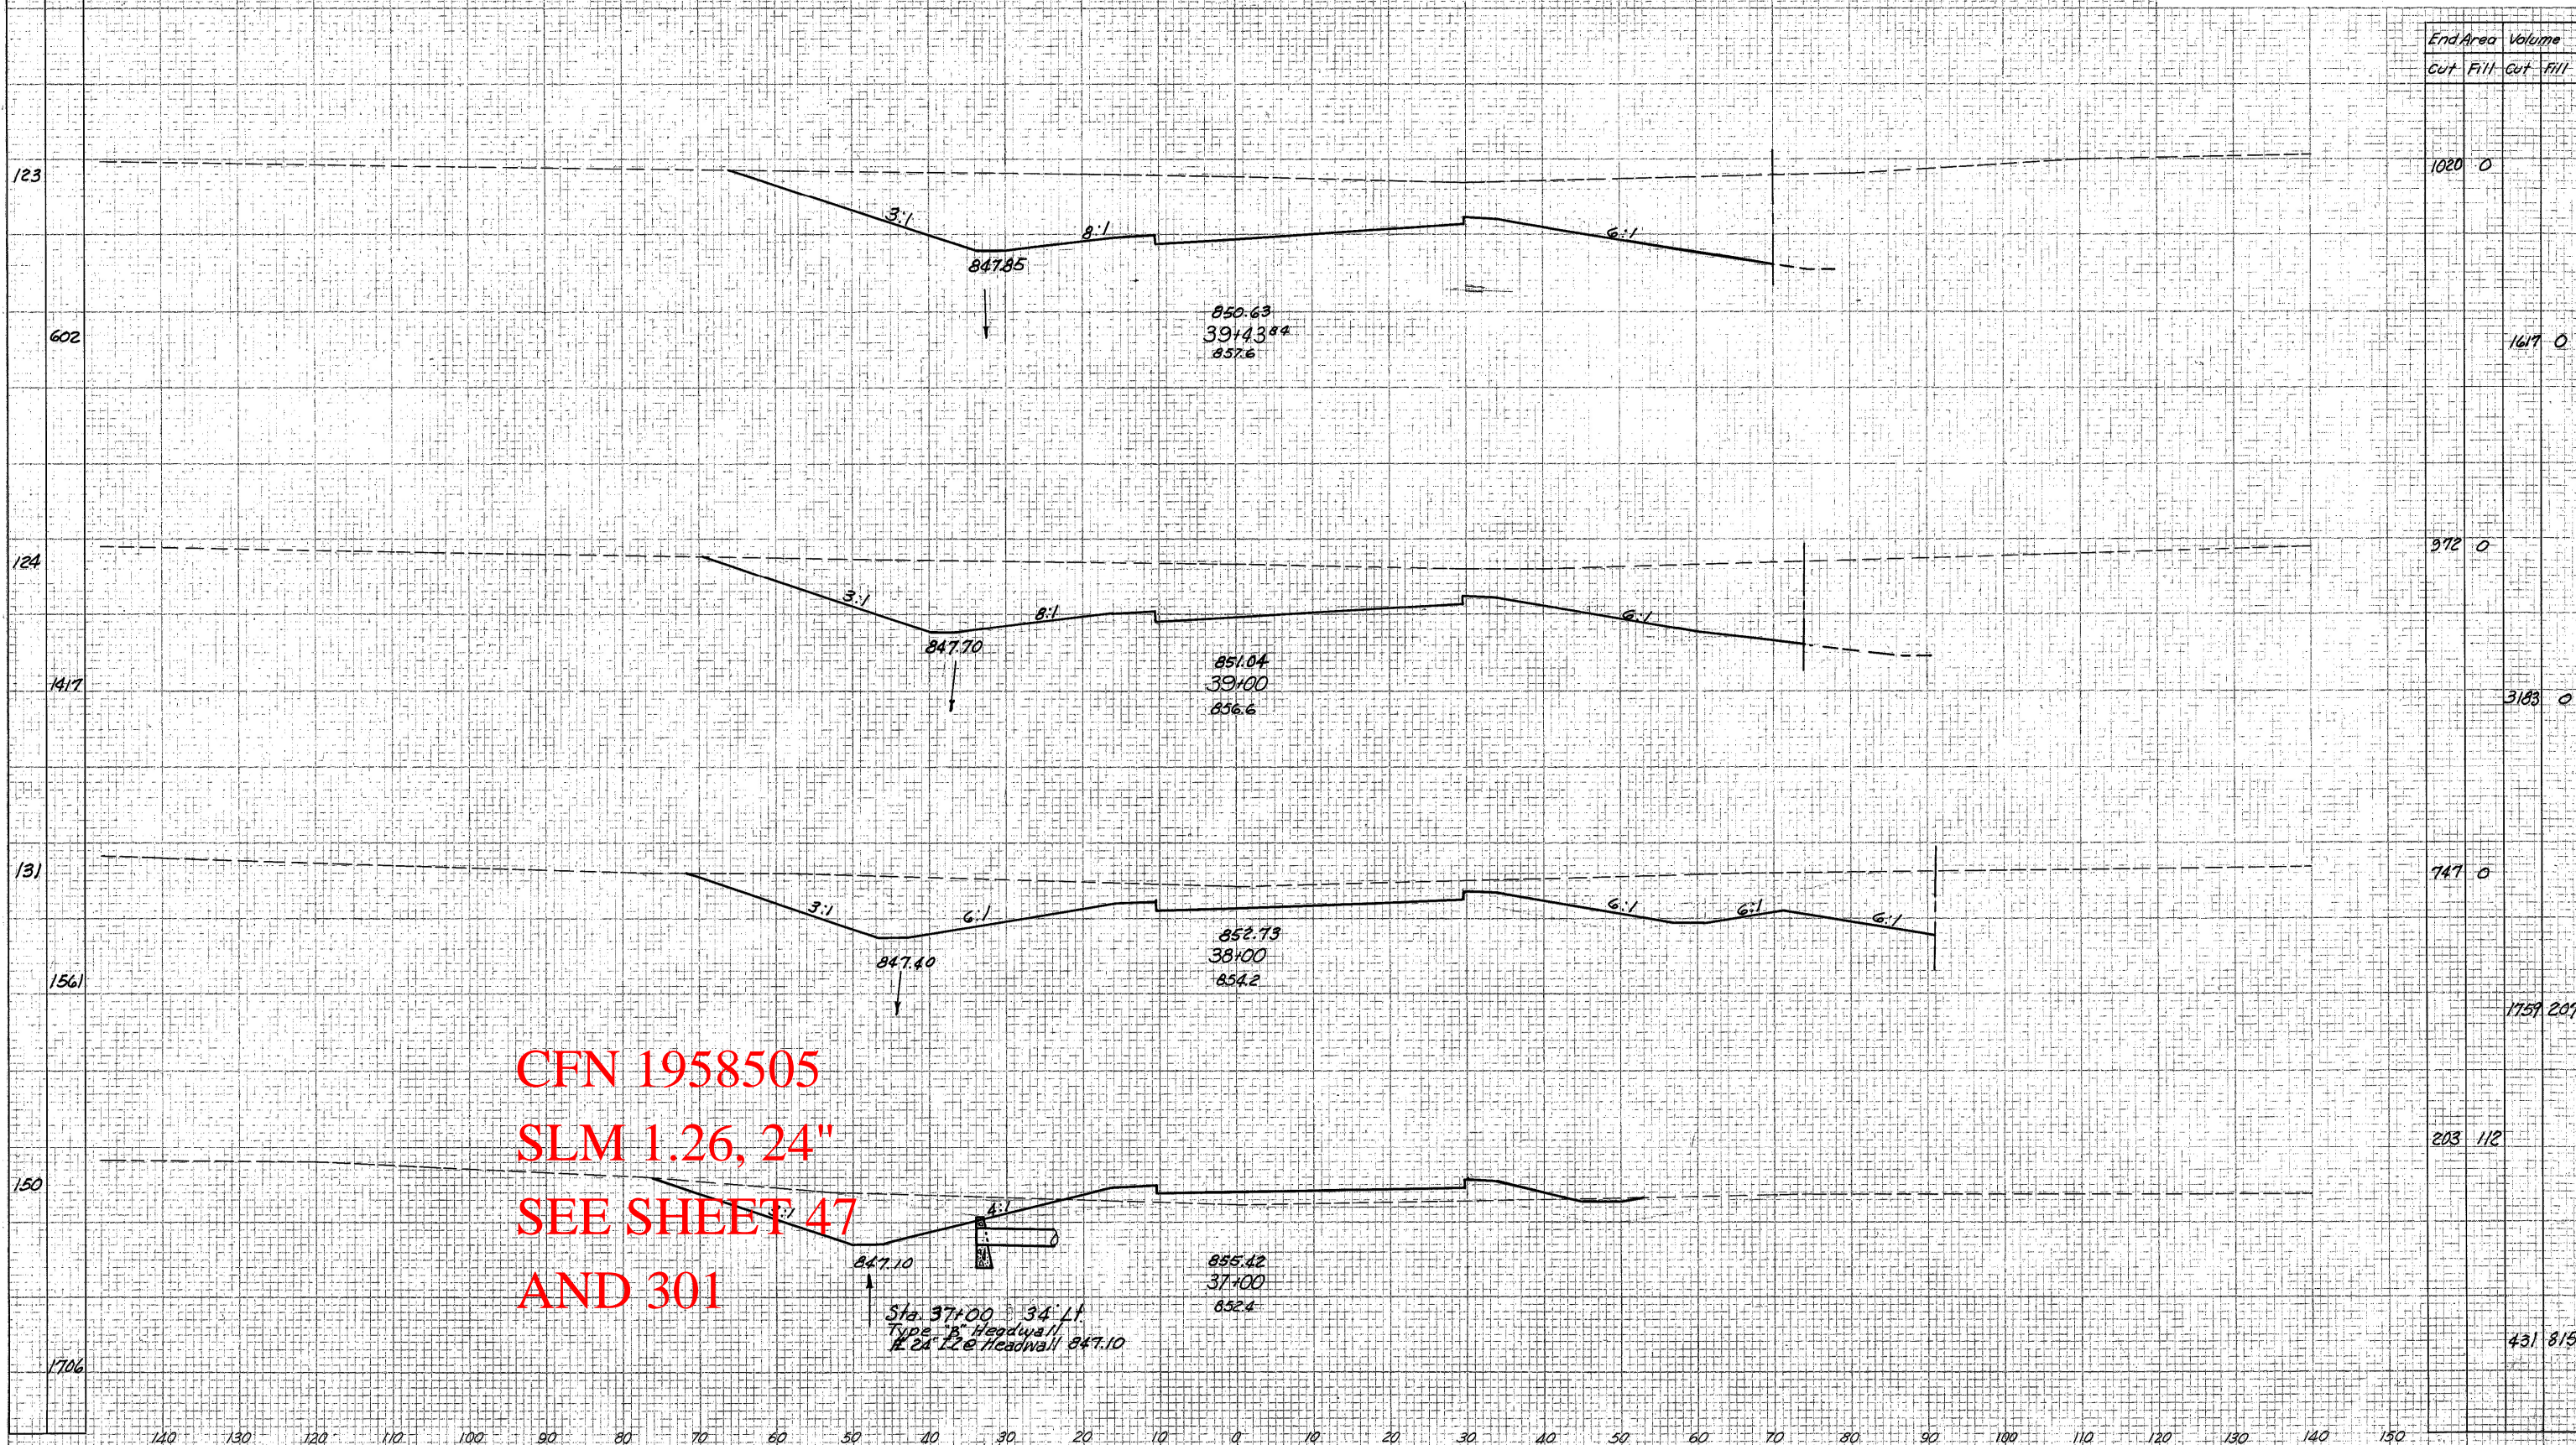

**CFN 1958505**  
**SLM 1.26, 24"**  
**SEE SHEET 47**  
**AND 301**

Sta. 37+00 34' Lt.  
 Type "B" Headwall  
 24" x 24" Headwall 847.10