


DATE: 8-17-61  
BY: [Signature]  
CHECKED: [Signature]  
NO. 10

DATE: 8-17-61  
BY: [Signature]  
CHECKED: [Signature]  
NO. 10

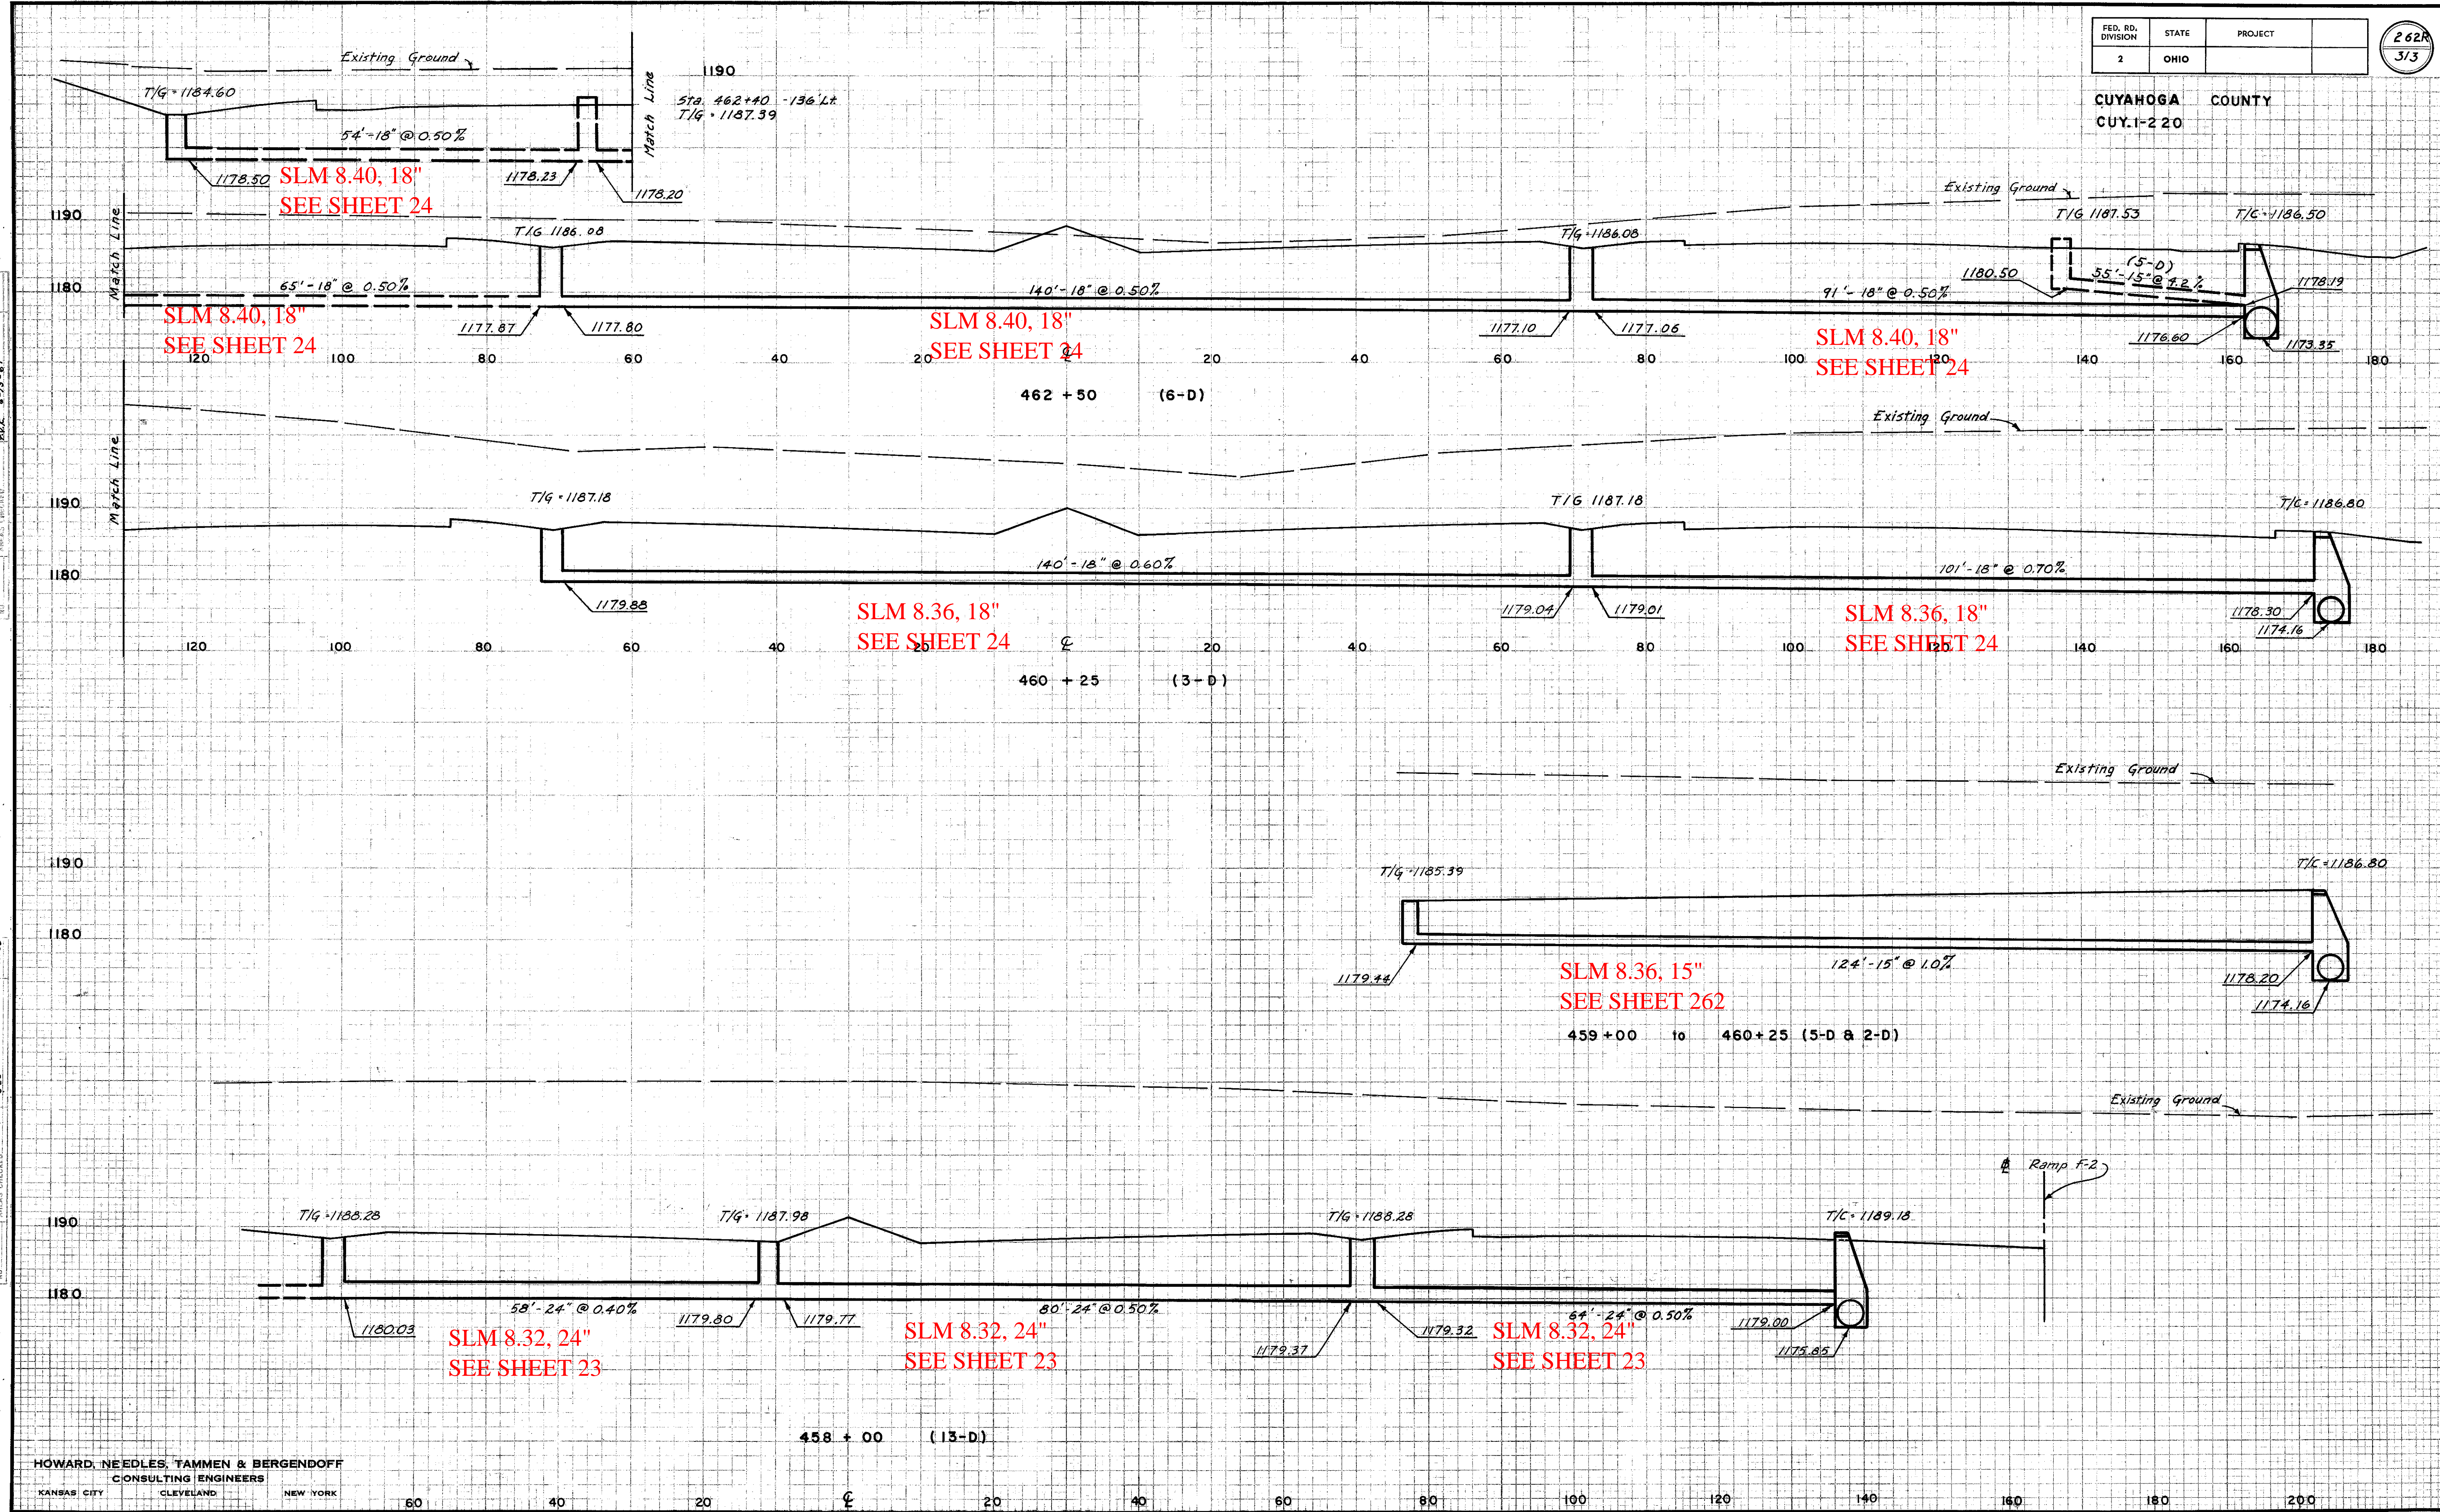

HOWARD, NEEDLES, TAMMEN & BERGENDOFF  
CONSULTING ENGINEERS  
KANSAS CITY CLEVELAND NEW YORK