

CUYAHOGA COUNTY
 SEC. CUY-2-28.16
 CUY-525-0.00
 LAKE COUNTY
 SEC. LAK-525-0.00

LAK. E. BOUND & CURVE DATA
 ①
 Ls = 200.00'
 Ts = 29.00:00"
 K = 100.00'
 L.T. = 133.34'
 S.T. = 66.67'
 L.C. = 199.99'


B.M. Top Fire Hydrant, 2nd East of angle South Side Lakeland Blvd. Sta. 85+49 (LAK. B/L) ELEV. = 643.196

SLM 29.00 (SR 2), 21"
 MM 208.39, SEE BELOW

CFN 1971600
 SLM 29.09 (SR 2), 15"
 MM 208.48, SEE SHEET 157

CFN 1971599
 SLM 29.09 (SR 2), 15"
 MM 208.48, SEE SHEET 157

SLM 28.77 SR 2 =
 MM 208.16 SR 2
 RAMP FROM IR-90

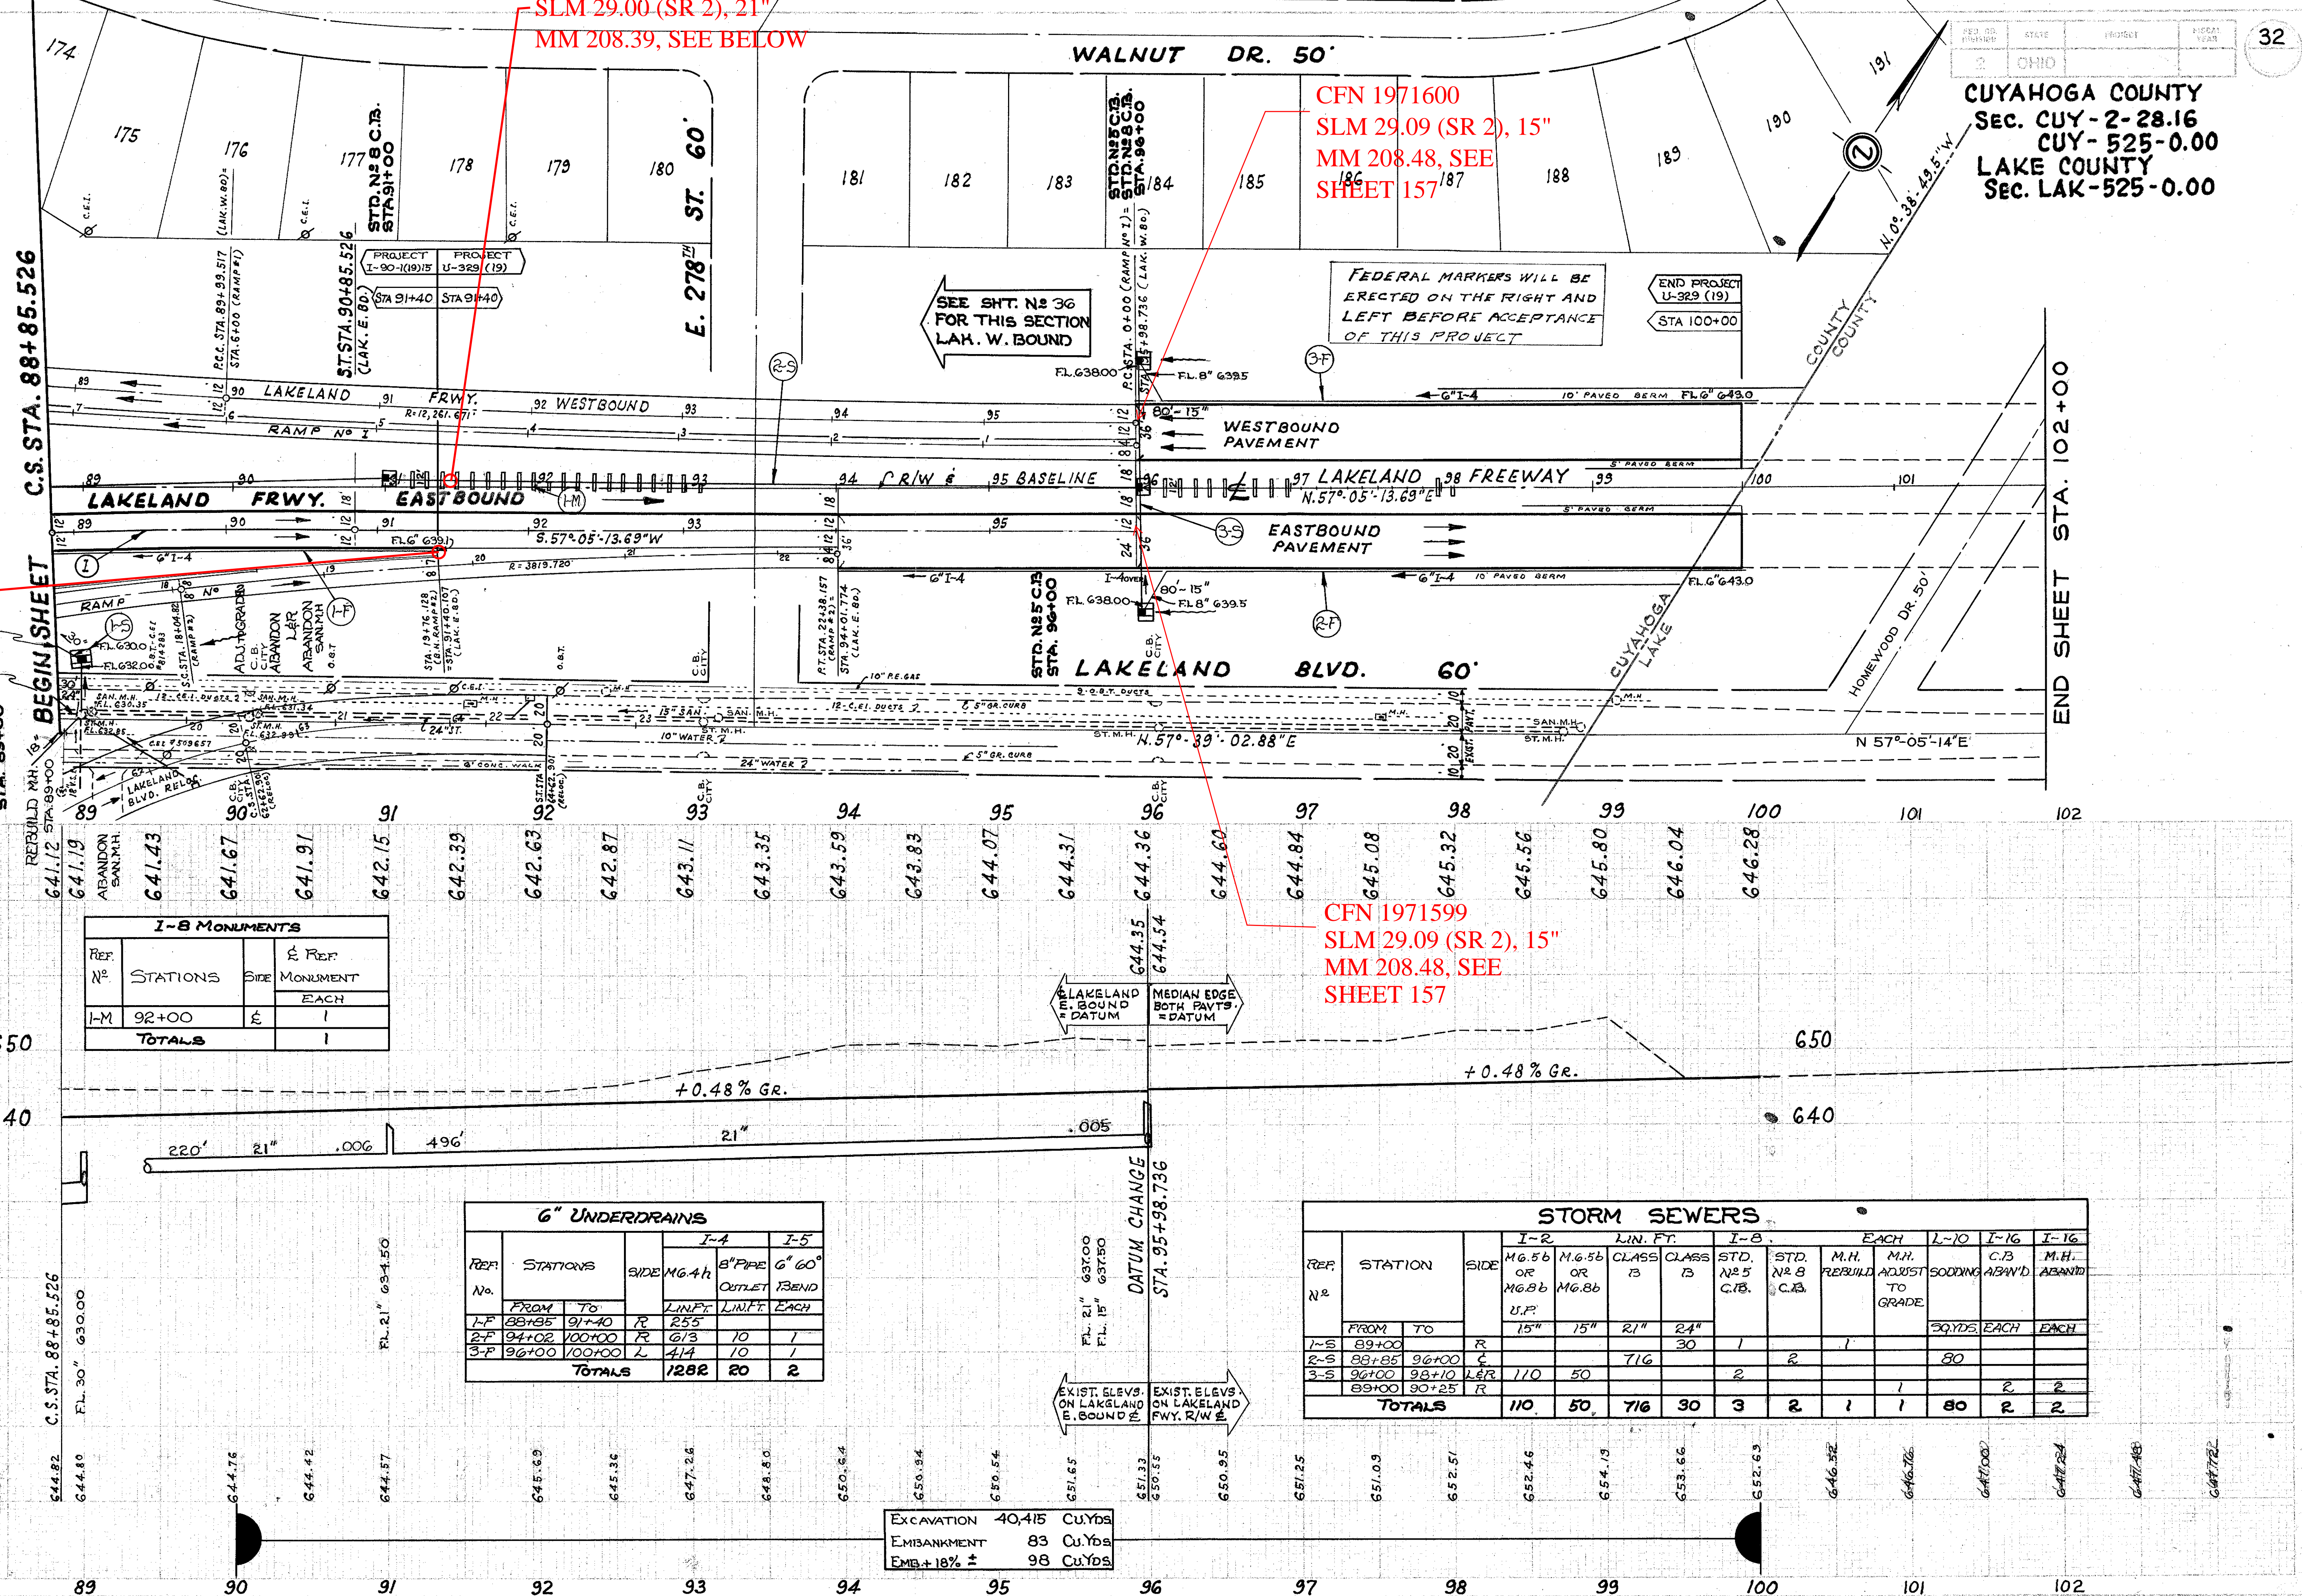

I-B MONUMENTS

REF. NO.	STATIONS	SIDE	REF. MONUMENT
I-M	92+00	E	1
TOTALS			
		E	1

6" UNDERDRAINS

REF. NO.	STATIONS	SIDE	I-4		I-5
			M.G. 4h	8" PIPE OUTLET	6" 60° BEND
1-P	88+85 91+40	R	255	10	1
2-P	94+02 100+00	R	613	10	1
3-P	96+00 100+00	L	414	10	1
TOTALS			1282	20	2

STORM SEWERS

REF. NO.	STATION	SIDE	I-2		LIN. FT.		I-8		EACH				
			M.G. 5b OR M.G. 8b U.P.	M.G. 5b OR M.G. 8b	CLASS 13	CLASS 13	STD. NO. 5 C.B.	STD. NO. 8 C.B.	M.H. REBUILD	M.H. ADJUST TO GRADE	SODDING	C.B. ASB/D	M.H. ASB/D
1-S	89+00	R	15"	15"	21"	30"	1	2	1				
2-S	88+85 96+00	C			716		2	2		80			
3-S	96+00 98+10	L/R	110	50			2						
	89+00 90+25	R						1			2	2	
TOTALS			110	50	716	30	3	2	1	1	80	2	2

EXCAVATION 40,415 Cu.Yds
 EMBANKMENT 83 Cu.Yds
 EMB. ± 18% ± 98 Cu.Yds

PLAN & PROFILE - LAKELAND W. BOUND (STA. 95+98.736 to STA. 100+00) & LAKELAND FWY. E. BOUND (C.S. STA. 88+85.526 to STA. 100+00) COUNTY LINE