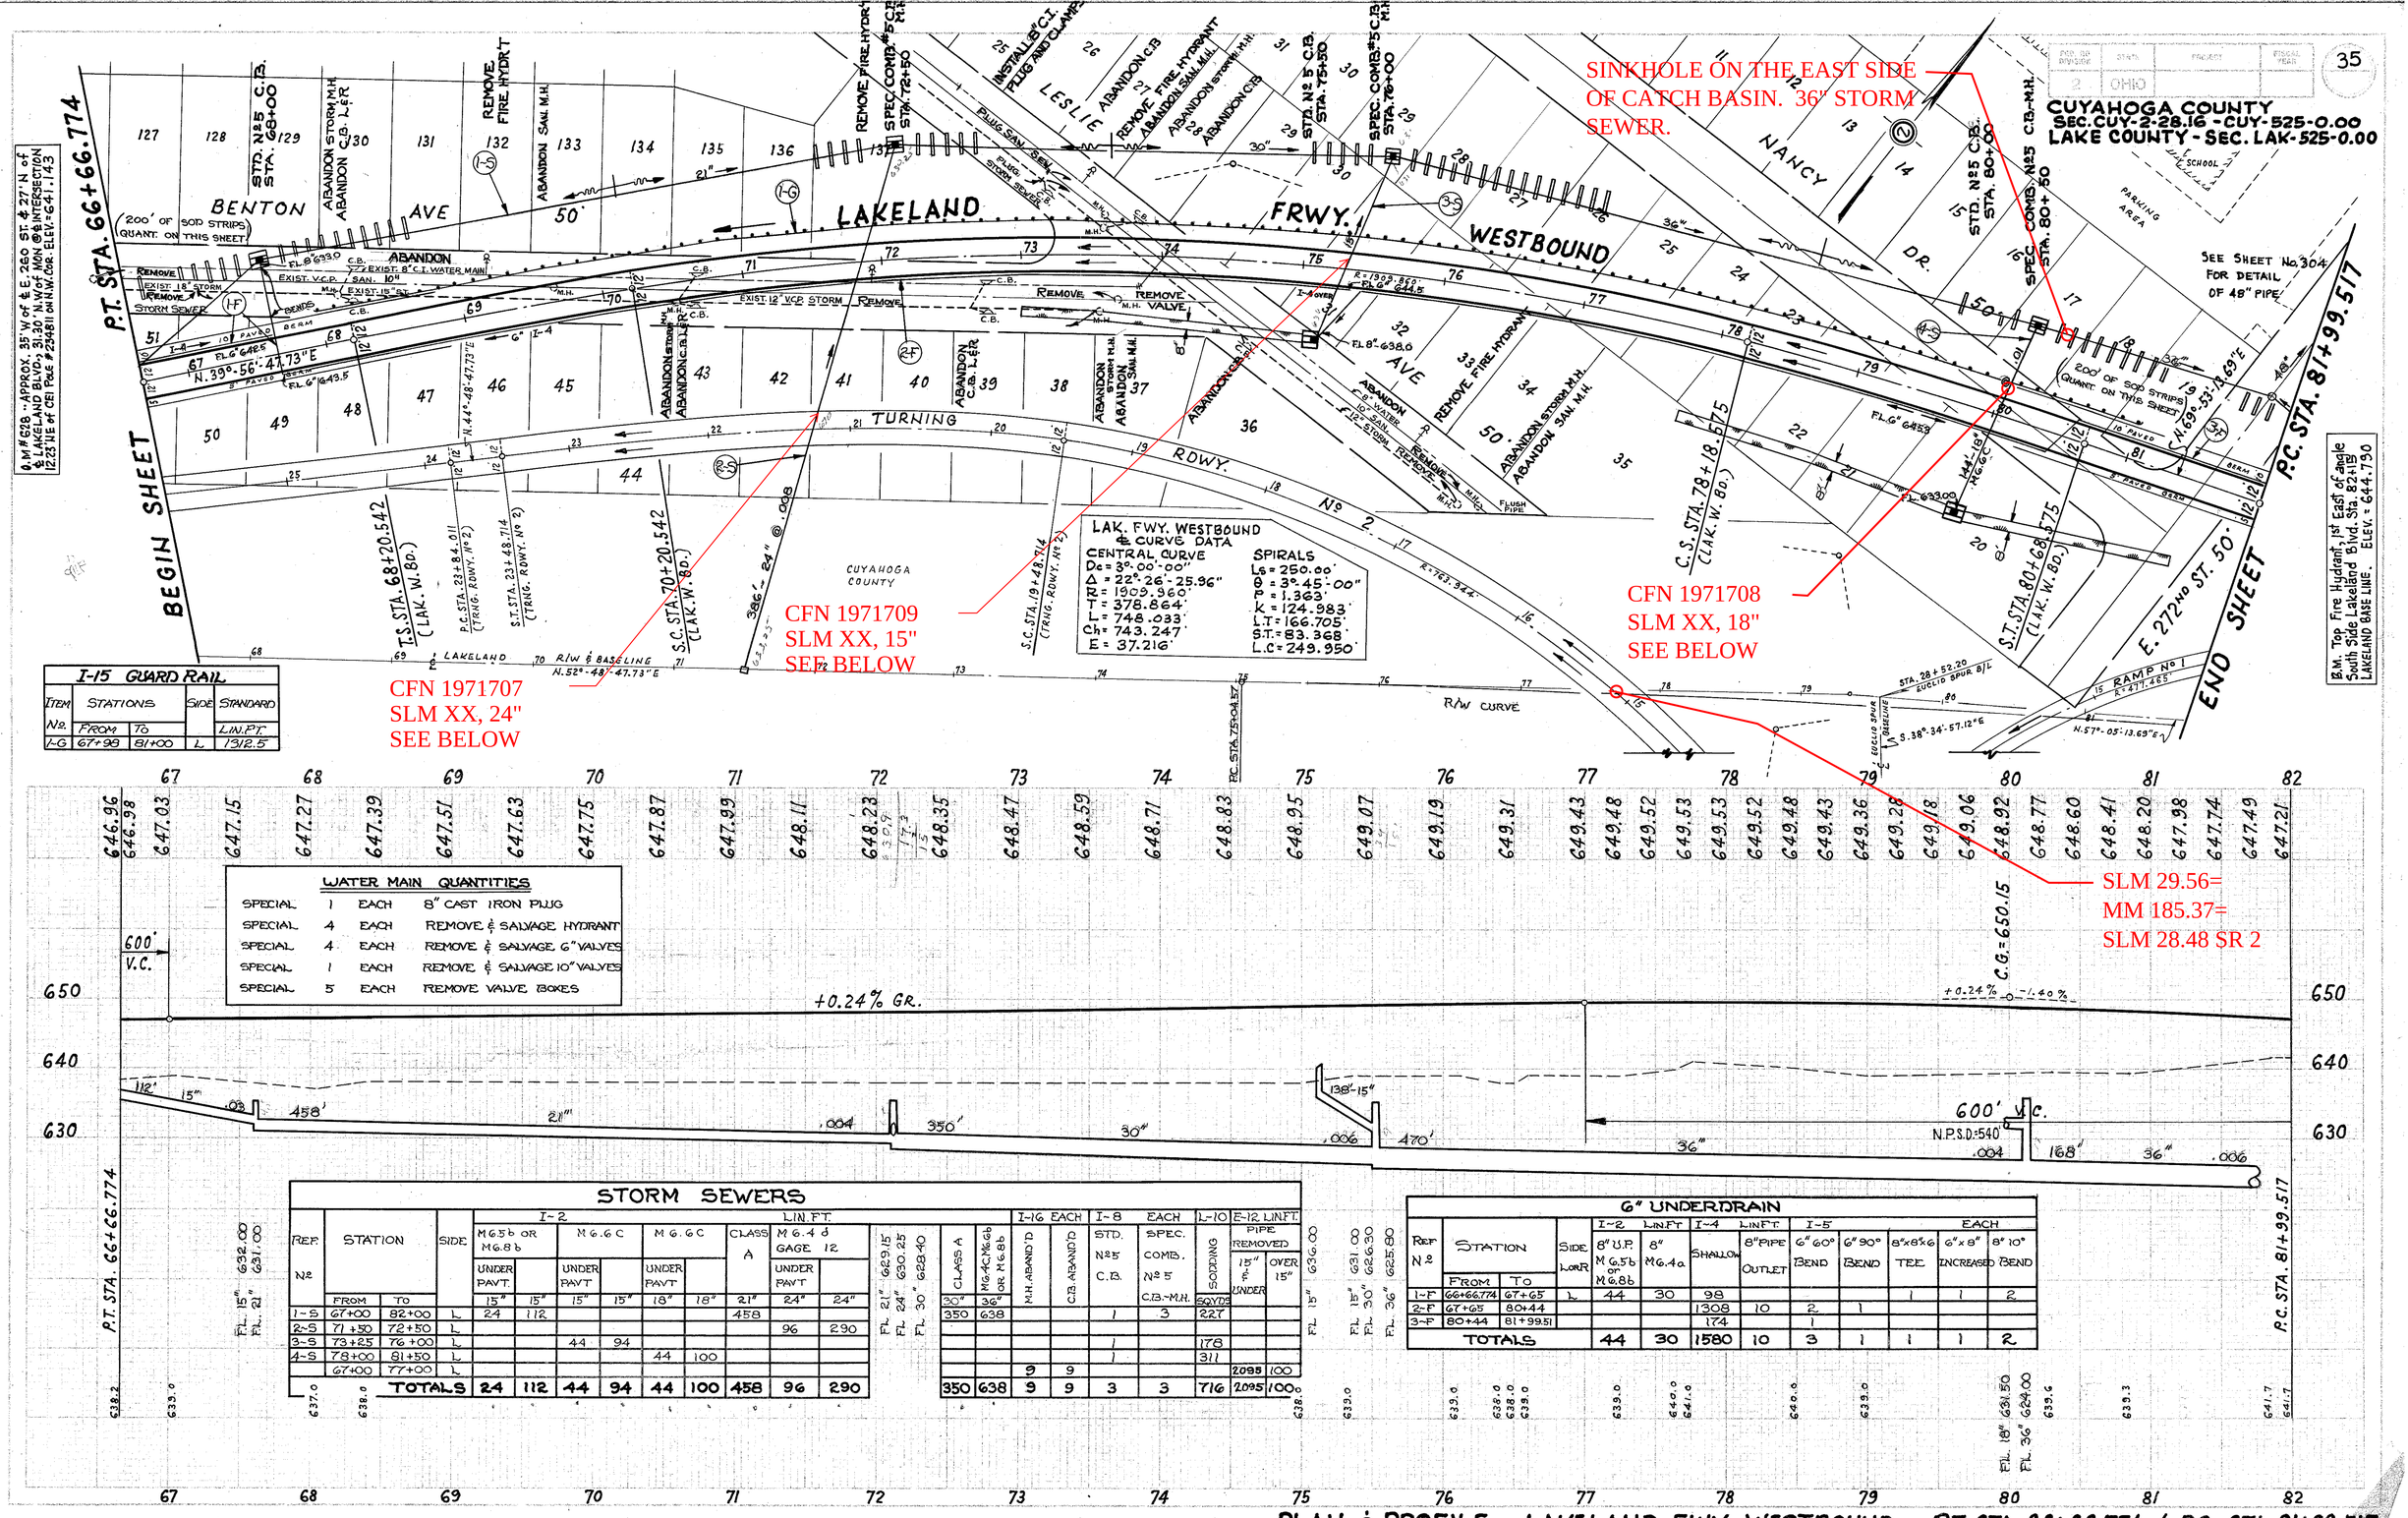
35
CUYAHOGA COUNTY
SEC. CUY-2-28.16 - CUY-525-0.00
LAKE COUNTY - SEC. LAK-525-0.00
SINKHOLE ON THE EAST SIDE OF CATCH BASIN. 36" STORM SEWER.
CFN 1971709
SLM XX, 15"
SEE BELOW
CFN 1971708
SLM XX, 18"
SEE BELOW
CFN 1971707
SLM XX, 24"
SEE BELOW
SLM 29.56=
MM 185.37=
SLM 28.48 SR 2
P.T. STA. 66+66.774
P.C. STA. 81+99.517
BEGIN SHEET
END SHEET
LAKELAND FRWY. WESTBOUND
TURNING RDWY. No 2
BENTON AVE
NANCY DR.
E. 272ND ST.
RAMP No 1
SEE SHEET No. 304 FOR DETAIL OF 48" PIPE
200' OF SOD STRIPS (QUANT. ON THIS SHEET)
LAK. FWY. WESTBOUND ℄ CURVE DATA
CENTRAL CURVE
Dc = 3°-00'-00"
Δ = 22°-26'-25.96"
R = 1909.860'
T = 378.864'
L = 748.033'
Ch = 743.247'
E = 37.216'
SPIRALS
Ls = 250.00'
θ = 3°-45'-00"
P = 1.363'
K = 124.983'
L.T = 166.705'
S.T. = 83.368'
L.C = 249.950'
I-15 GUARD RAIL
ITEM No. I-G STATIONS FROM 67+98 TO 81+00 SIDE L STANDARD LIN.FT. 1312.5
WATER MAIN QUANTITIES
SPECIAL 1 EACH 8" CAST IRON PLUG
SPECIAL 4 EACH REMOVE & SALVAGE HYDRANT
SPECIAL 4 EACH REMOVE & SALVAGE 6" VALVES
SPECIAL 1 EACH REMOVE & SALVAGE 10" VALVES
SPECIAL 5 EACH REMOVE VALVE BOXES
+0.24% GR.
600' V.C.
N.P.S.D.:540
C.G.=650.15
STORM SEWERS
6" UNDERDRAIN
PLAN & PROFILE ··· LAKELAND FWY. WESTBOUND ··· P.T. STA. 66+66.774 to P.C. STA. 81+99.517