
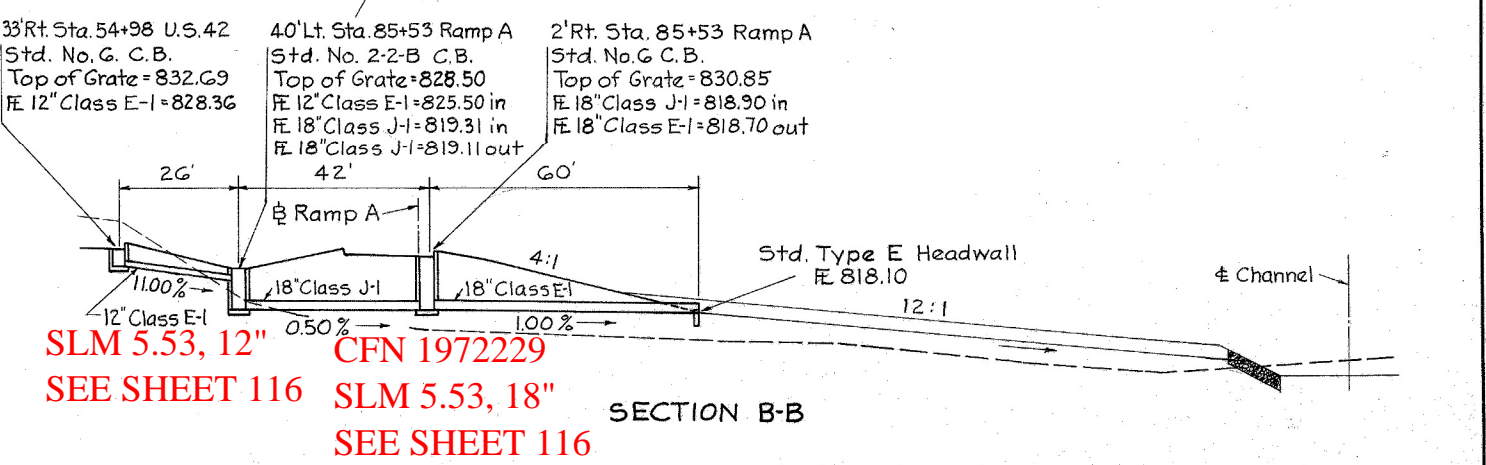
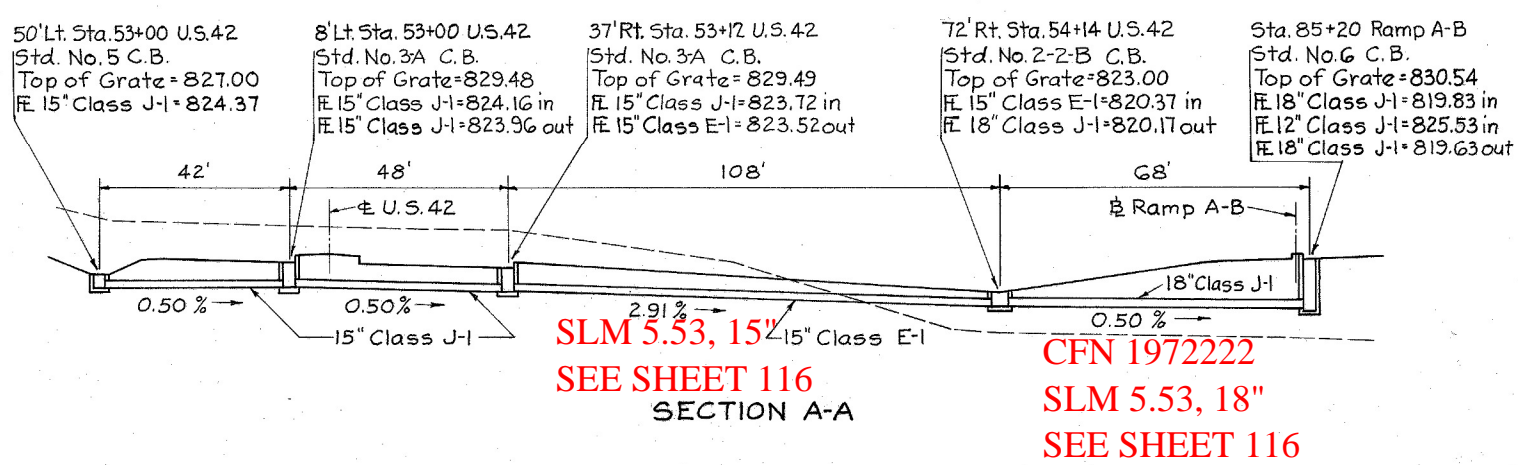
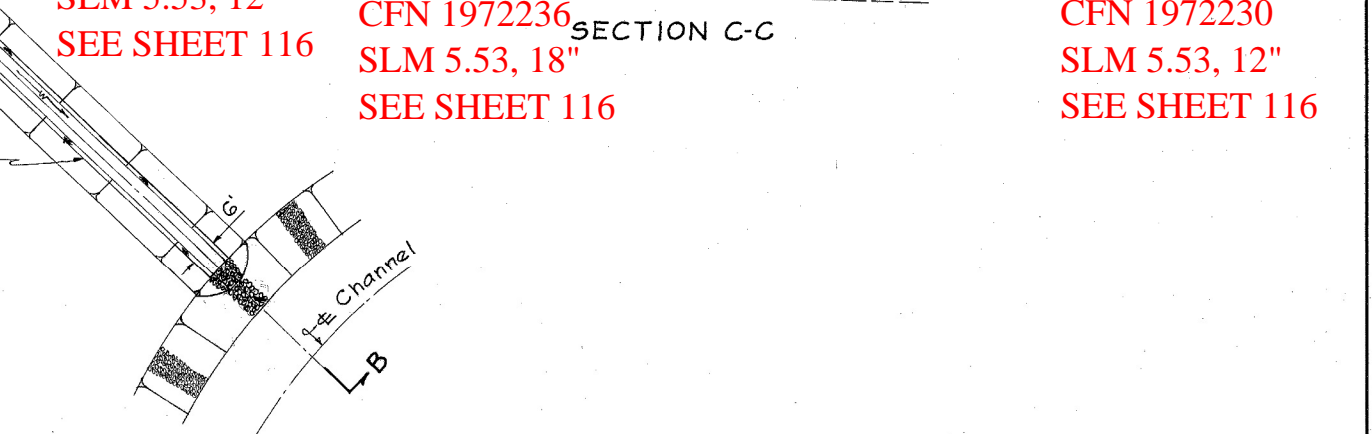
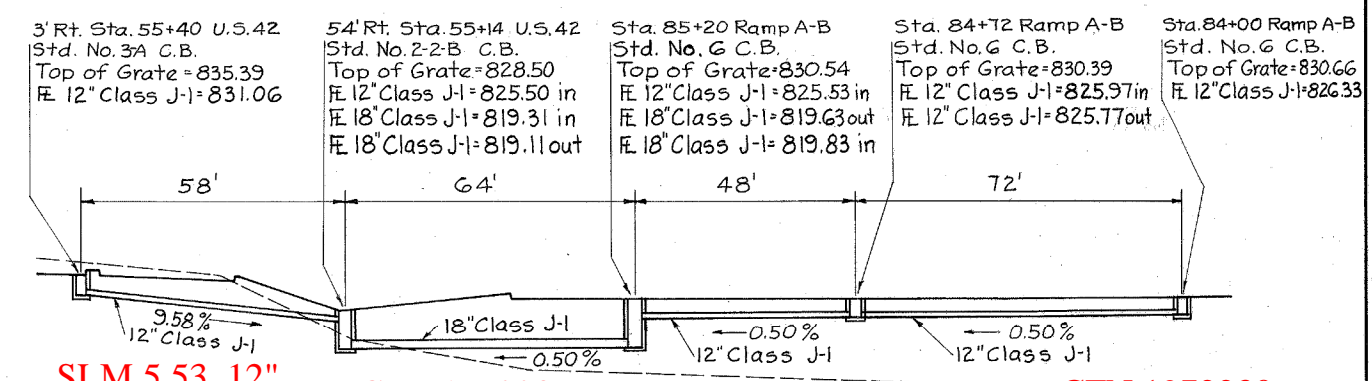


CUYAHOGA COUNTY
CUY-42-3.38

ESTIMATED QUANTITIES

I-1	12" Pipe Class E-1	26	L.F.
I-1	15" Pipe Class E-1	108	L.F.
I-1	18" Pipe Class E-1	60	L.F.
I-1	12" Pipe Class J-1	178	L.F.
I-1	15" Pipe Class J-1	90	L.F.
I-1	18" Pipe Class J-1	174	L.F.
I-2	Masonry	03	C.Y.
I-8	Std. No. 3A C.B.	3	Ea.
I-8	Std. No. 5 C.B.	1	Ea.
I-8	Std. No. 6 C.B.	5	Ea.
L-10	Sodding	60	S.Y.
I-8	Std. No. 2-2-B C.B.	1	Ea.

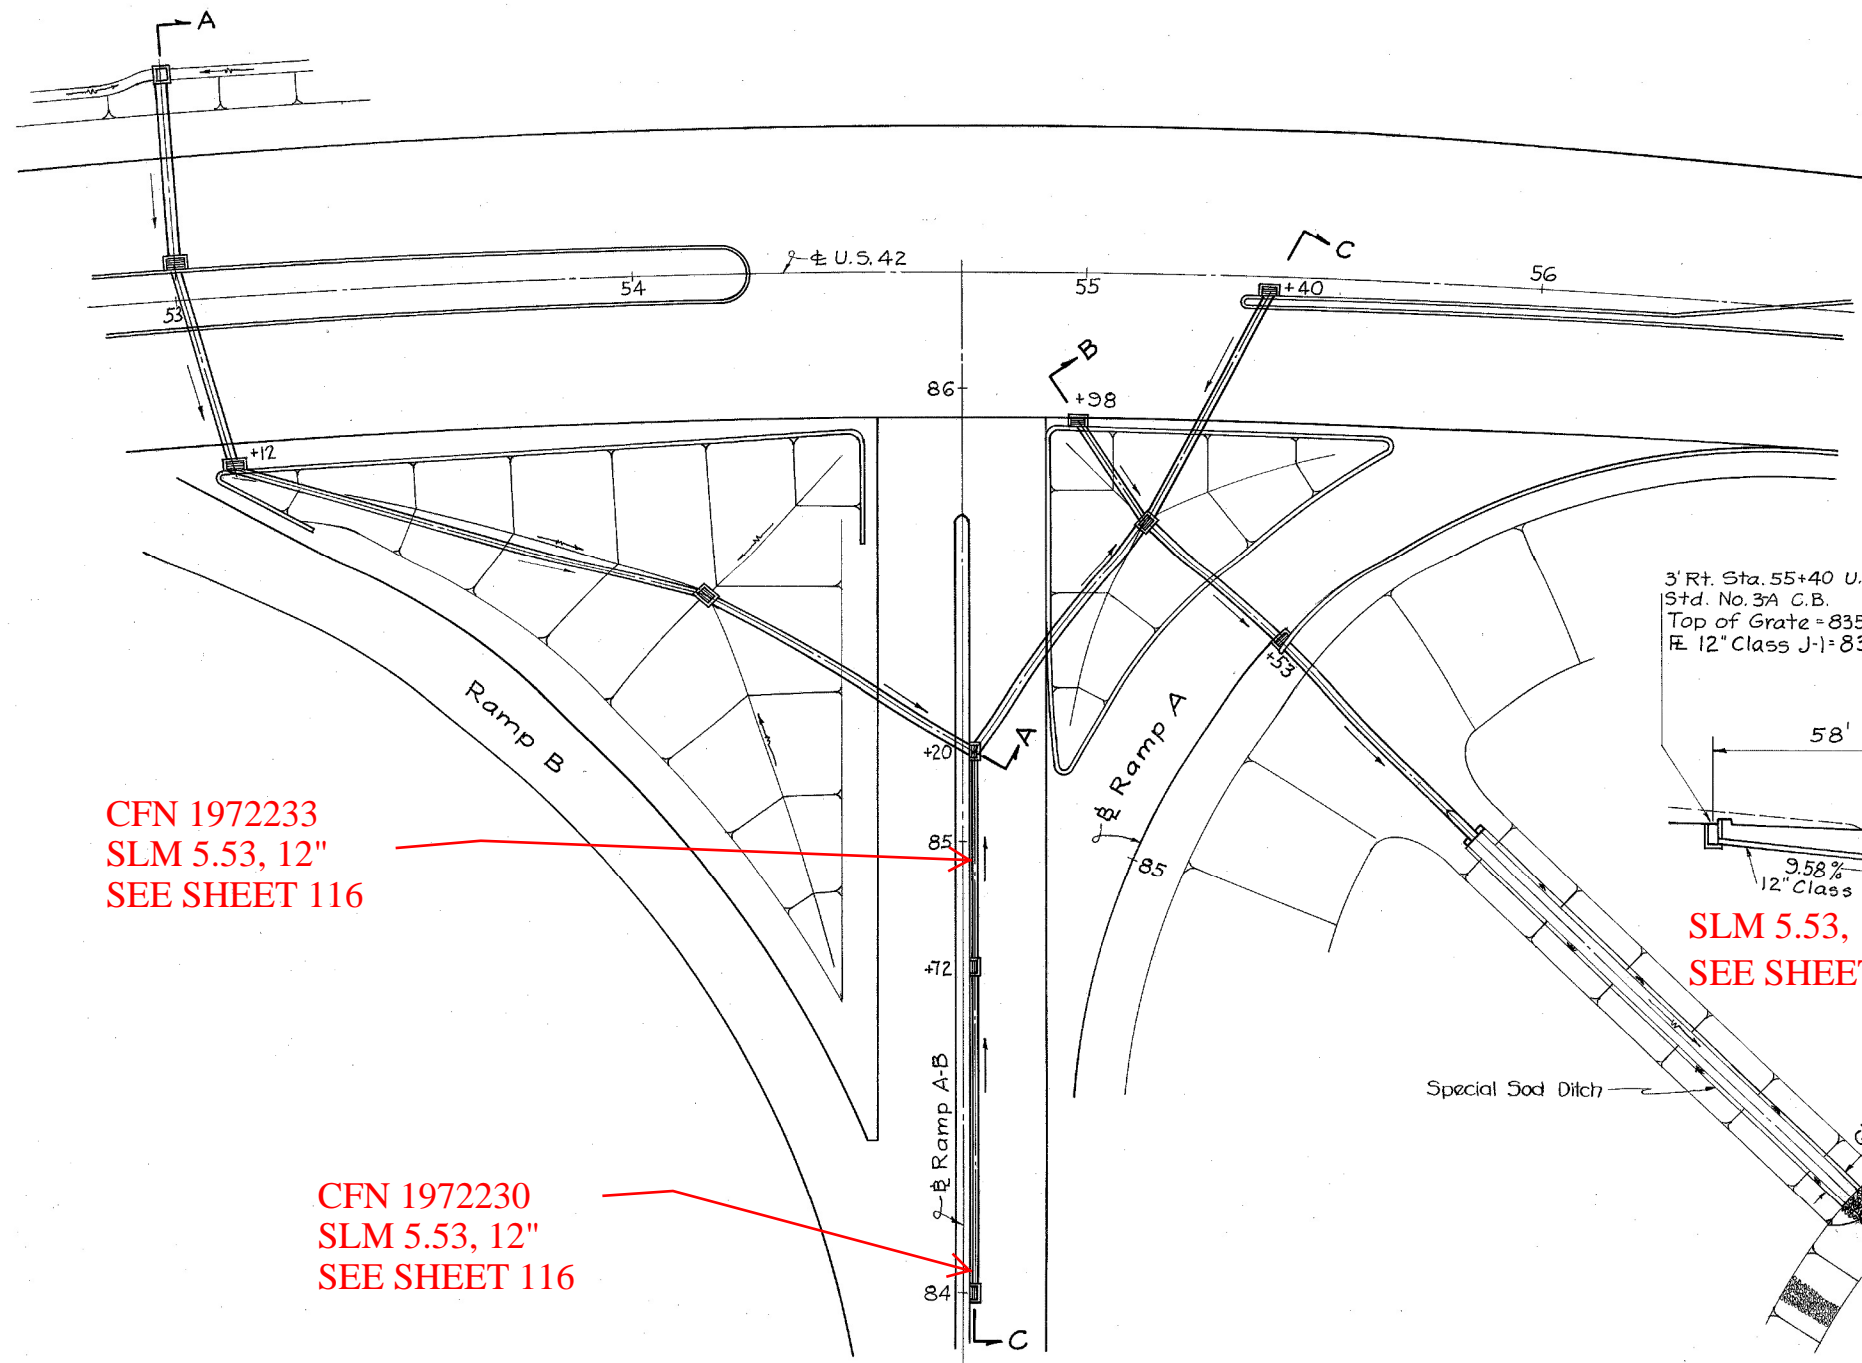

CFN 1972233
SLM 5.53, 12"
SEE SHEET 116

CFN 1972230
SLM 5.53, 12"
SEE SHEET 116

SLM 5.53, 12"
SEE SHEET 116

CFN 1972236
SLM 5.53, 18"
SEE SHEET 116

CFN 1972230
SLM 5.53, 12"
SEE SHEET 116

SLM 5.53, 15"
SEE SHEET 116
SECTION A-A

CFN 1972222
SLM 5.53, 18"
SEE SHEET 116

SLM 5.53, 12"
SEE SHEET 116

CFN 1972229
SLM 5.53, 18"
SEE SHEET 116

SECTION B-B