


FED. RD. DIVISION	STATE	PROJECT	FISCAL YEAR
2	OHIO		

185
353

CUYAHOGA COUNTY
CUY-71-5.72

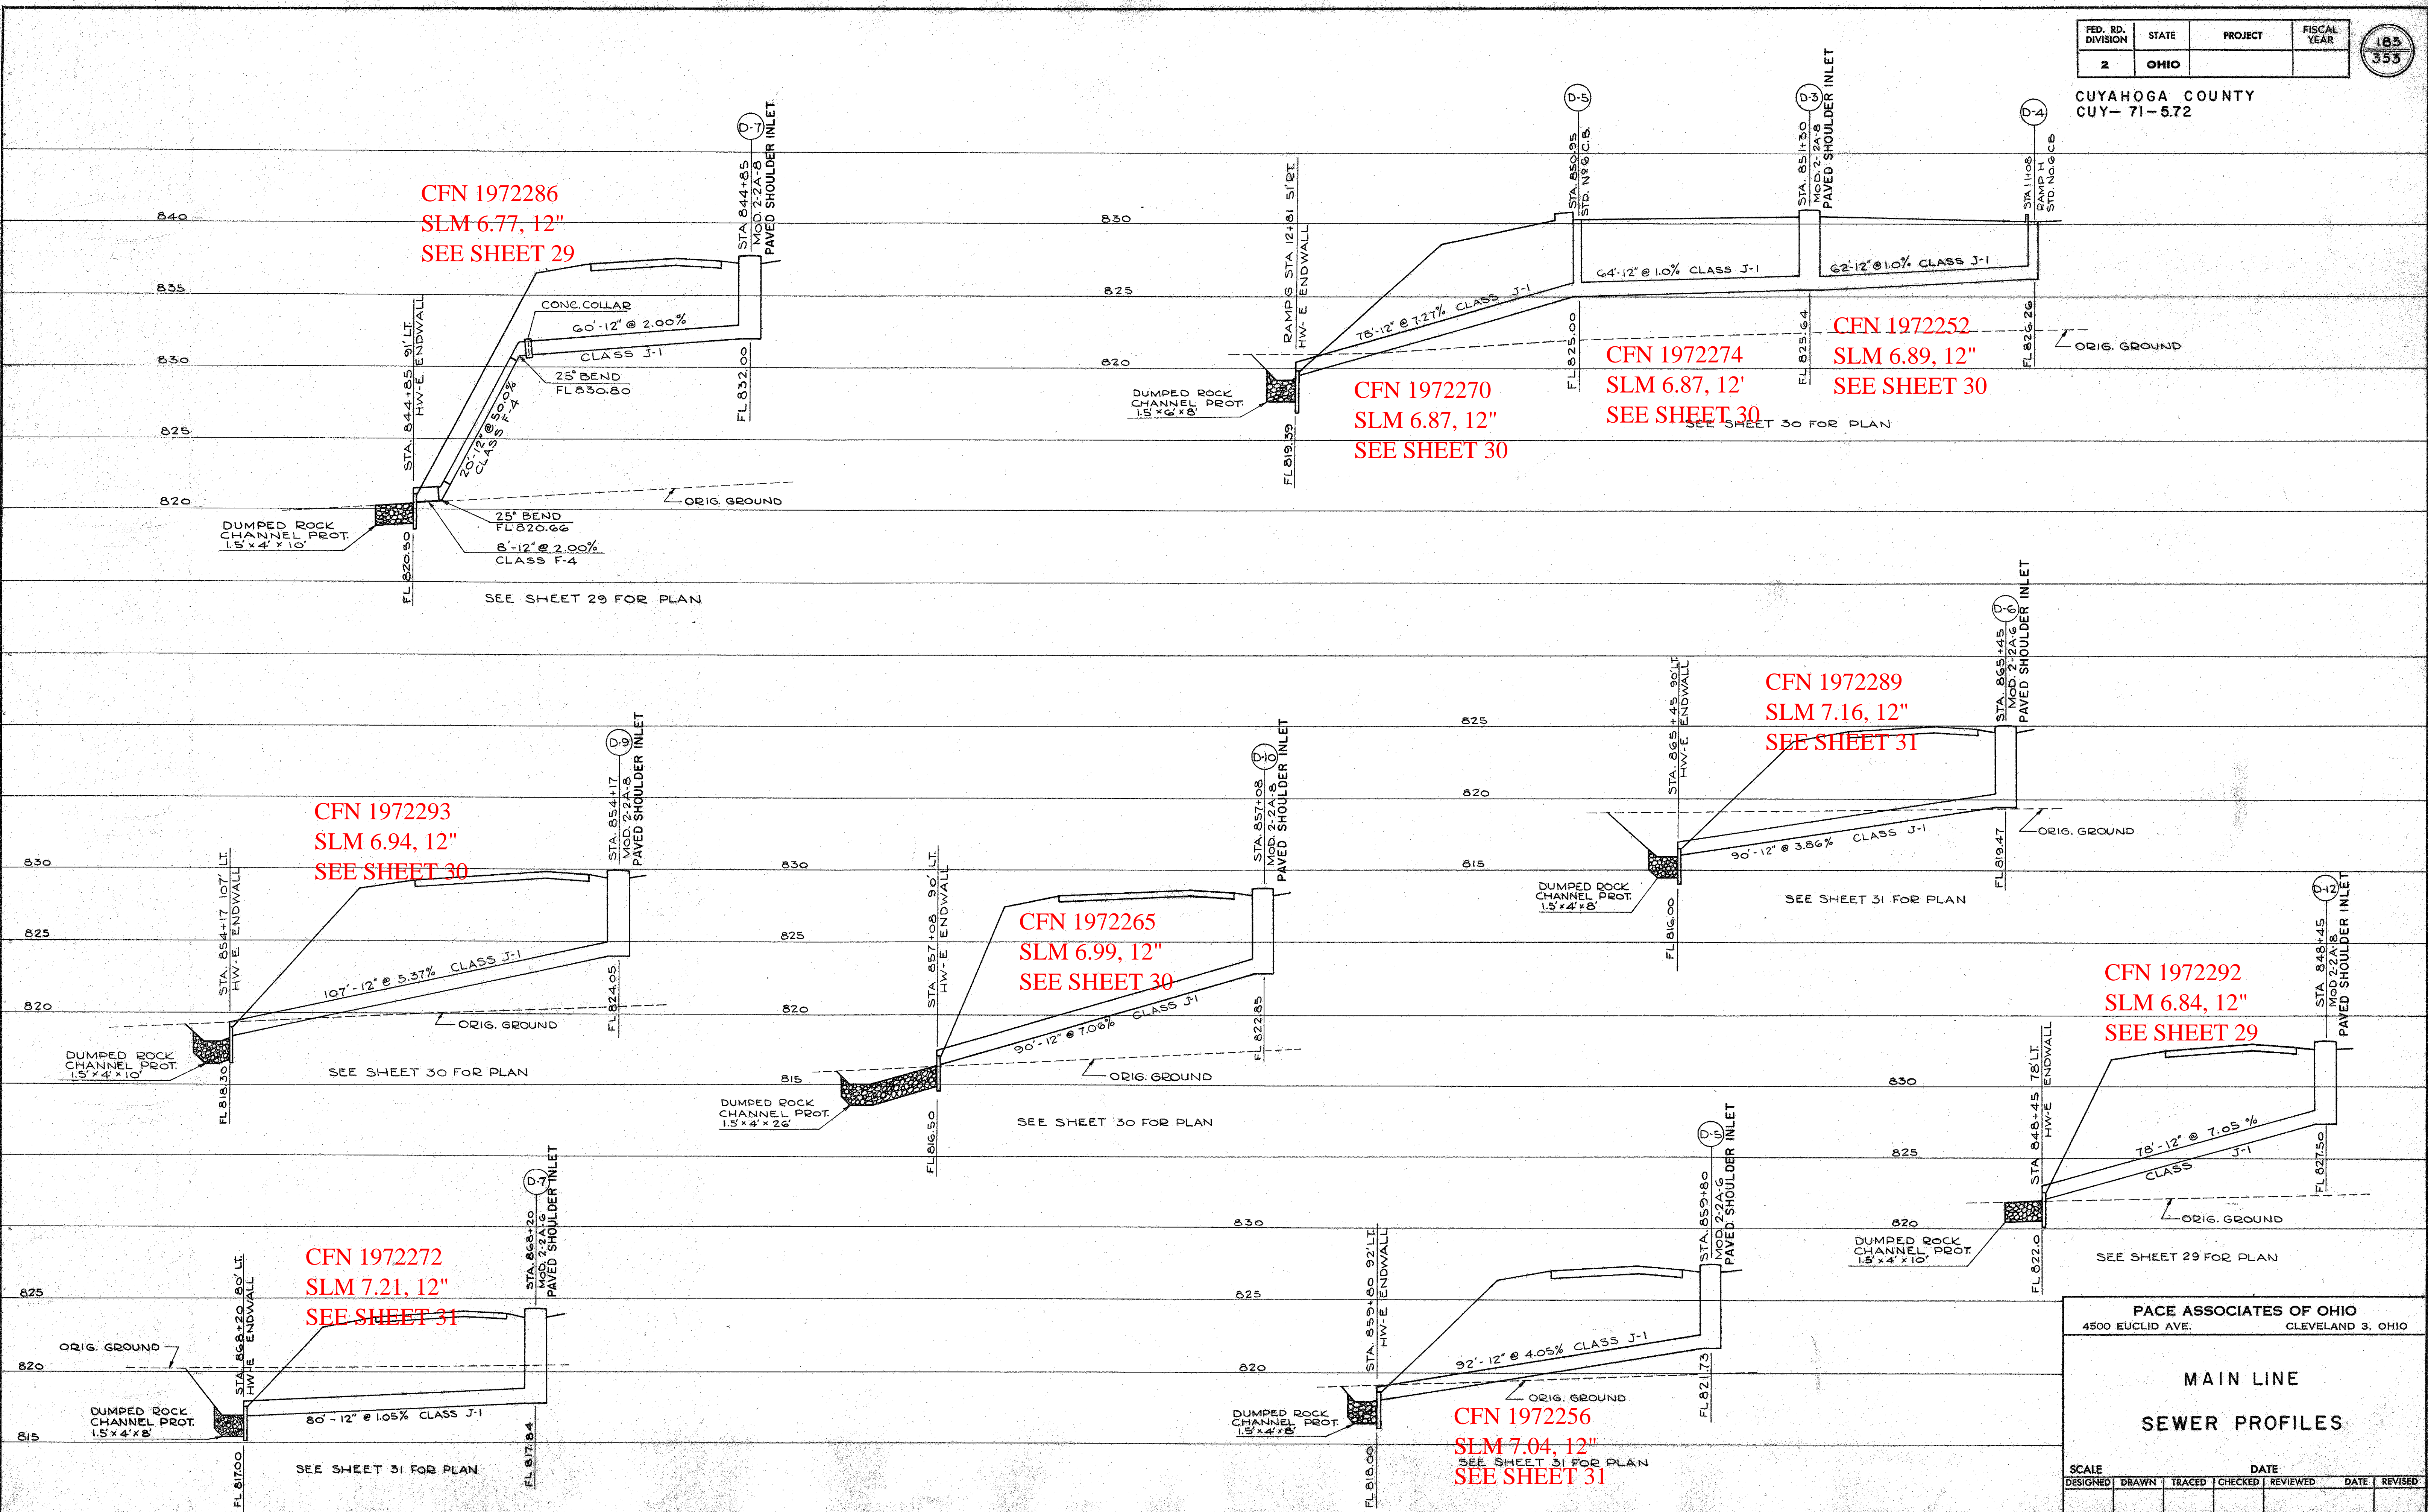

PACE ASSOCIATES OF OHIO
4500 EUCLID AVE. CLEVELAND 3, OHIO

**MAIN LINE
SEWER PROFILES**

SCALE	DATE
DESIGNED	DRAWN
TRACED	CHECKED
REVIEWED	DATE
	REVISED