

CFN 1972274  
SLM 6.87, 12"  
SEE SHEET, 185


FOR RAMP G PROFILE  
SEE SHEET 168  
CFN 1972270  
SLM 6.87, 12"  
SEE SHEET, 185

FOR SIGN PLAN  
SEE SHEET 244  
CFN 1972293  
SLM 6.94, 12"  
SEE SHEET 185

CFN 1972265  
SLM 6.99, 12"  
SEE SHEET 185

CFN 1972252  
SLM 6.89, 12"  
SEE SHEET 185

old CFN 180710699  
new CFN 1881941  
SLM 7.01, 72"  
SEE SHEET 202

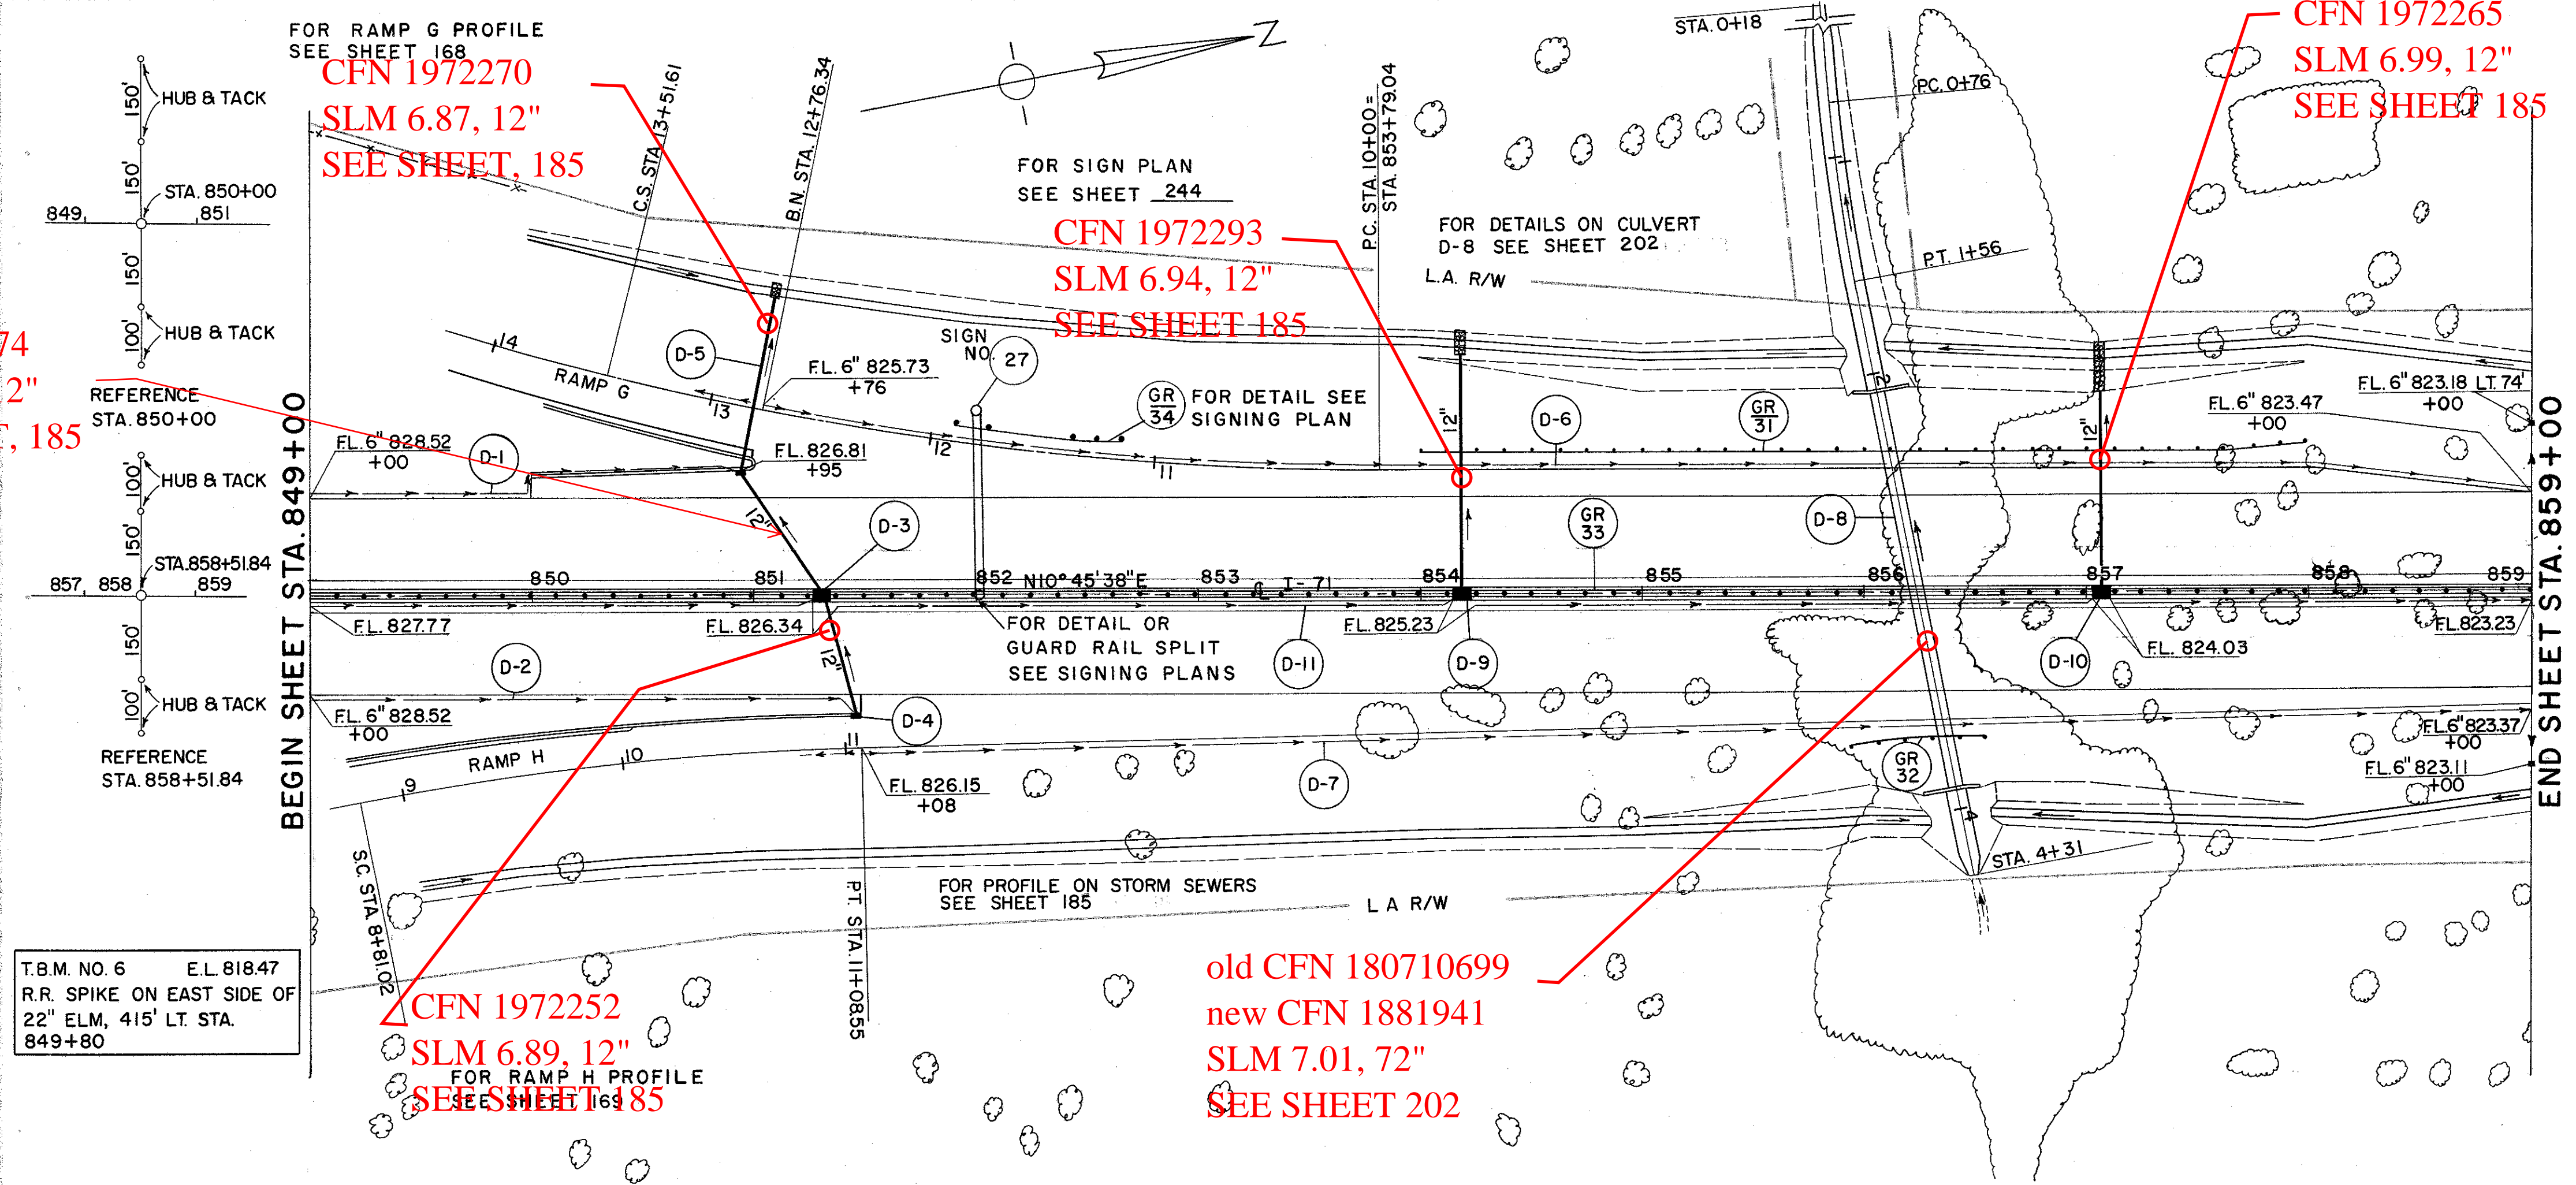


**DRAINAGE**

REF. NO.	STATION	DRAINAGE	DRAINAGE																			
			I-1	I-2	I-5	I-8	L-10	I-10	E-3													
D-1	849+00	850+95	LT.																			
D-2	849+00	851+00	RT.	28	190	10																
D-3	851+30	850+95	LT.				64															
D-4	11+08	851+30	RT.				62															
D-5	850+95	12+81	RT.				78	0.23												2.7		
D-6	12+76	859+00	LT.				816	30														
D-7	11+08	859+00	RT.				768	10														
D-8	0+18	4+31	CHANNEL						183	35.6				116						83	362	
D-9	854+17		DITCH							0.23											2.1	
D-10	851+08		DITCH							0.23											5.8	
D-11	849+00	859+00	M				976															
TOTAL				28	2943	60	401	183	36.29	1	4	2	3	119						10.6	83	362

**ROADWAY**

REF. NO.	STATION	SIDE	GUARD RAIL		LIN. FT.
			STEEL BEAM	RAIL (DEEP)	
GR-31	854+00	858+00	LT.	400	
GR-32	855+92.5	856+55	RT.	62.5	
GR-33	849+00	859+00	M		1000
GR-34	851+97	852+42	RT.	50	
TOTAL				462.5	1000

\* AS PER PLAN

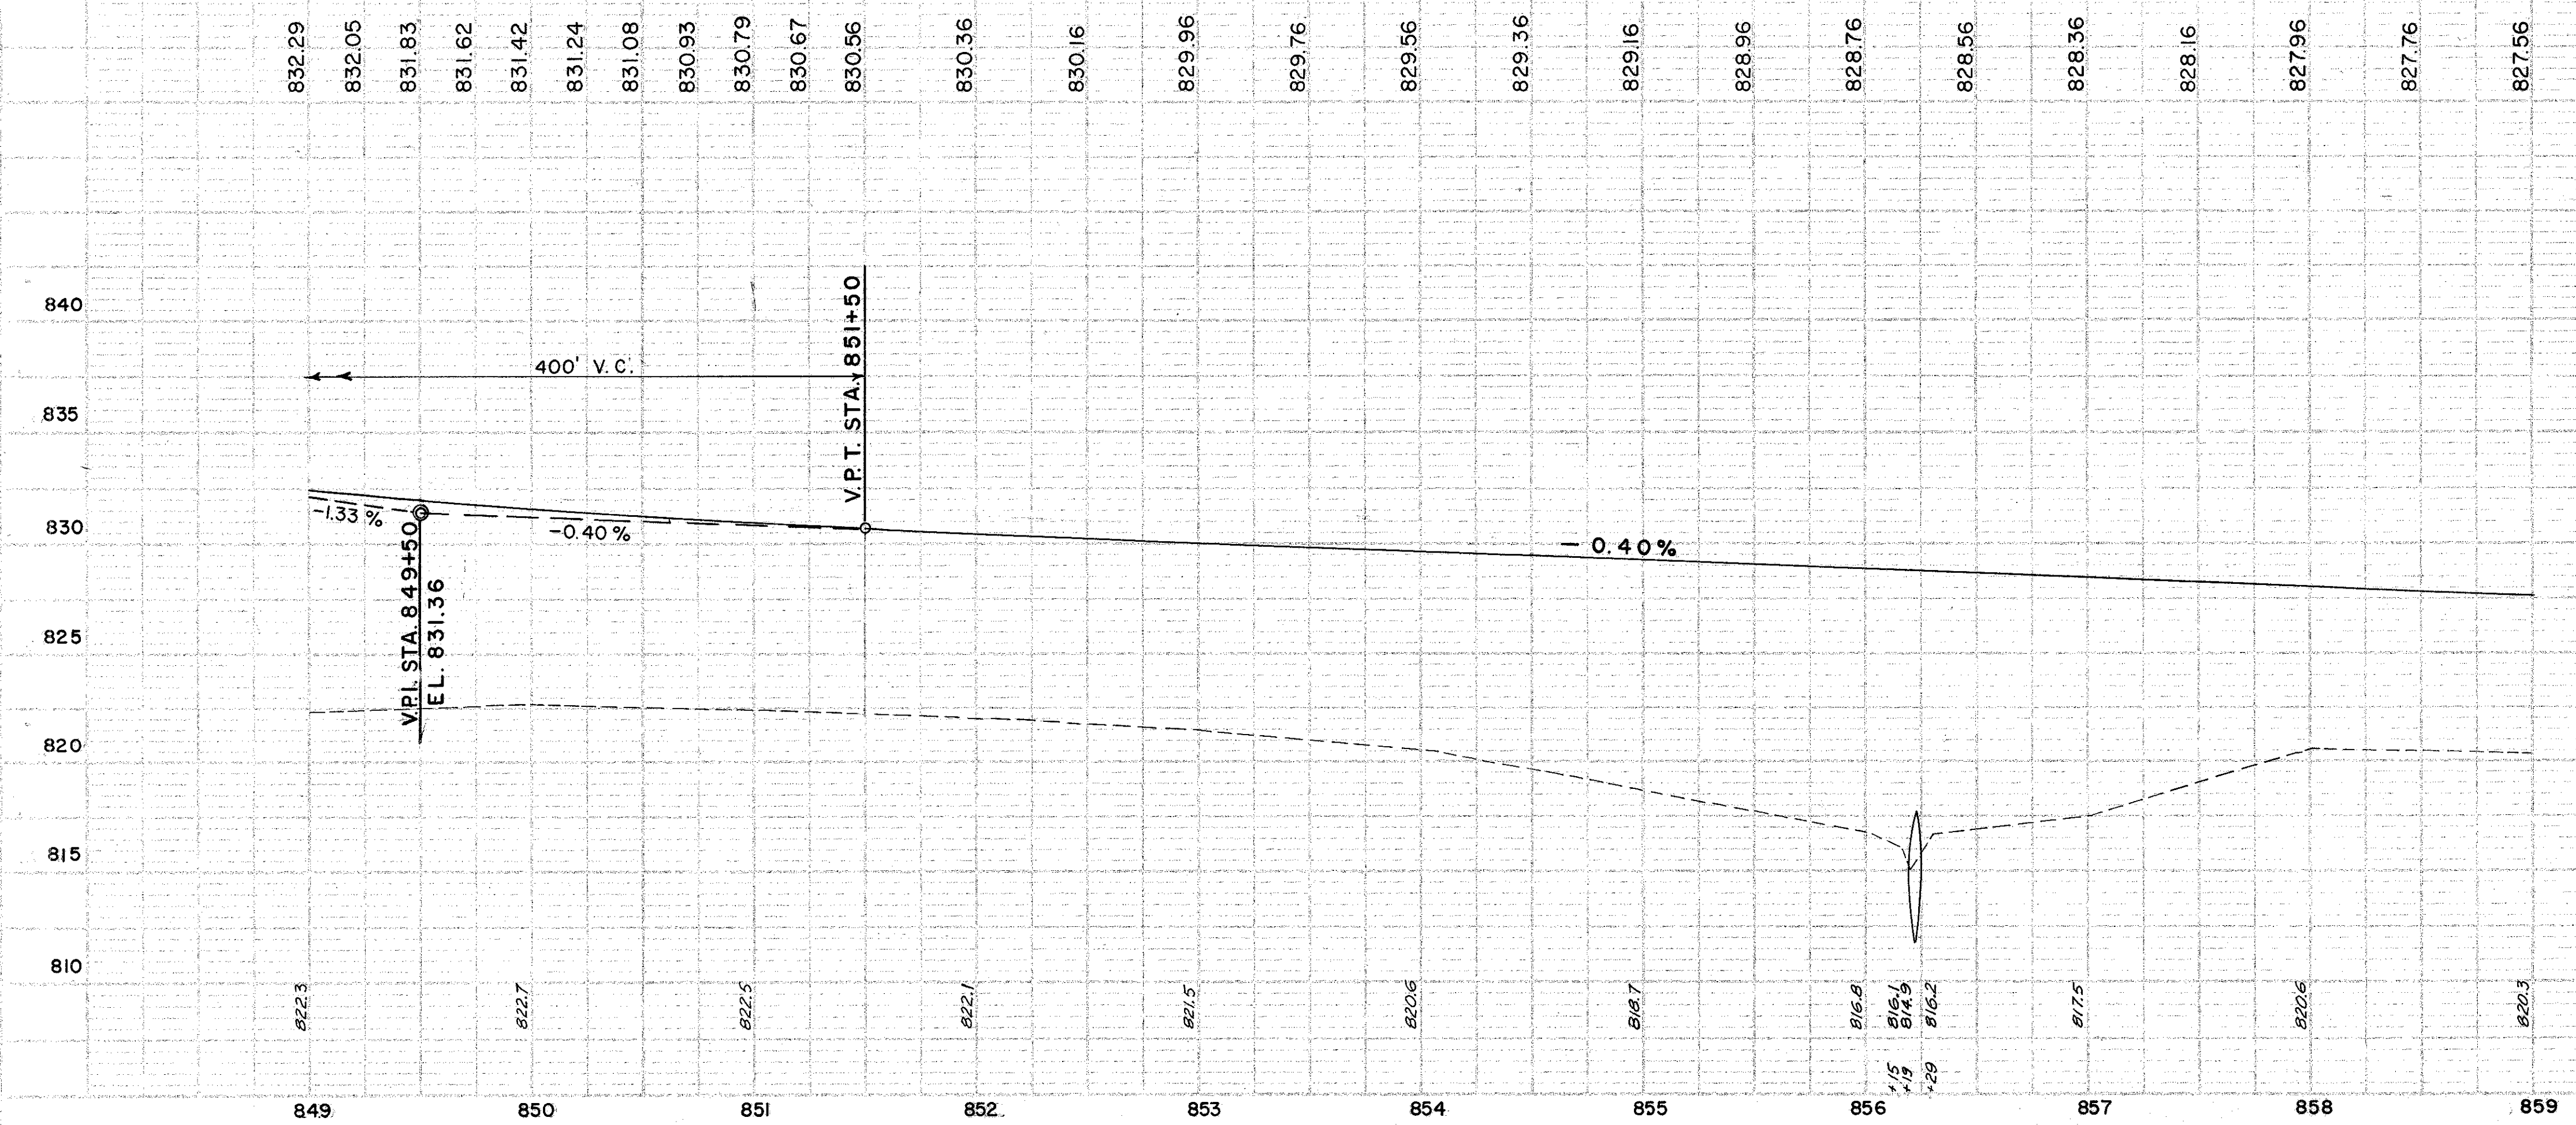

PLAN & PROFILE - STA. 849 + 00 TO STA. 859 + 00