


CUYAHOGA COUNTY  
CUY - 71 - 8.41

FOR PROFILE OF STORM SEWERS SEE SHEET 115  
FOR DRAINAGE QUANTITIES SEE SHEET 27-A  
FOR PAYMENT DETAILS SEE SHEETS 90, 94 TO 96  
FOR DELOC. OF WATER MAIN SEE WATER PLANS

SLM 8.72, 27"  
SEE SHEET 115

CFN 1972353  
SLM 8.84, 15"  
SEE SHEET 115


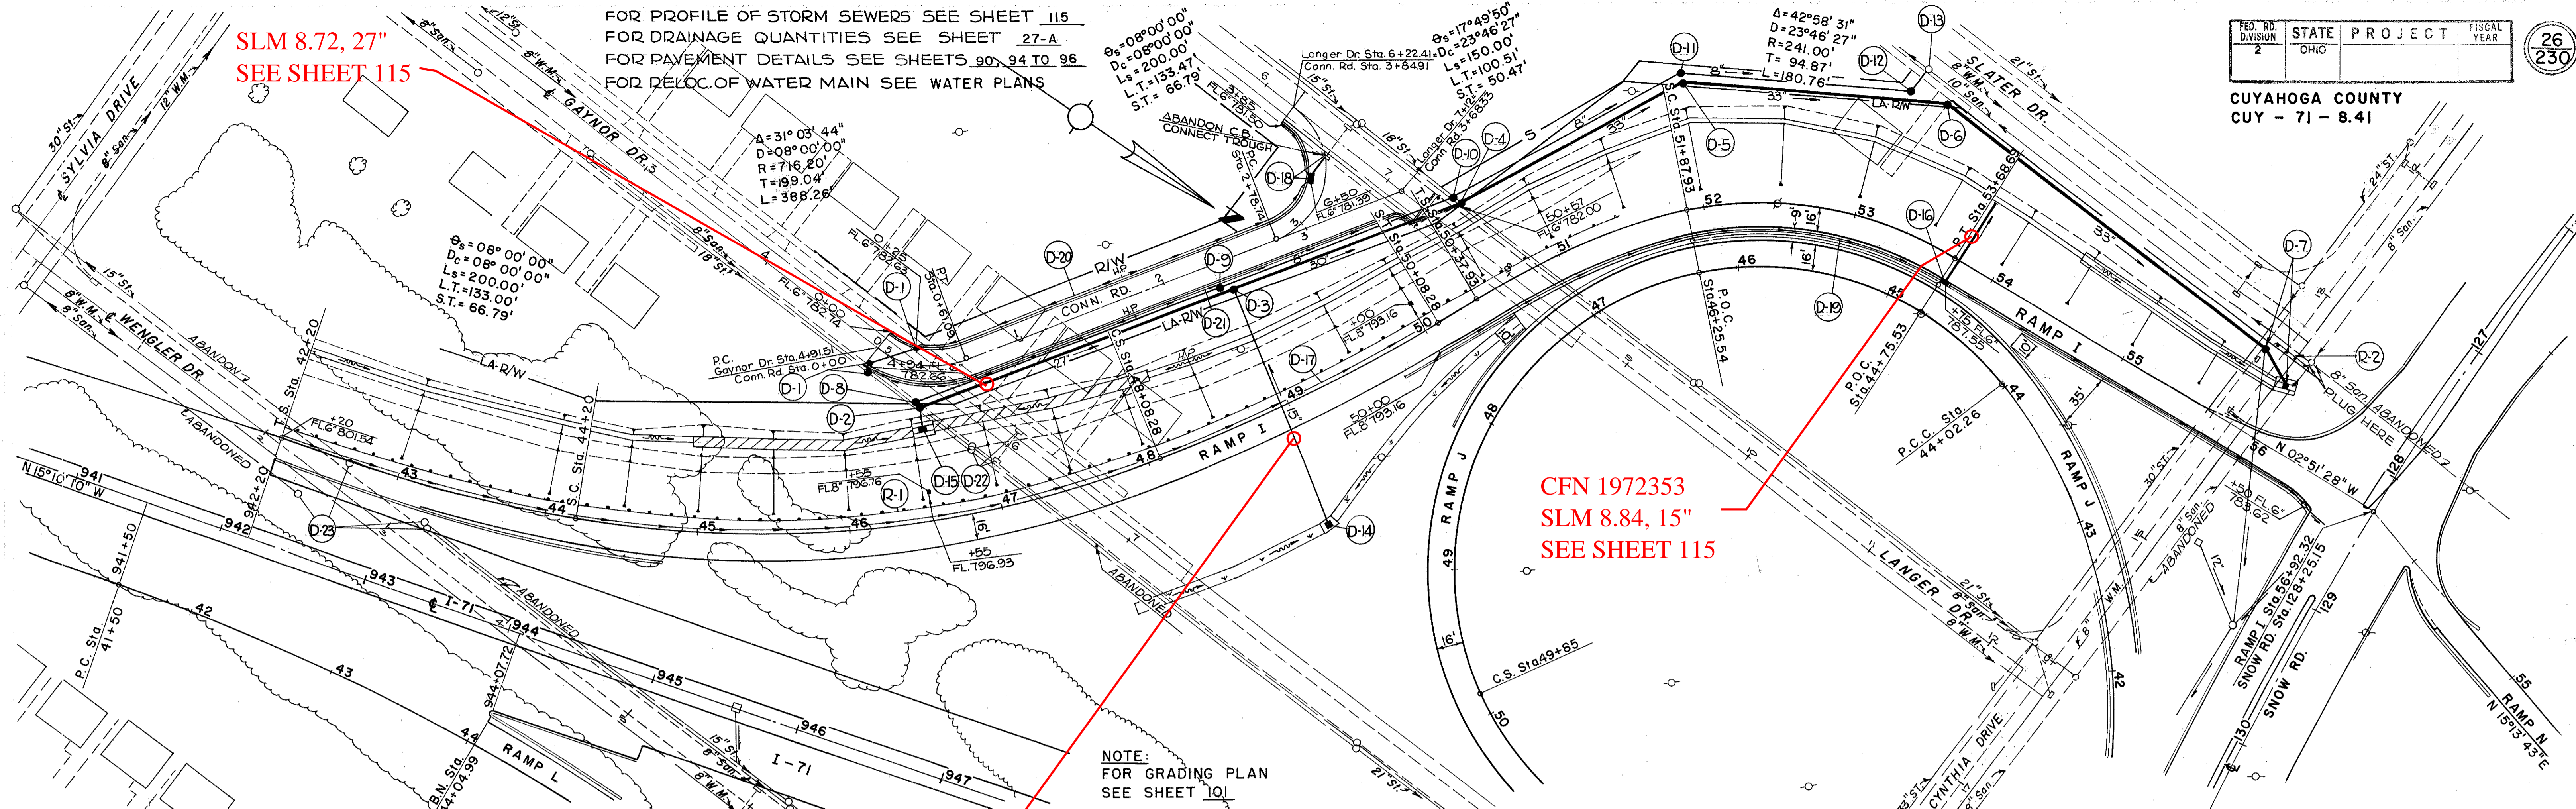


NOTE:  
FOR GRADING PLAN  
SEE SHEET 101

+20 805.94  
+25 805.91  
805.72  
805.51  
805.27  
805.01  
804.74  
804.19  
803.65  
803.10  
802.56  
802.01  
801.47  
800.92  
800.38  
799.83  
799.29  
798.74  
798.20  
797.65  
797.11  
796.56  
795.97  
795.30  
794.69  
793.87  
793.16  
792.44  
791.73  
791.01  
+35 790.51  
790.28  
789.85  
+85 789.66  
789.35  
788.79  
+35 788.55  
788.17  
+32 788.01  
787.11

CFN 1972352  
SLM 8.72, 15"  
SEE SHEET 115

RAMP	STATION		SIDE	I-15 GUARD RAIL STEEL BEAM (DEEP)	
	FROM	TO		STANDARD	LIN. FT.
R-1	42+20	52+00	LT.	980	
R-2	55+81	56+06	LT.	25	
POST SPACING		625			
TOTAL				1005	

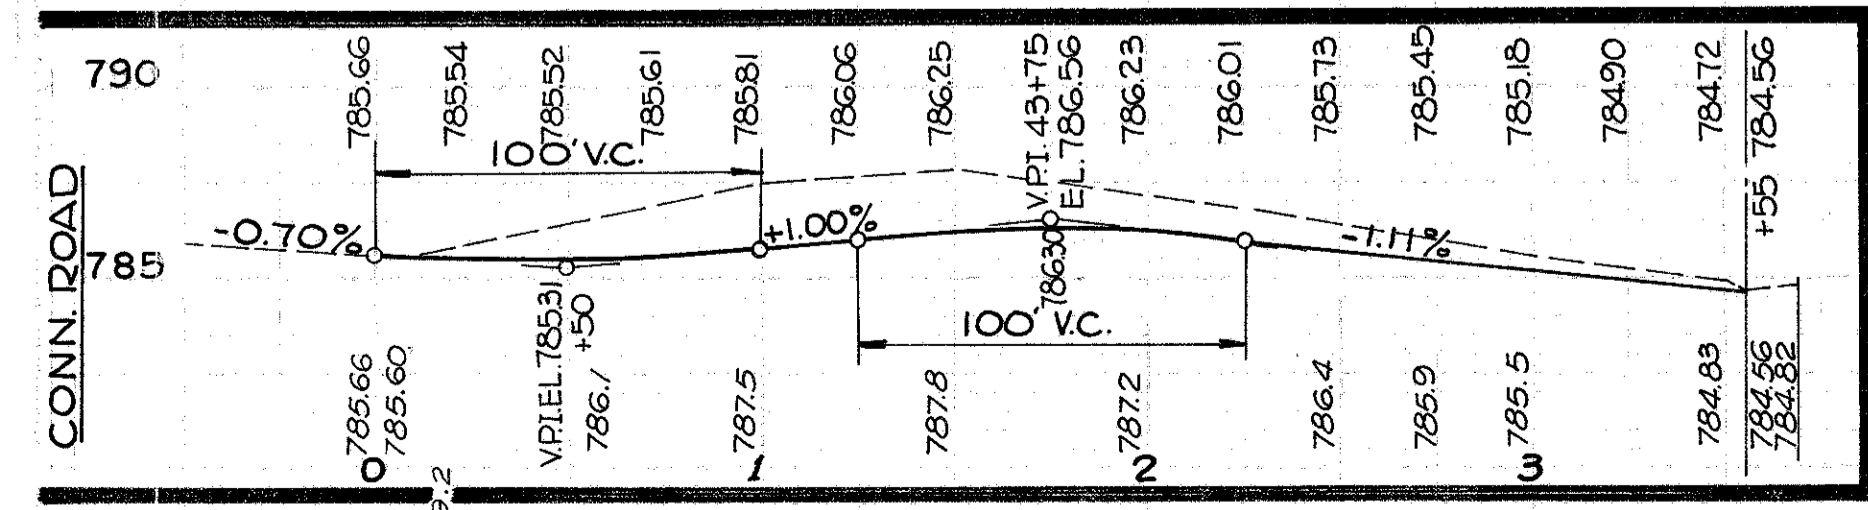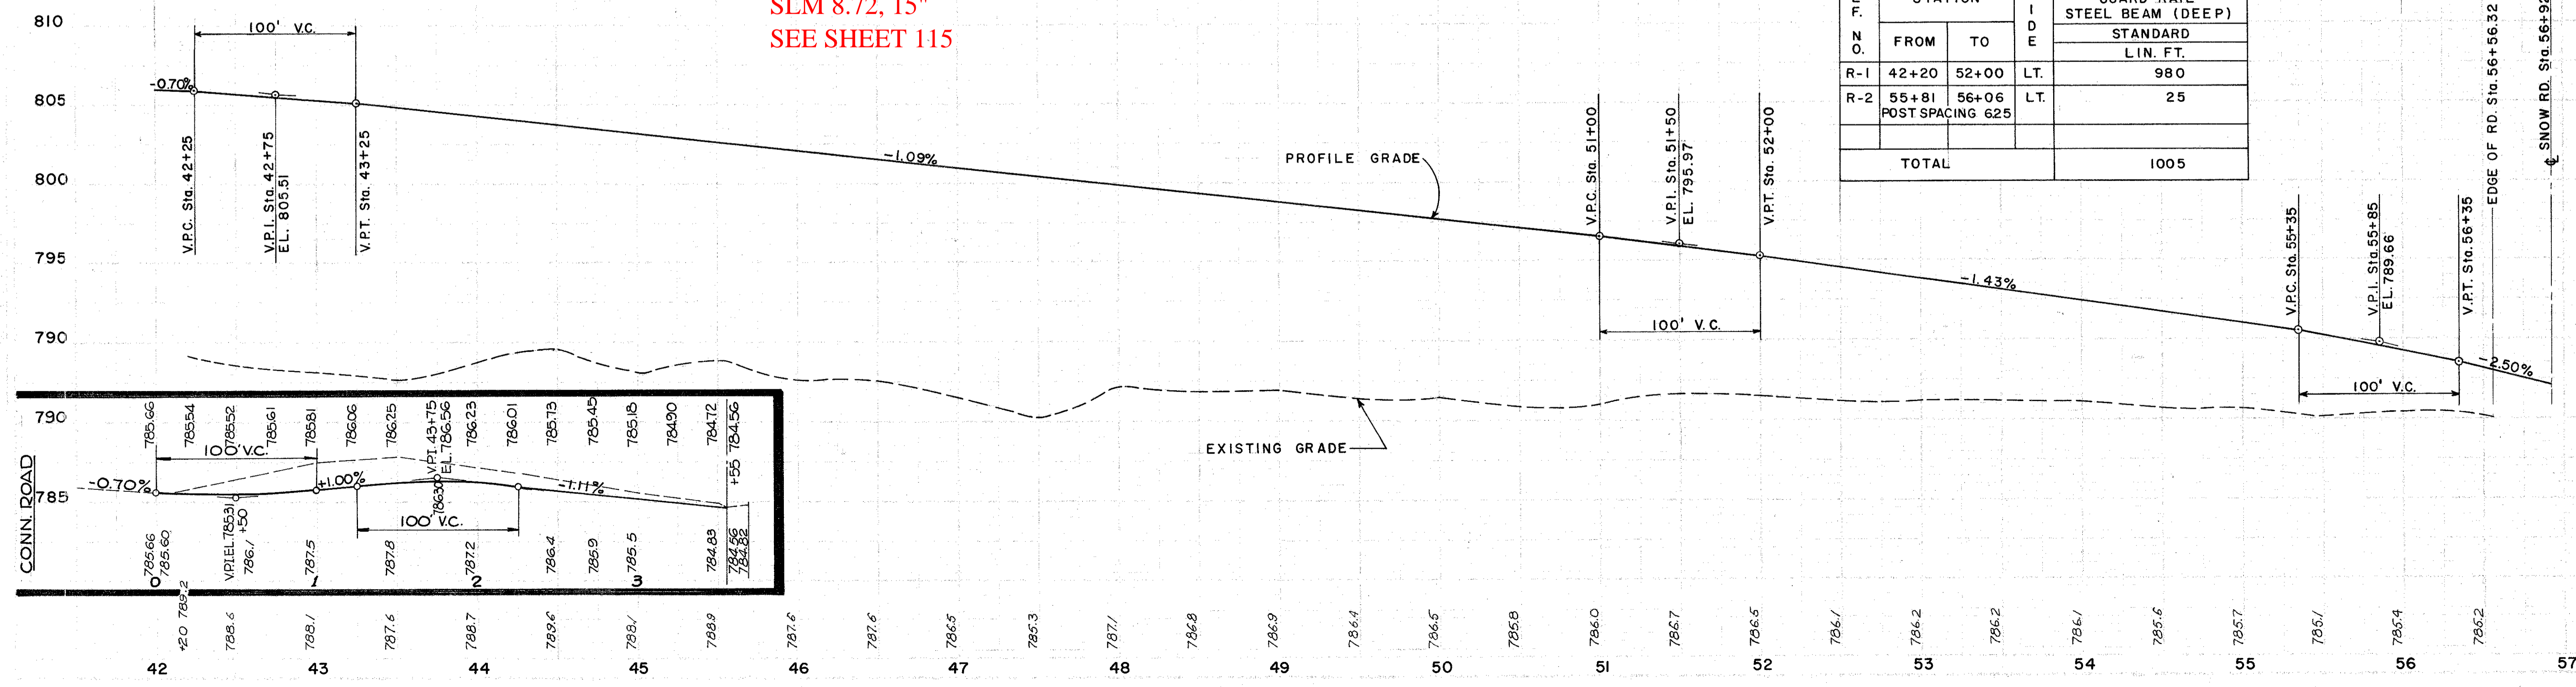

PLAN & PROFILE - RAMP "I"