


FED. RD. DIVISION	STATE	PROJECT
2	OHIO	

287
646

CUYAHOGA COUNTY
CUY-71-17.83
CUY-176-12.76

36
54

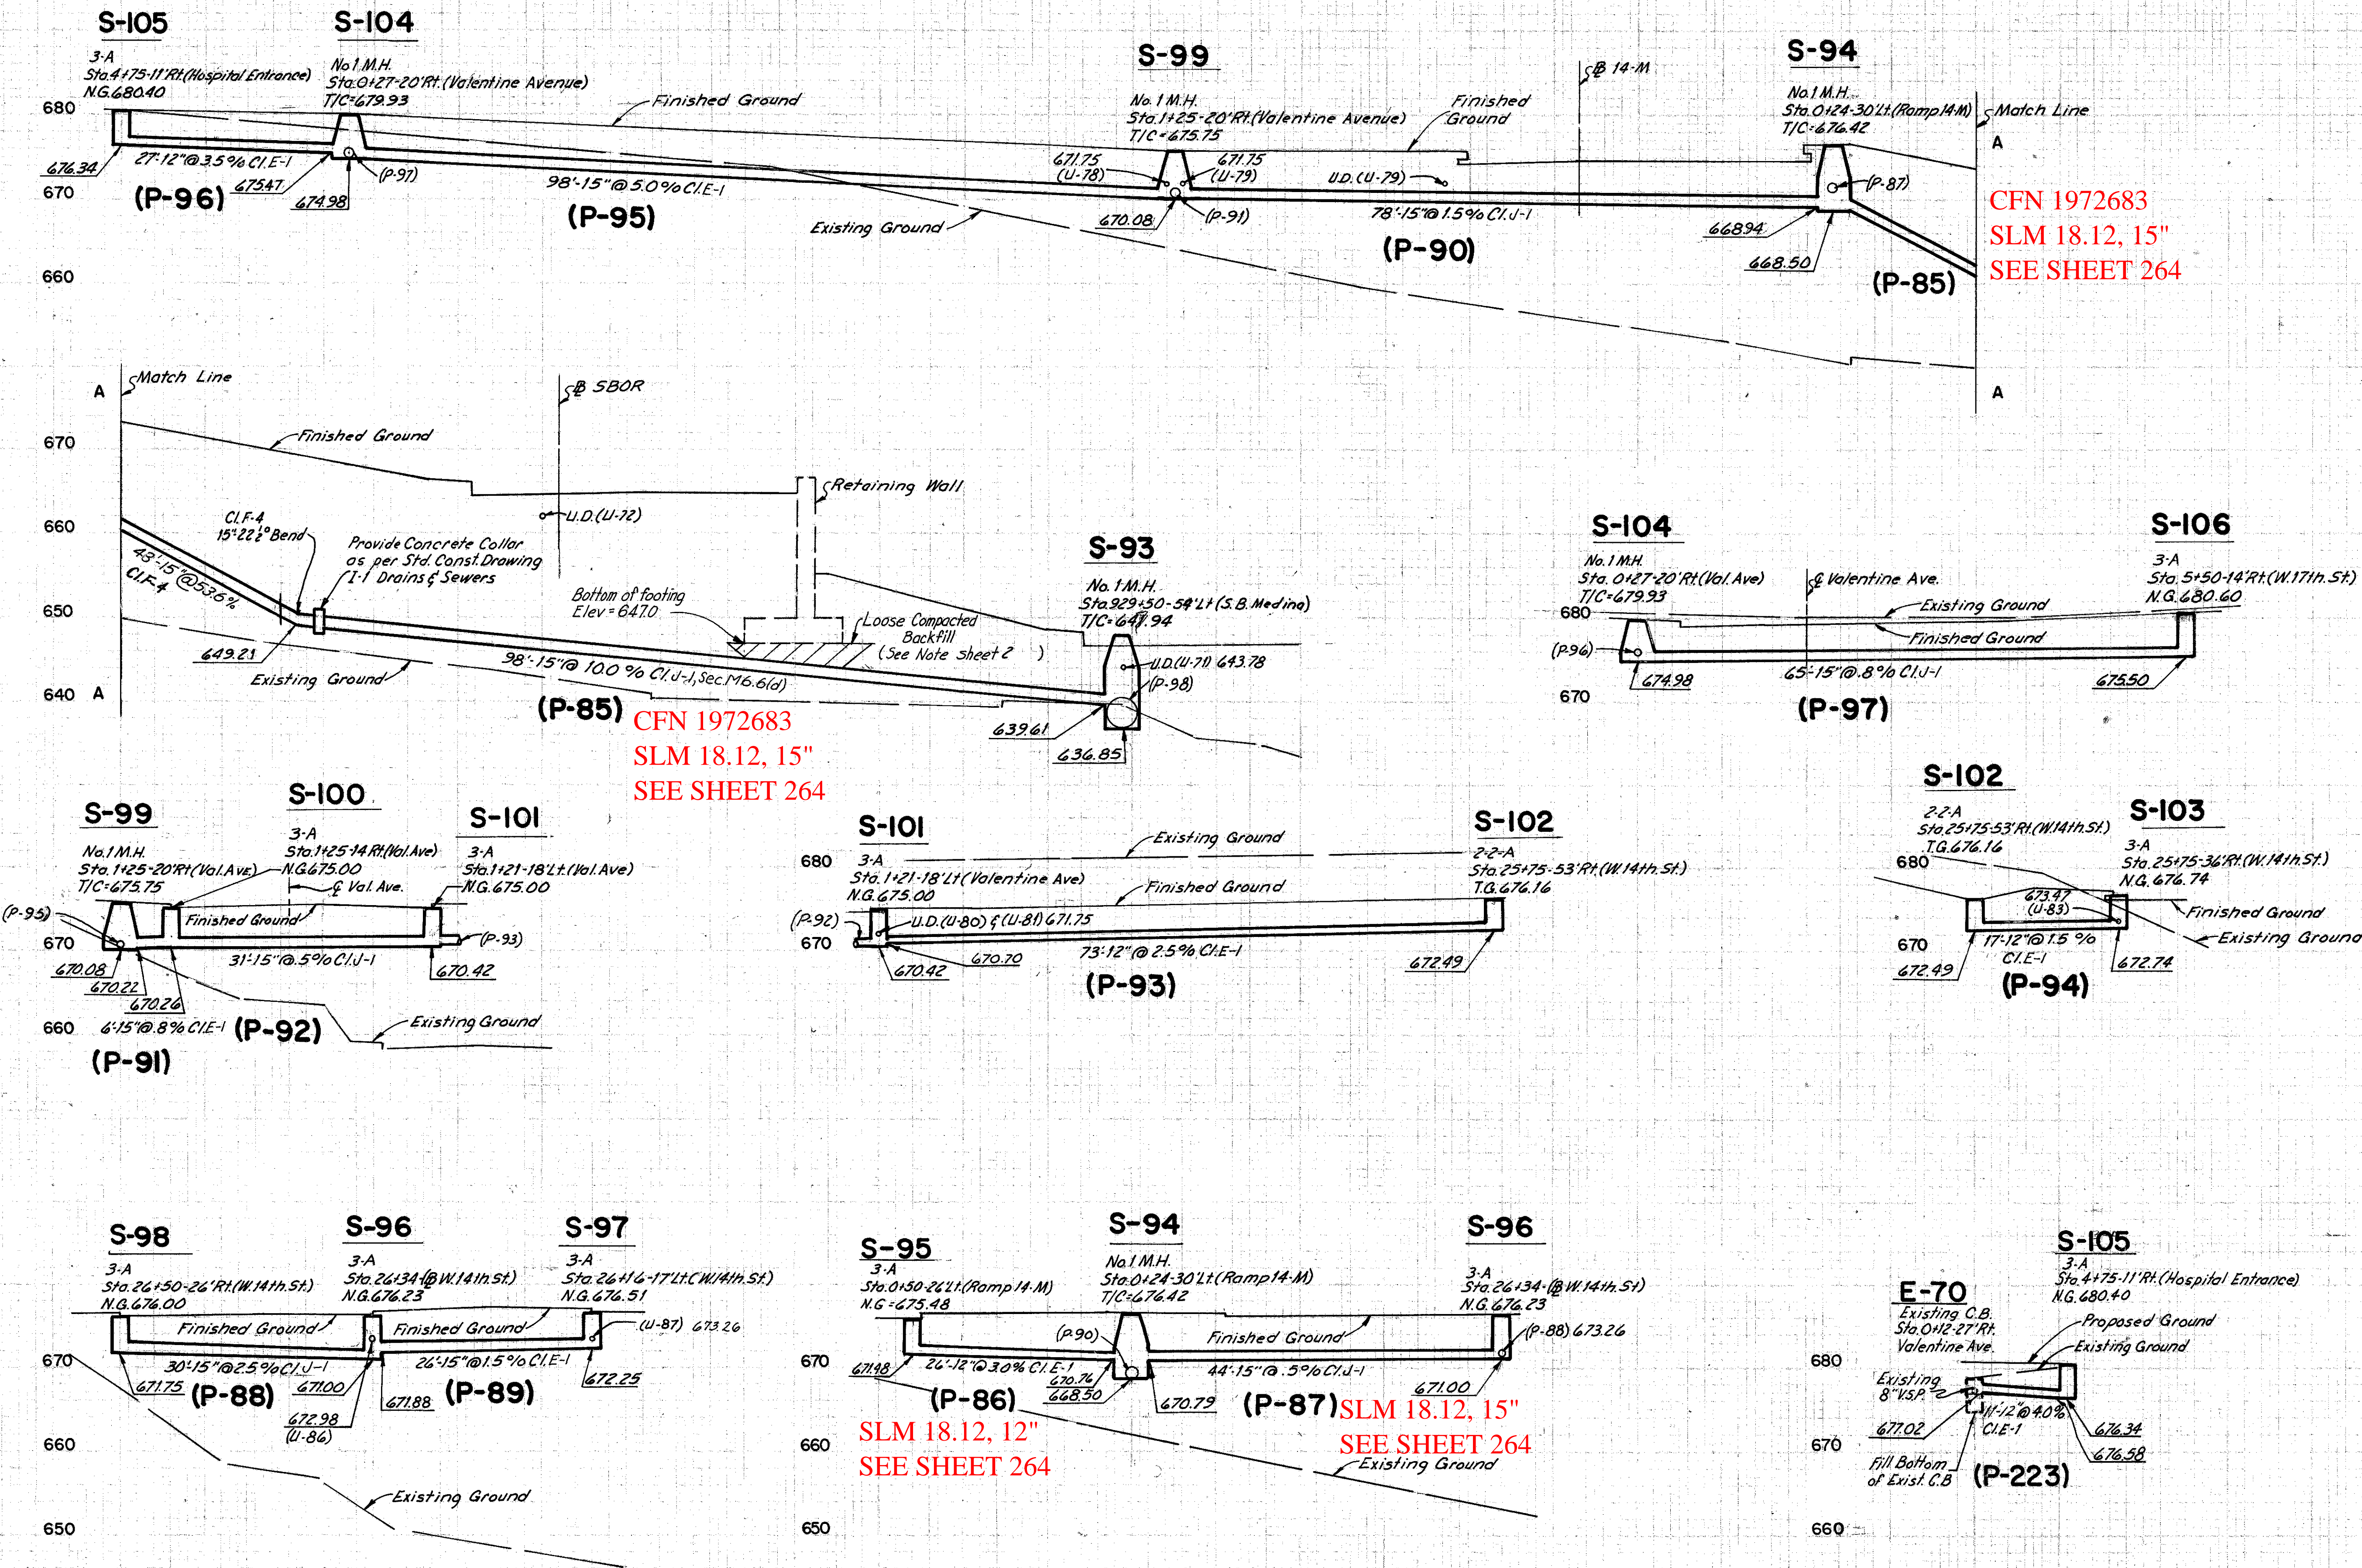

CFN 1972683
SLM 18.12, 15"
SEE SHEET 264

CFN 1972683
SLM 18.12, 15"
SEE SHEET 264

SLM 18.12, 12"
SEE SHEET 264

SLM 18.12, 15"
SEE SHEET 264

Scale 1"=10' Hor. & Vert.

R.D.J. 9-10-64
J.M.O. 10-23-64