


FED. RD. DIVISION	STATE	PROJECT	
2	OHIO		

72
163

CUYAHOGA COUNTY
CUY-71-9.60

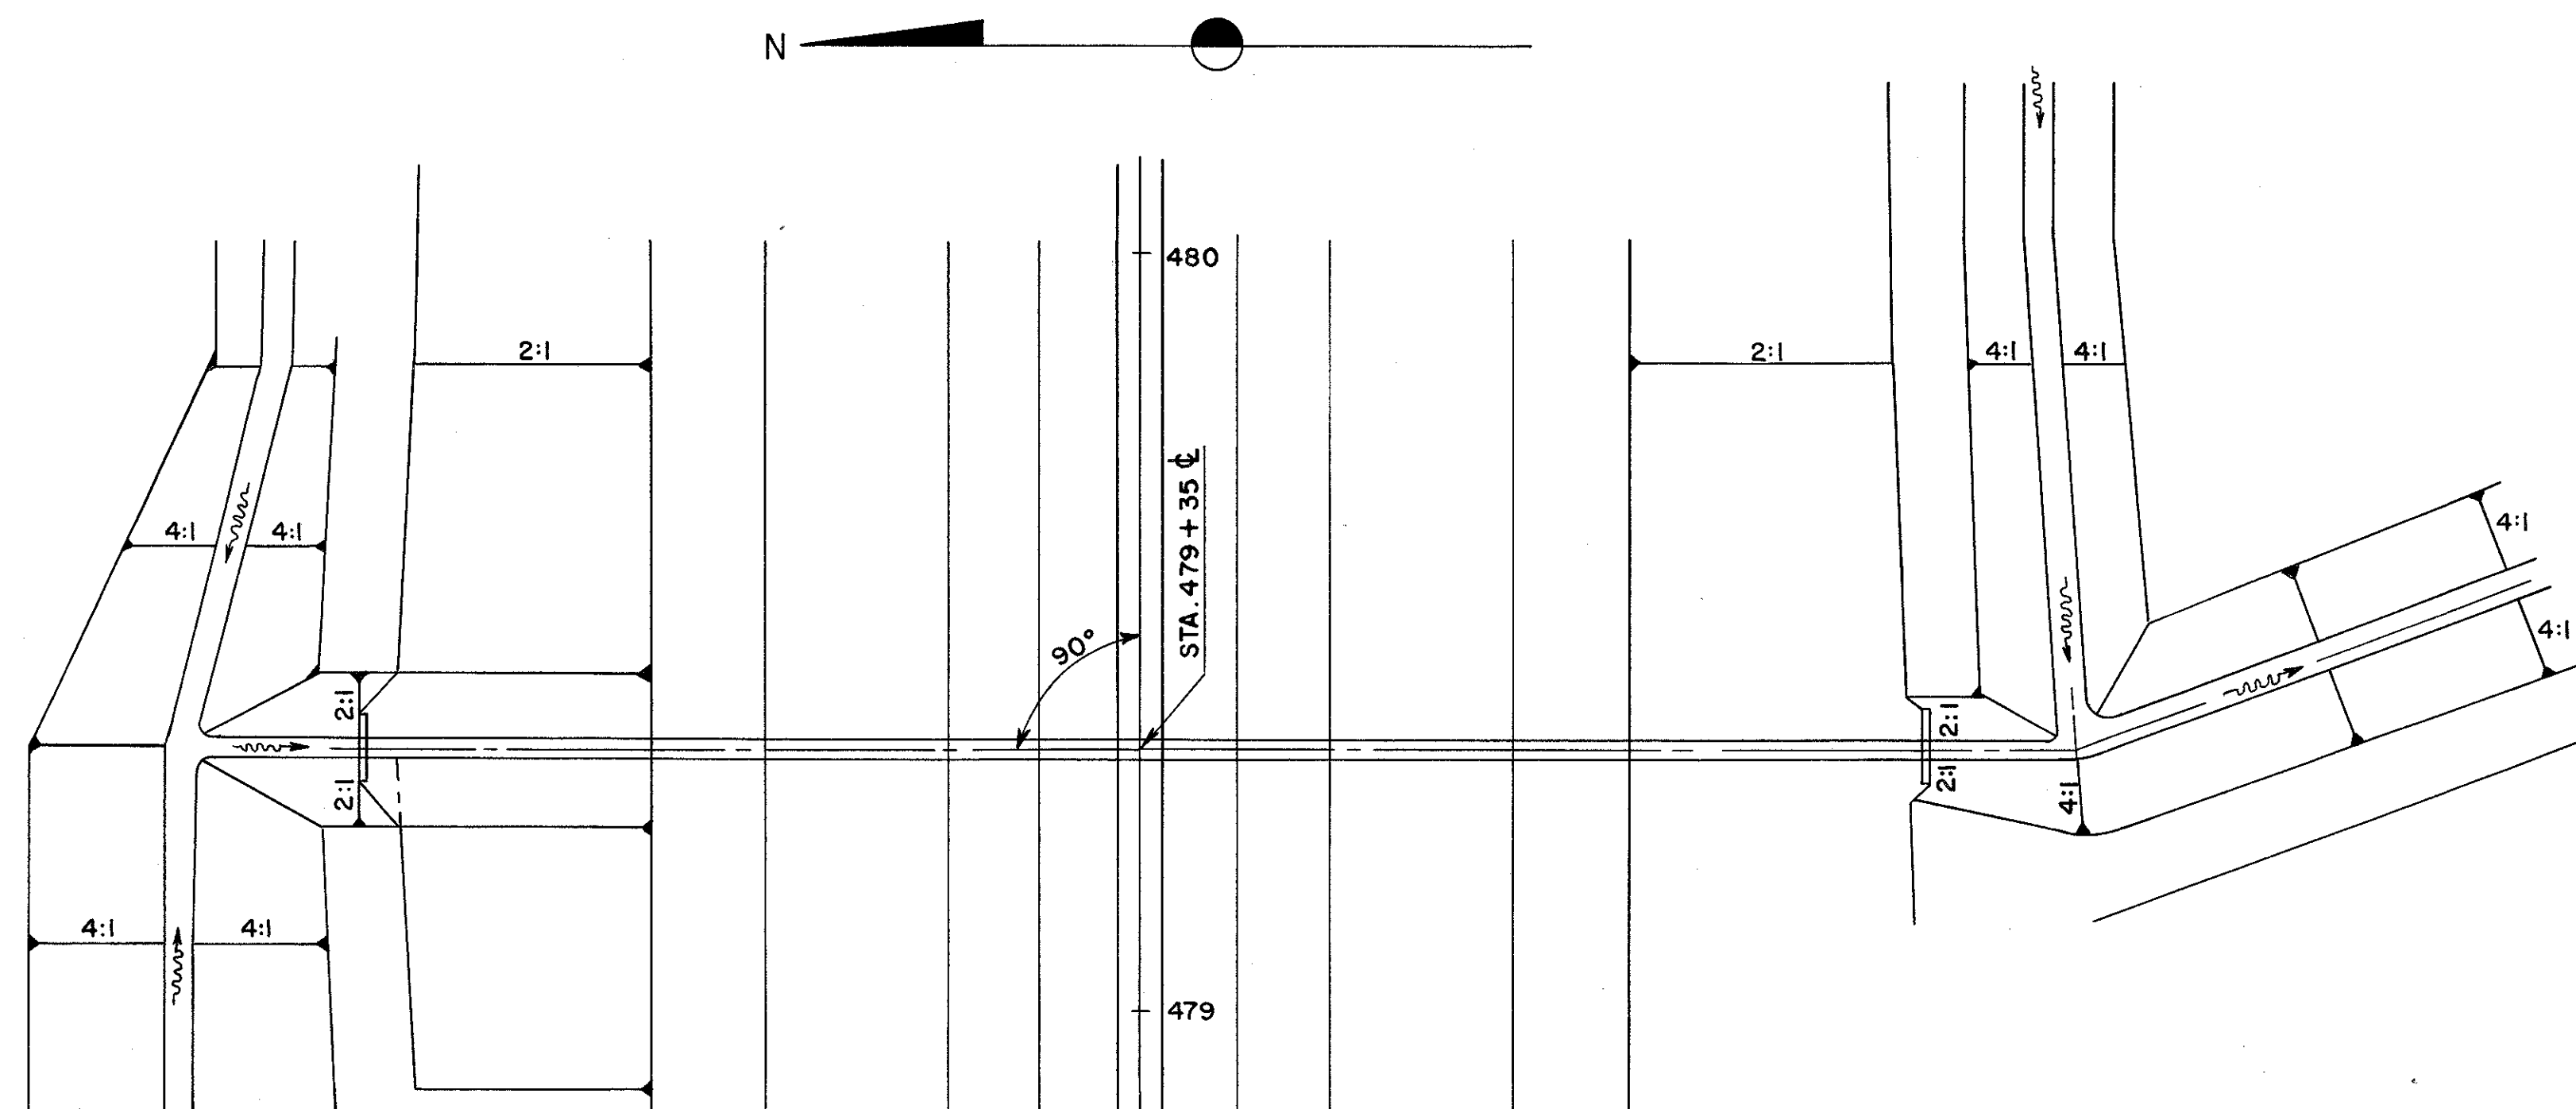

DRAINAGE AREA - A = 4.8 ACRES
DISCHARGE - Q₅₀ = 12.7 ACRES

* (D-1) CULVERT DATA (P/P SHEET N^o 24)


TYPE - CLASS A-1
SEC. M-6.6 (d)
SIZE - 21"

ESTIMATED QUANTITIES

E-3 CHANNEL EXCAVATION - 8 C.Y.
I-1 PIPE - 206 LIN. FT.
I-2 MASONRY (TWO HEADWALLS N^o-1A) - 3.6 C.Y.
L-10 SODDING - 4 S.Y.

old CFN 184800860
new CFN 1884805
SLM 8.60, 21"
SEE SHEET 24

PLAN

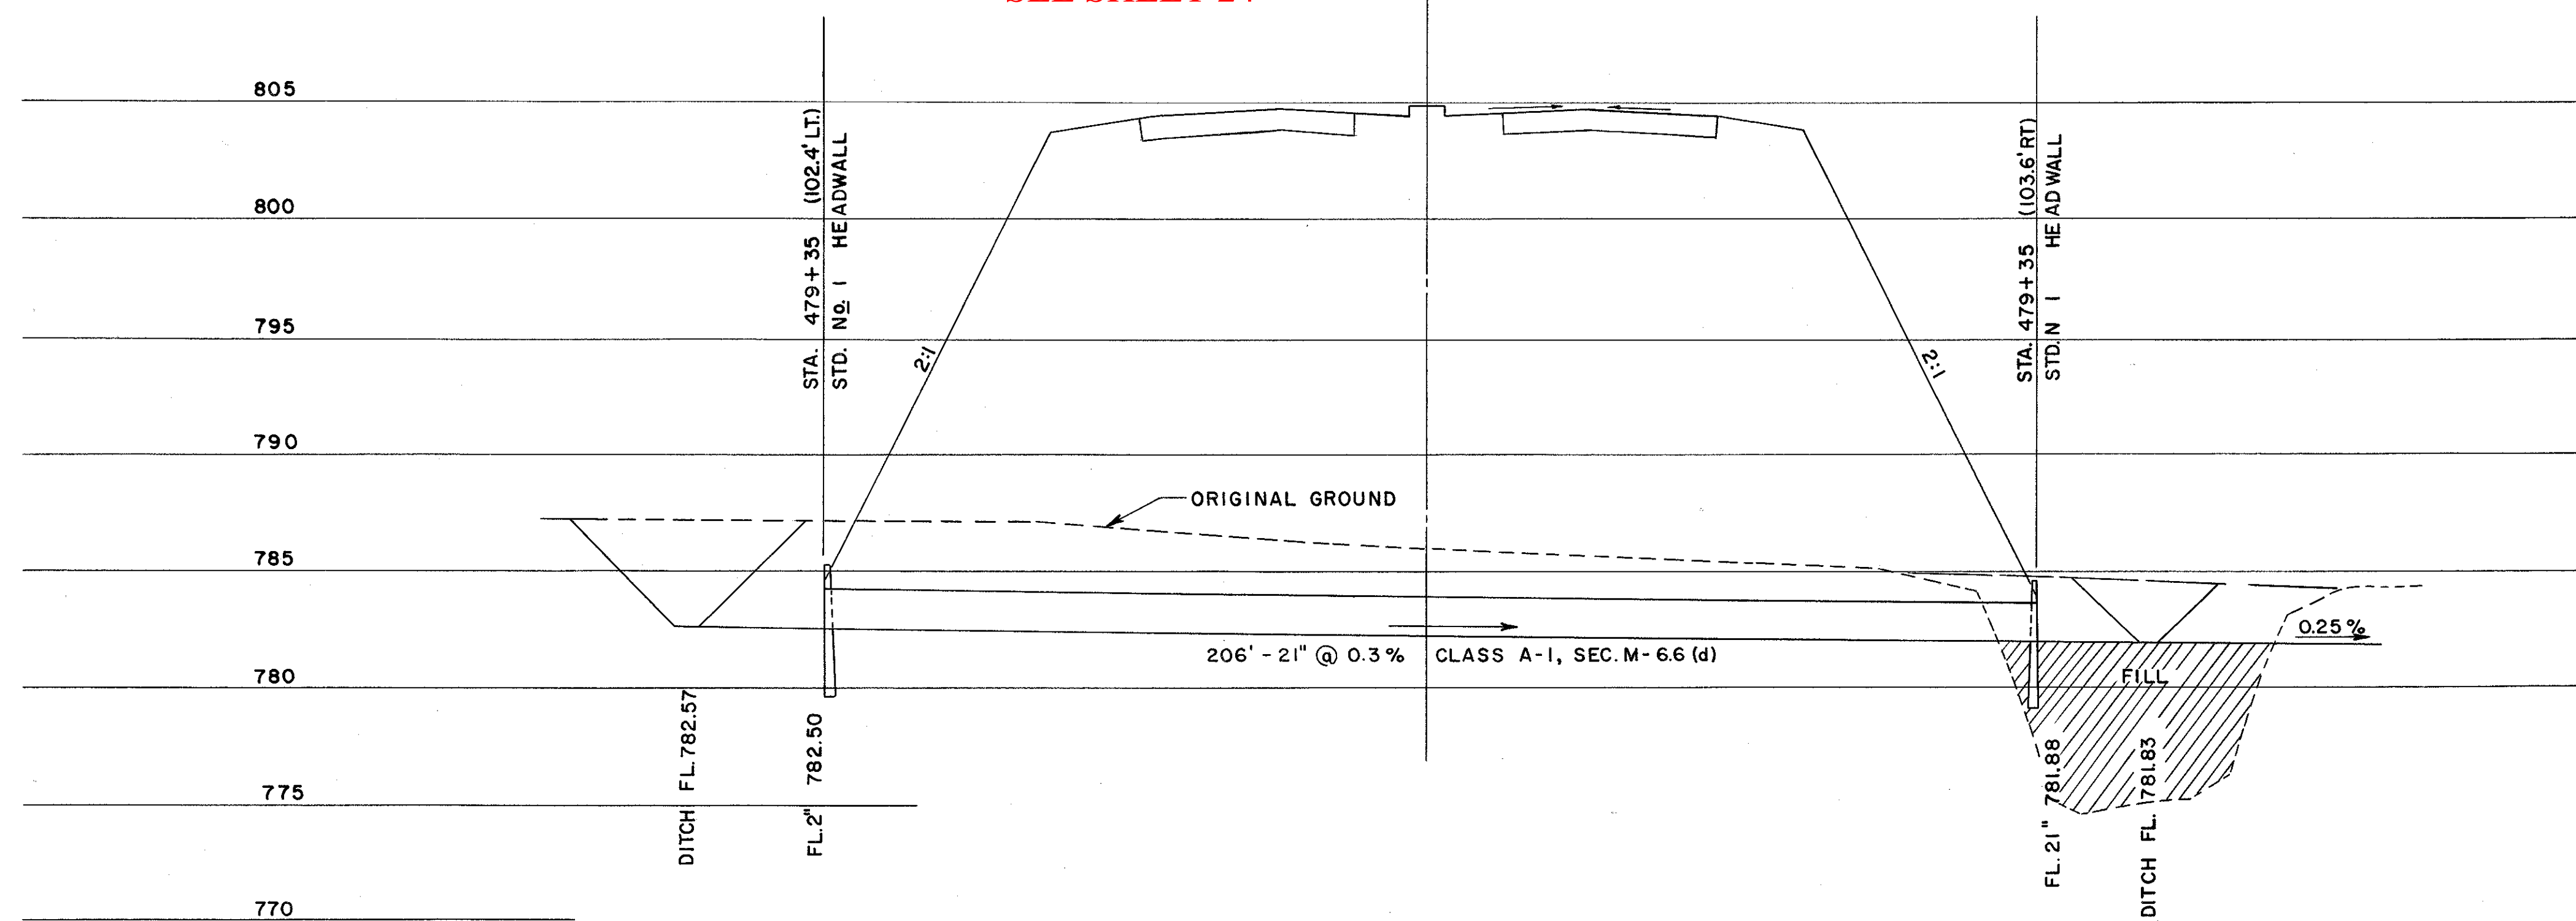

PACE ASSOCIATES OF OHIO
4500 EUCLID AVE. CLEVELAND 3, OHIO

IR-71
CULVERT ACROSS I-80
TO STA. 479 + 35

SCALE		DATE				
DESIGNED	DRAWN	TRACED	CHECKED	REVIEWED	DATE	REVISED