
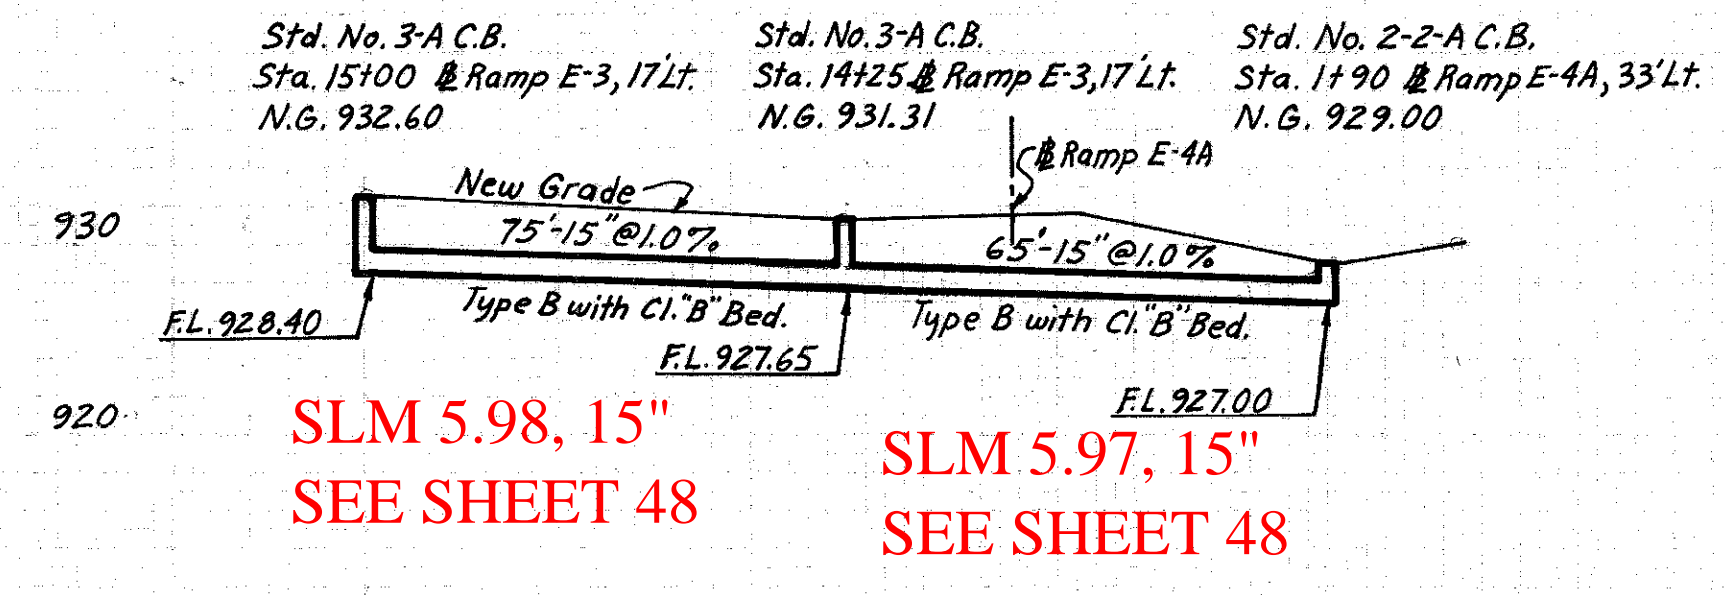
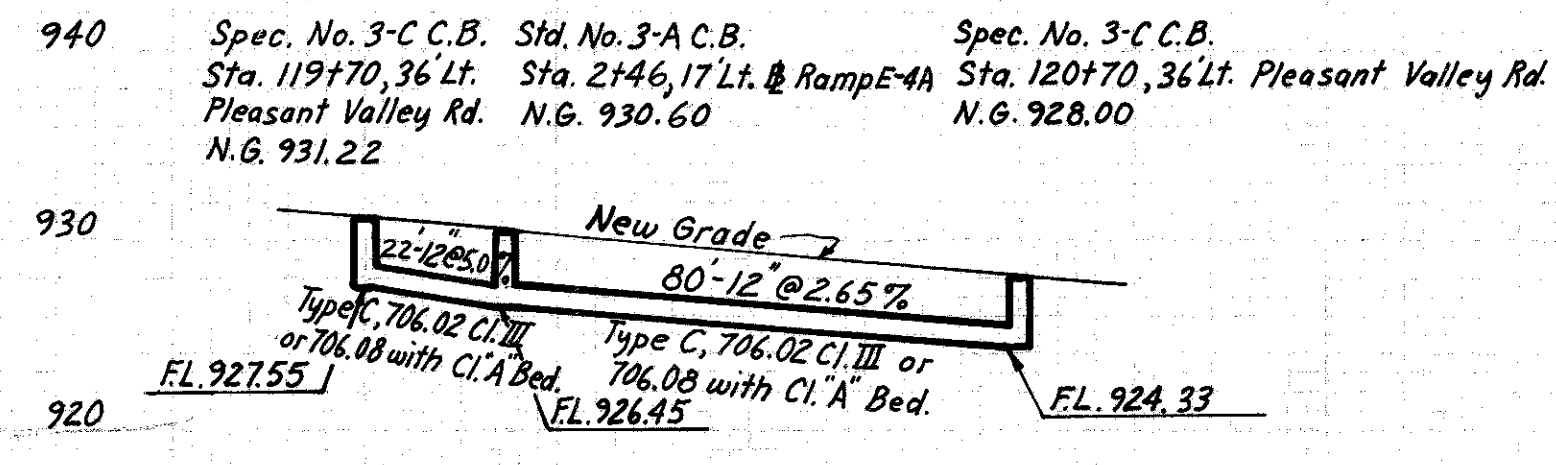
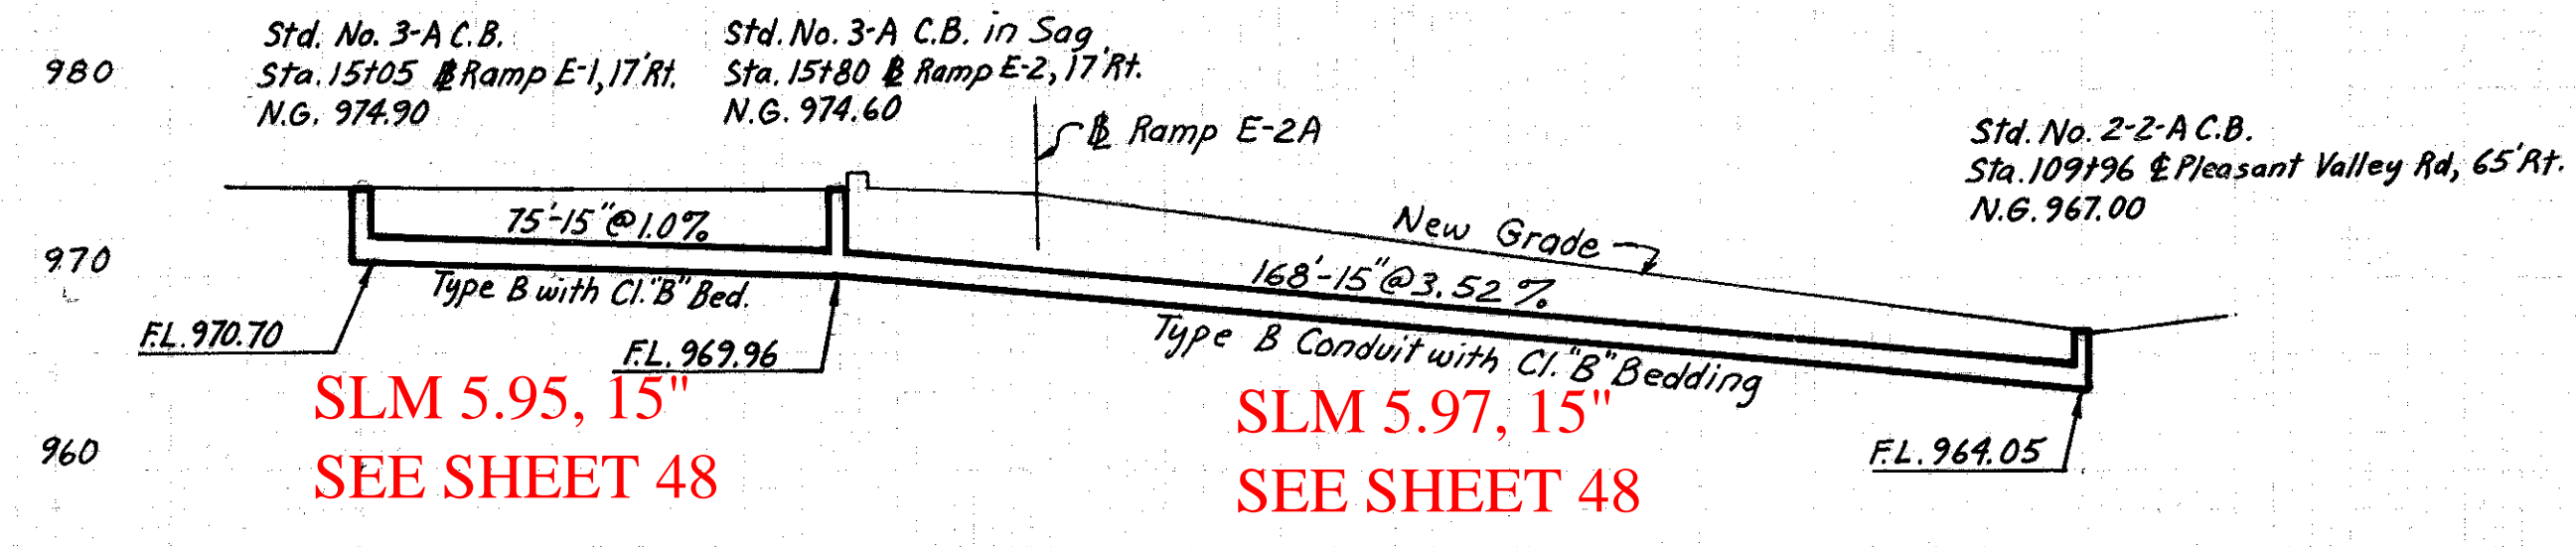


01-N

FED. RD. DIVISION	STATE	PROJECT	
2	OHIO		

247
382

CUYAHOGA COUNTY
CUY-77-4.07

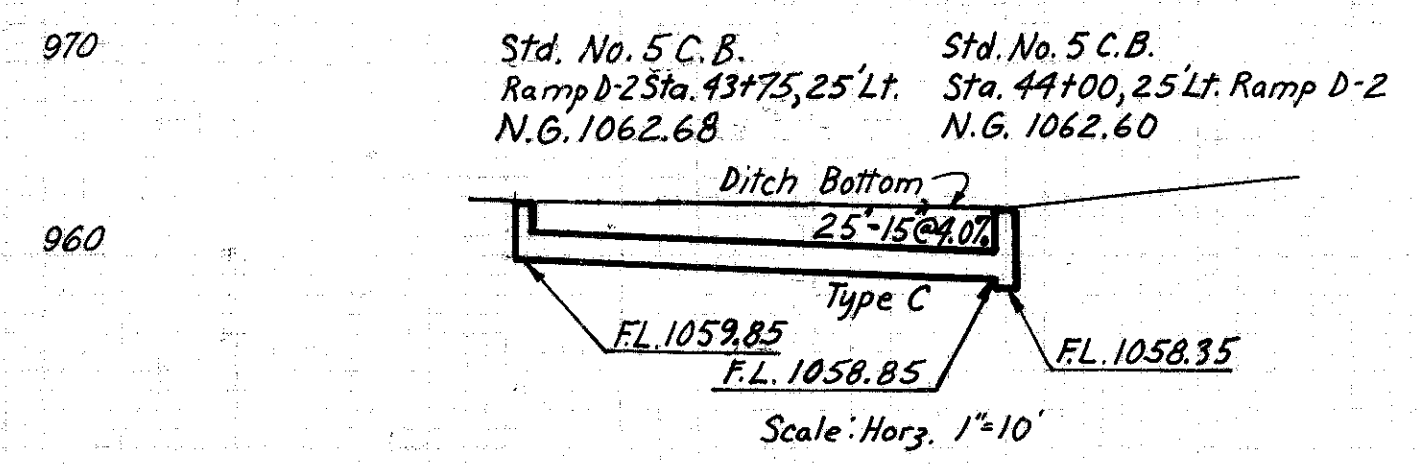

Scale : 1" = 30' Horz.
1" = 10' Vert.