
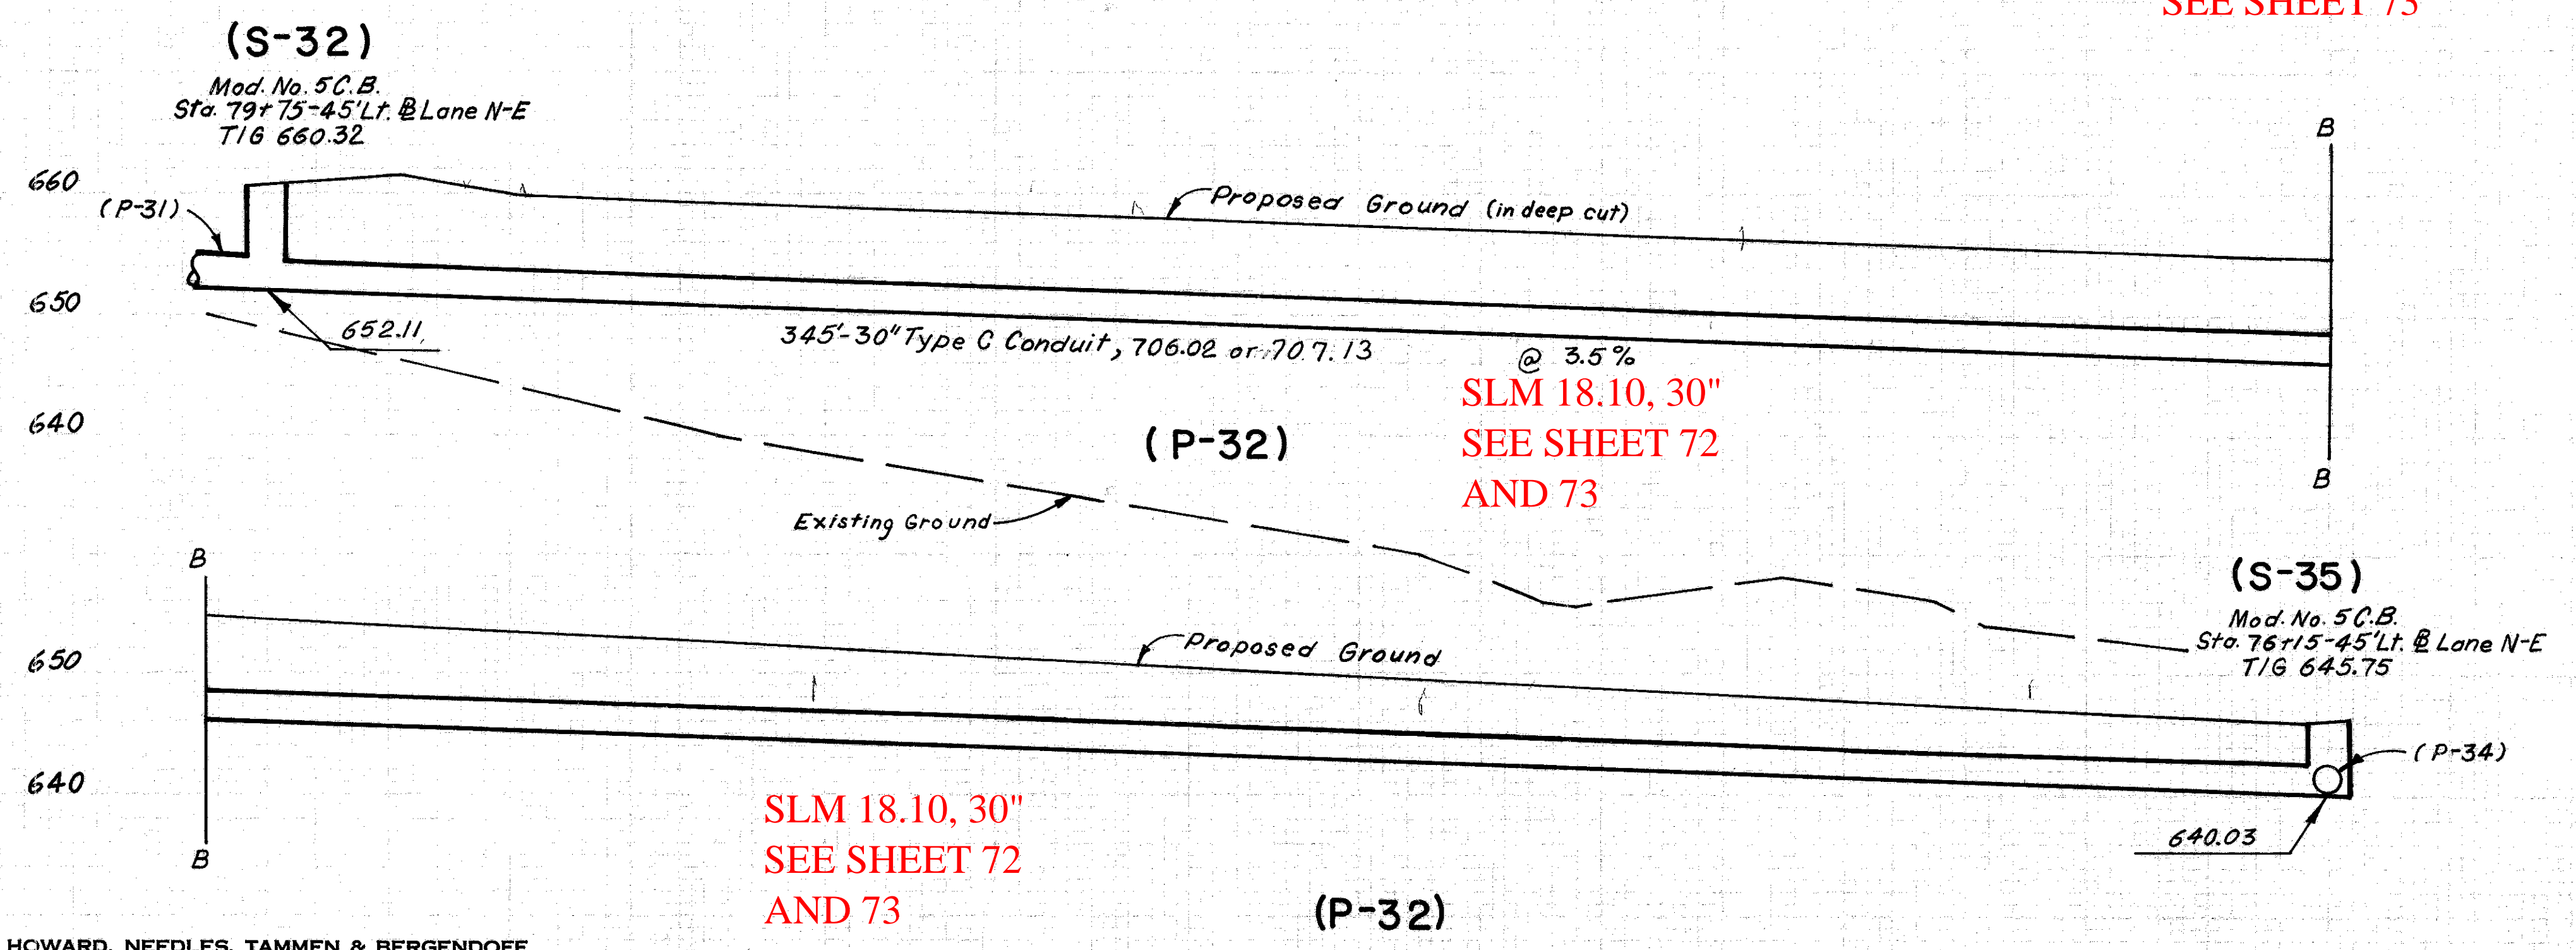
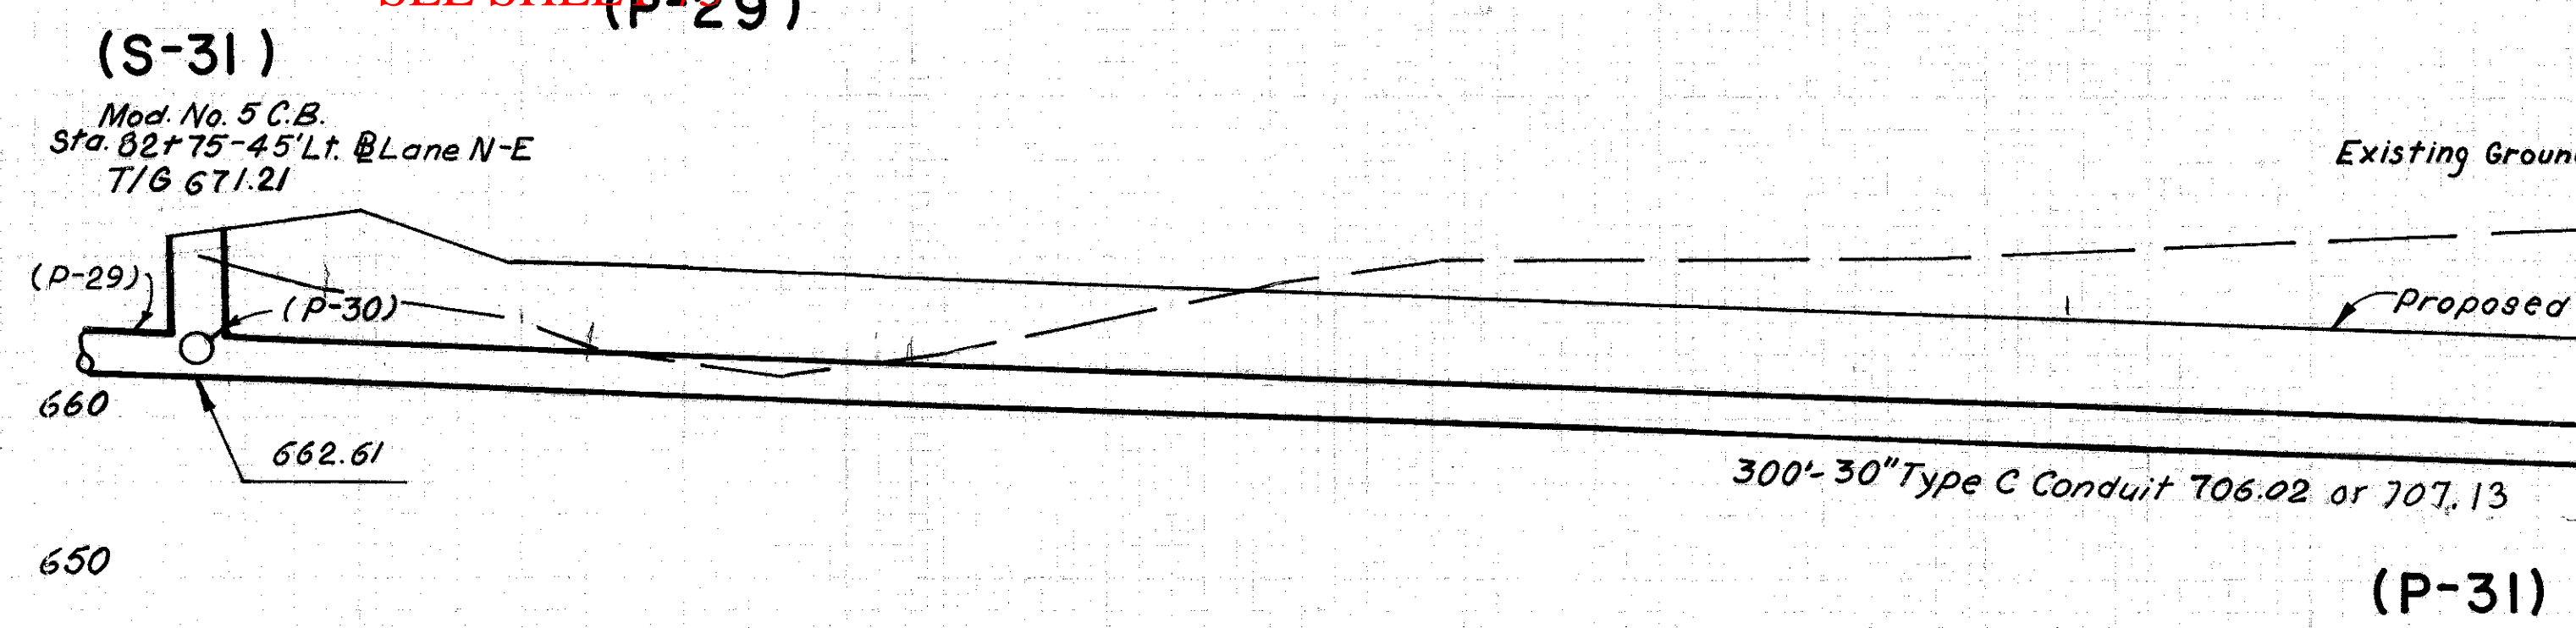
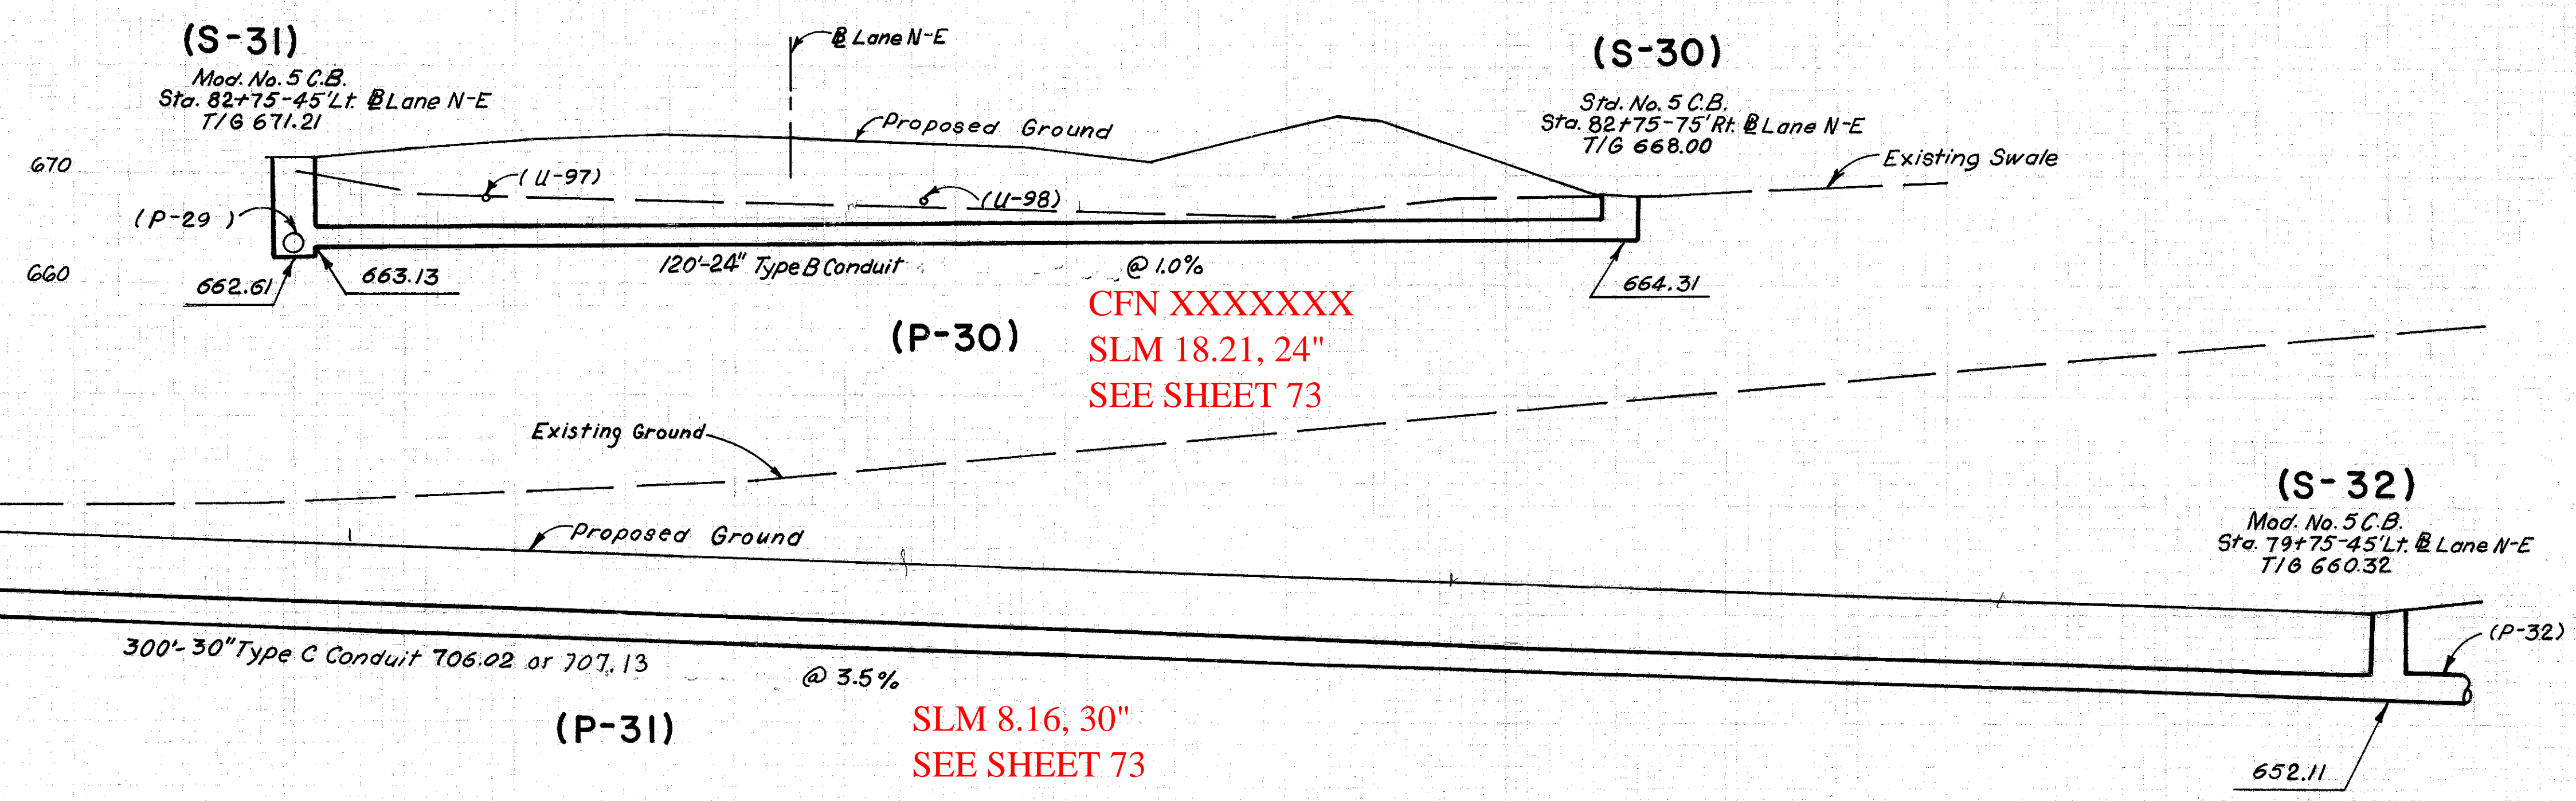
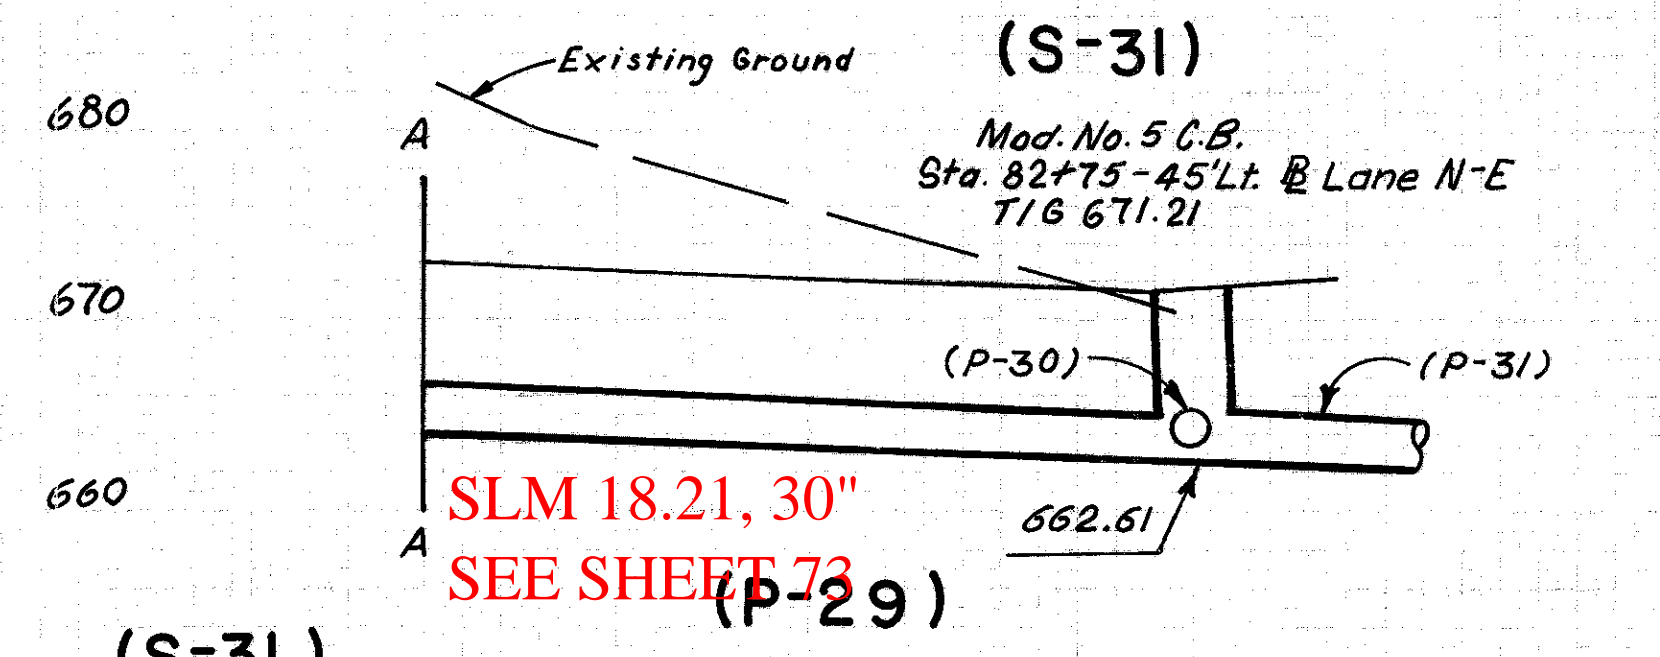


FED. RD. DIVISION	STATE	PROJECT	
2	OHIO		

83  
410

CUYAHOGA COUNTY  
CUY - 77 - 8.69  
CUY - 80 - 17.37

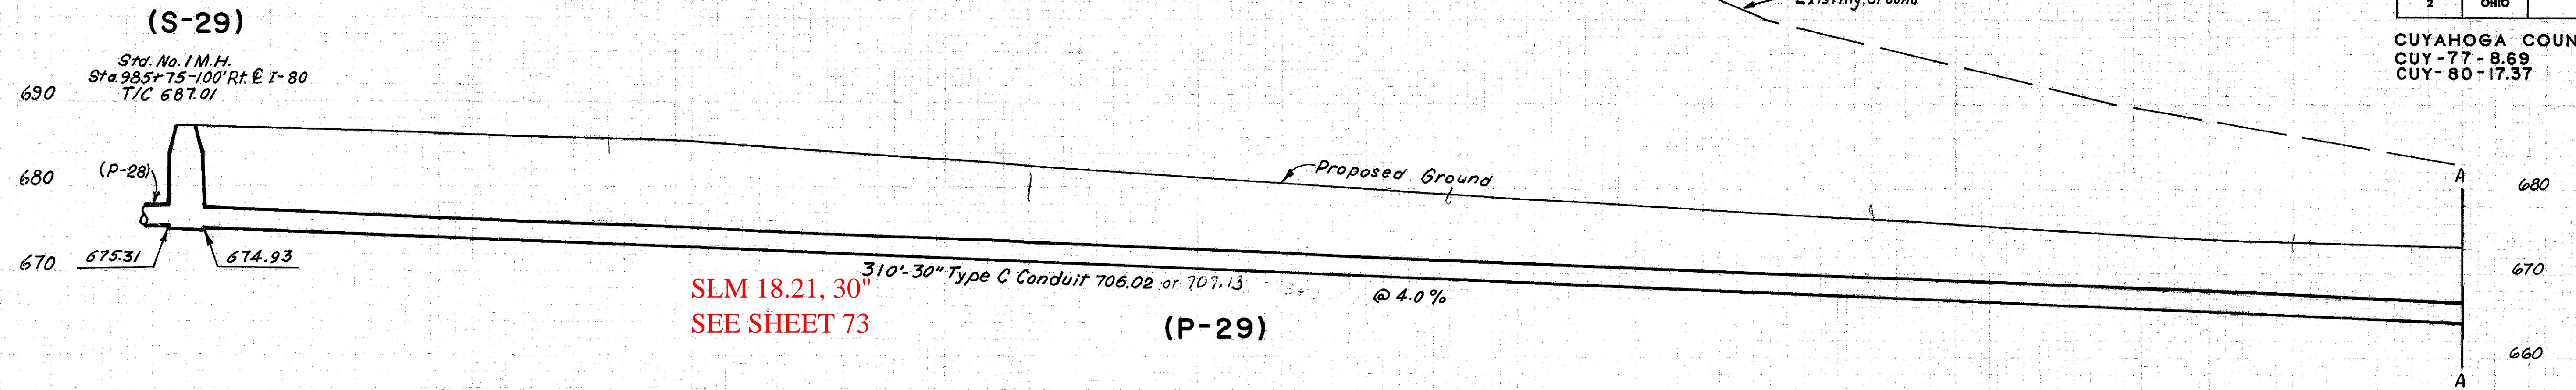

HOWARD, NEEDLES, TAMMEN & BERGENDOFF  
CONSULTING ENGINEERS  
KANSAS CITY CLEVELAND NEW YORK