


**MEDIAN INLET WAS INSTALLED
 UNDER CUY-480-6.78**

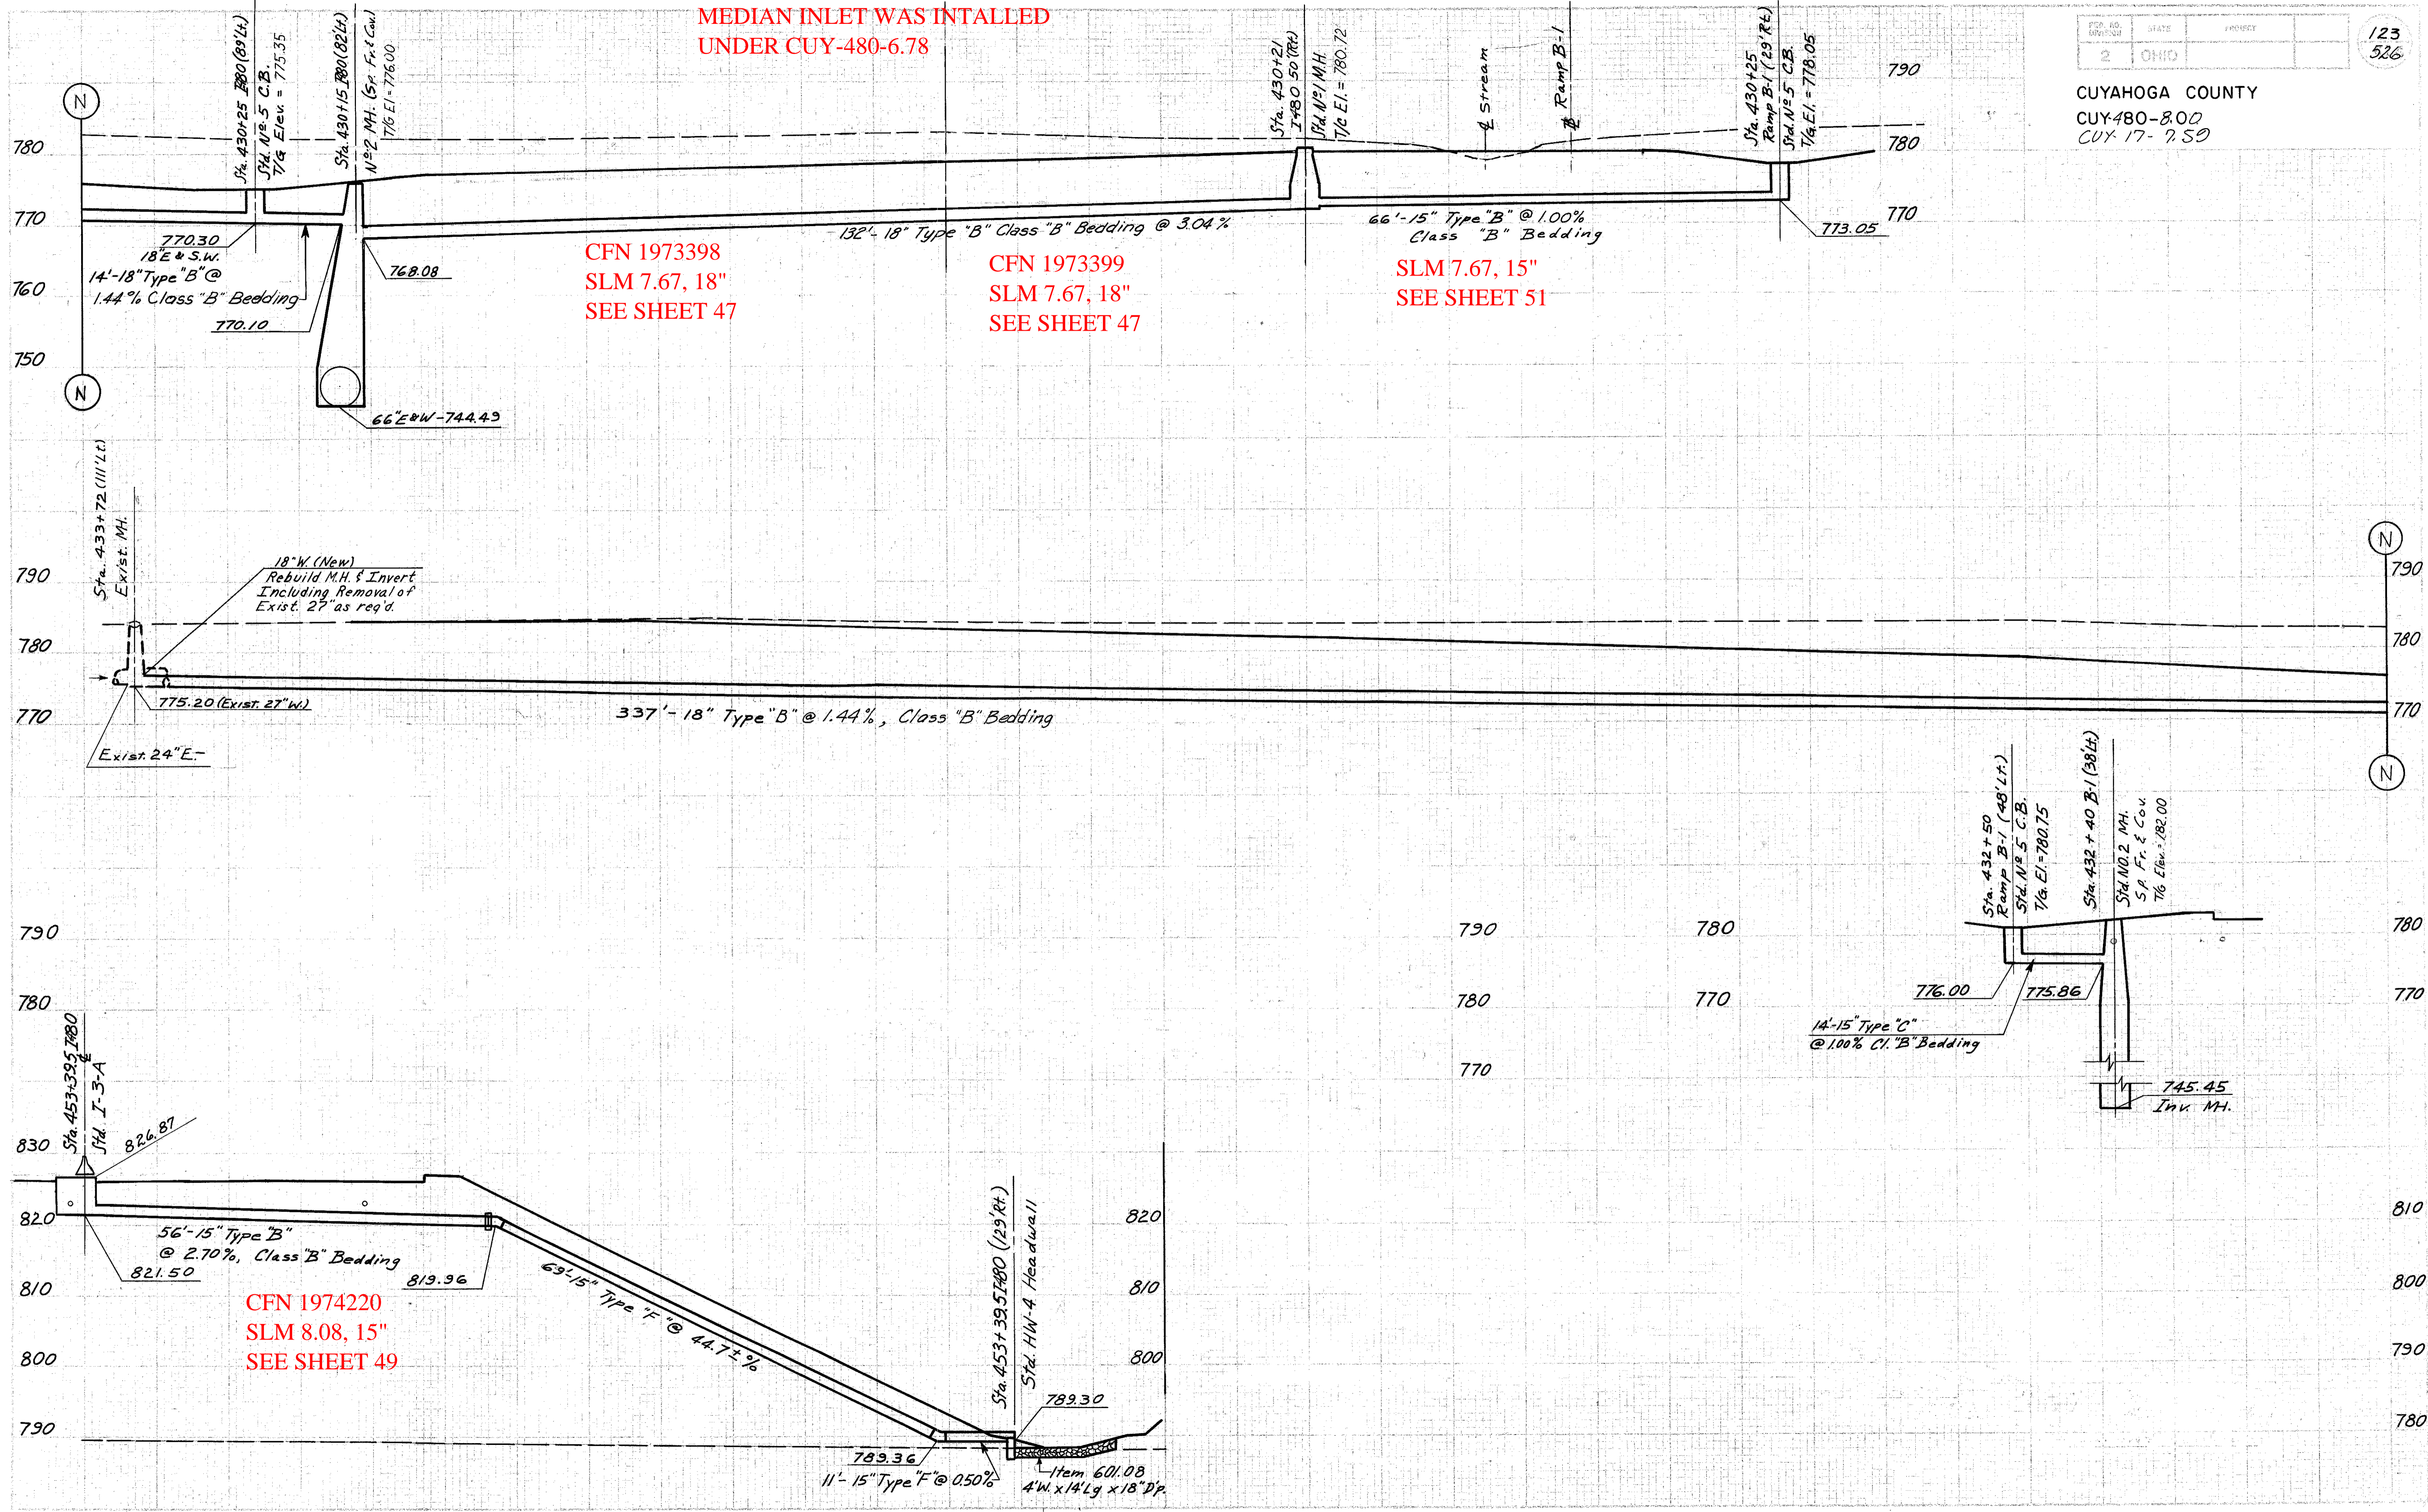

**CFN 1973398
 SLM 7.67, 18"
 SEE SHEET 47**

**CFN 1973399
 SLM 7.67, 18"
 SEE SHEET 47**

**SLM 7.67, 15"
 SEE SHEET 51**

**CFN 1974220
 SLM 8.08, 15"
 SEE SHEET 49**