


SEEDING  
END WIDTH SO. YDS.

FED. RD. DIVISION	STATE	PROJECT
2	OHIO	

231  
526

CUY-480-8.00  
CUY-17-7.50

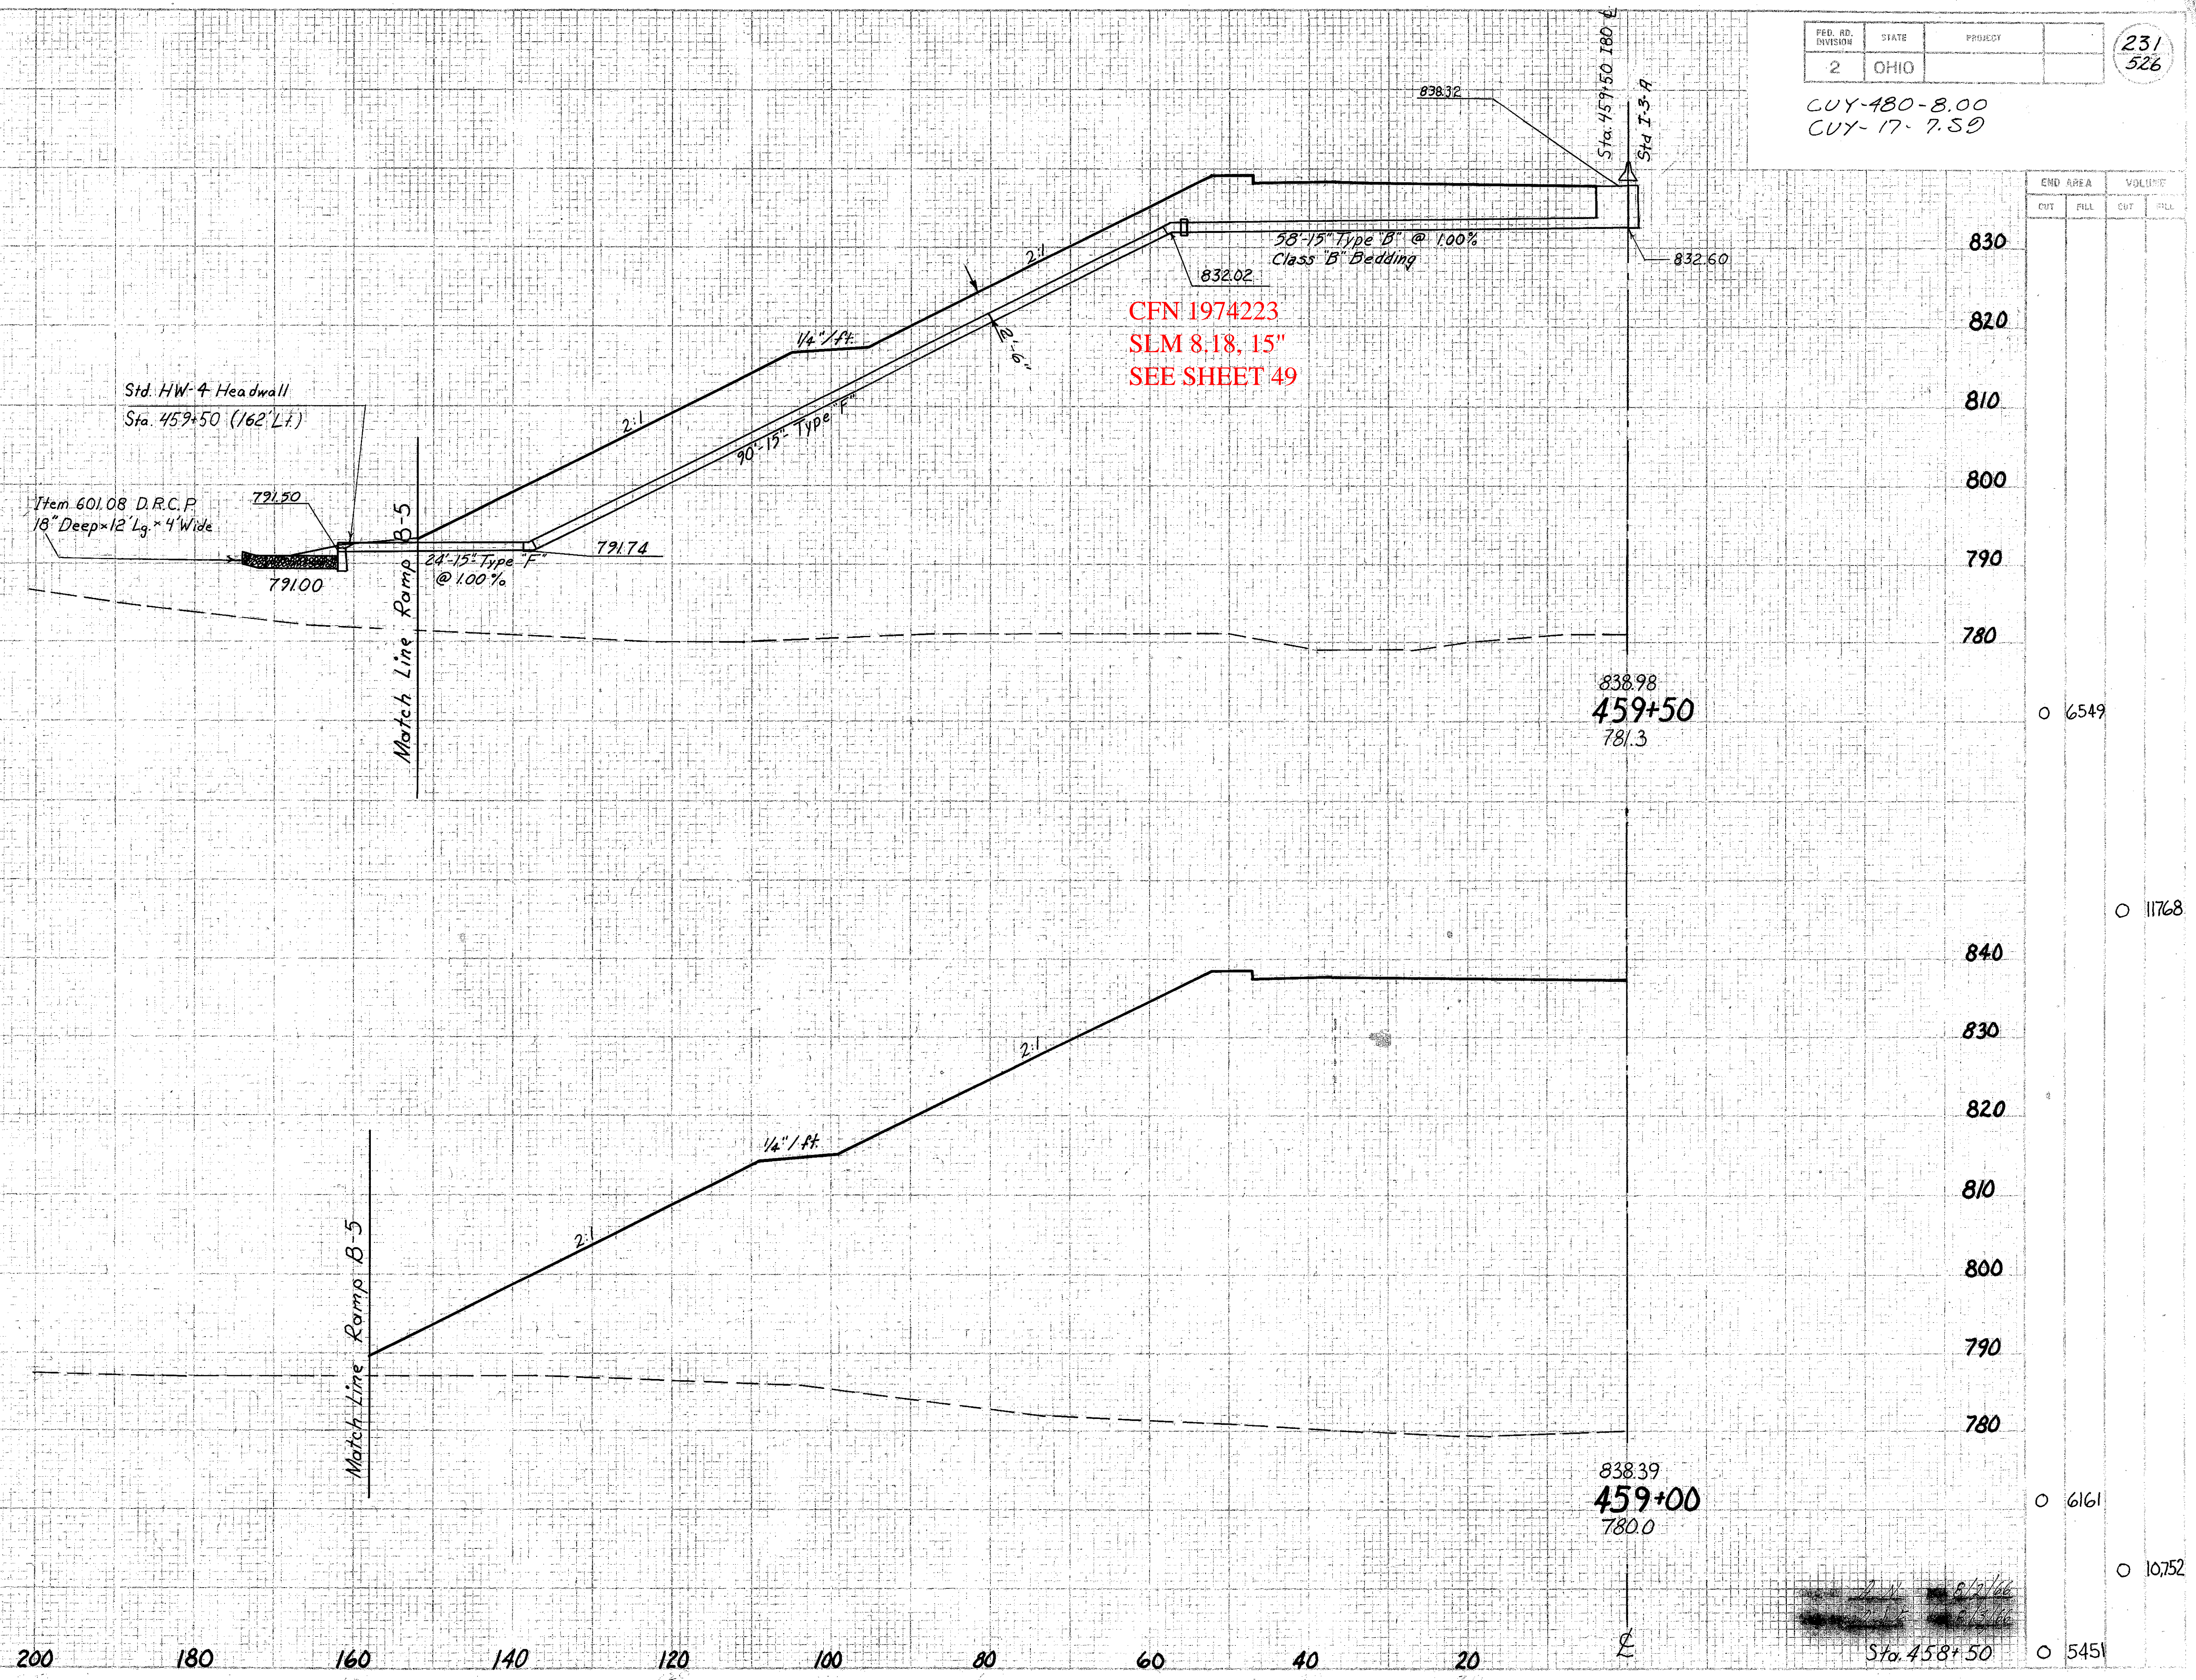

CFN 1974223  
SLM 8.18, 15"  
SEE SHEET 49

Std. HW-4 Headwall  
Sta. 459+50 (162' Lt.)

Item 601.08 D.R.C.P.  
18" Deep x 12' Lg. x 4' Wide

Match Line Ramp B-5

Match Line Ramp B-5

8/2/66  
8/13/66