

**CUYAHOGA COUNTY**  
**CUY 480-21.40**

Quantity Calculations  
Made By JEN Date 6-70  
Checked By JM Date 6-72

END	EARTHWORK		VOLUME
	EXC.	EMB.	
880			
870			
10			
20			
30			
40			
50			
60			
70			
80			
90			
100			
110			
120			
130			
140			

Emb. L =  $\frac{(1145.9 + 27.5) \times 58.85}{1145.9} = 60.26$

Exc. L =  $\frac{(1145.9 - 65) \times 58.85}{1145.9} = 55.51$

STA. 46+41.15

L =  $\frac{(1145.9 + 25) \times 41.15}{1145.9} = 42.05$

L =  $\frac{(1145.9 - 63) \times 41.15}{1145.9} = 38.89$

Emb. L =  $\frac{(1145.9 + 25) \times 100}{1145.9} = 102.0$

Exc. L =  $\frac{(1145.9 - 66.0) \times 100}{1145.9} = 94.3$

Emb. =  $\frac{(1145.9 + 12.5) \times 55}{1145.9} = 55.5$


Sta. 44+45

Exc. =  $\frac{(1145.9 - 21) \times 45}{1145.9} = 44.2$

Exc. L =  $\frac{(1145.9 - 38.5) \times 100}{1145.9} = 96.6$

EARTHWORK: QUANTITIES AT STATIONS MORE THAN 46+41.15 ARE IN PARTICIPATION LIMIT III

EARTHWORK QUANTITIES AT STATIONS LESS THAN 46+41.15 ARE IN PARTICIPATION LIMIT I

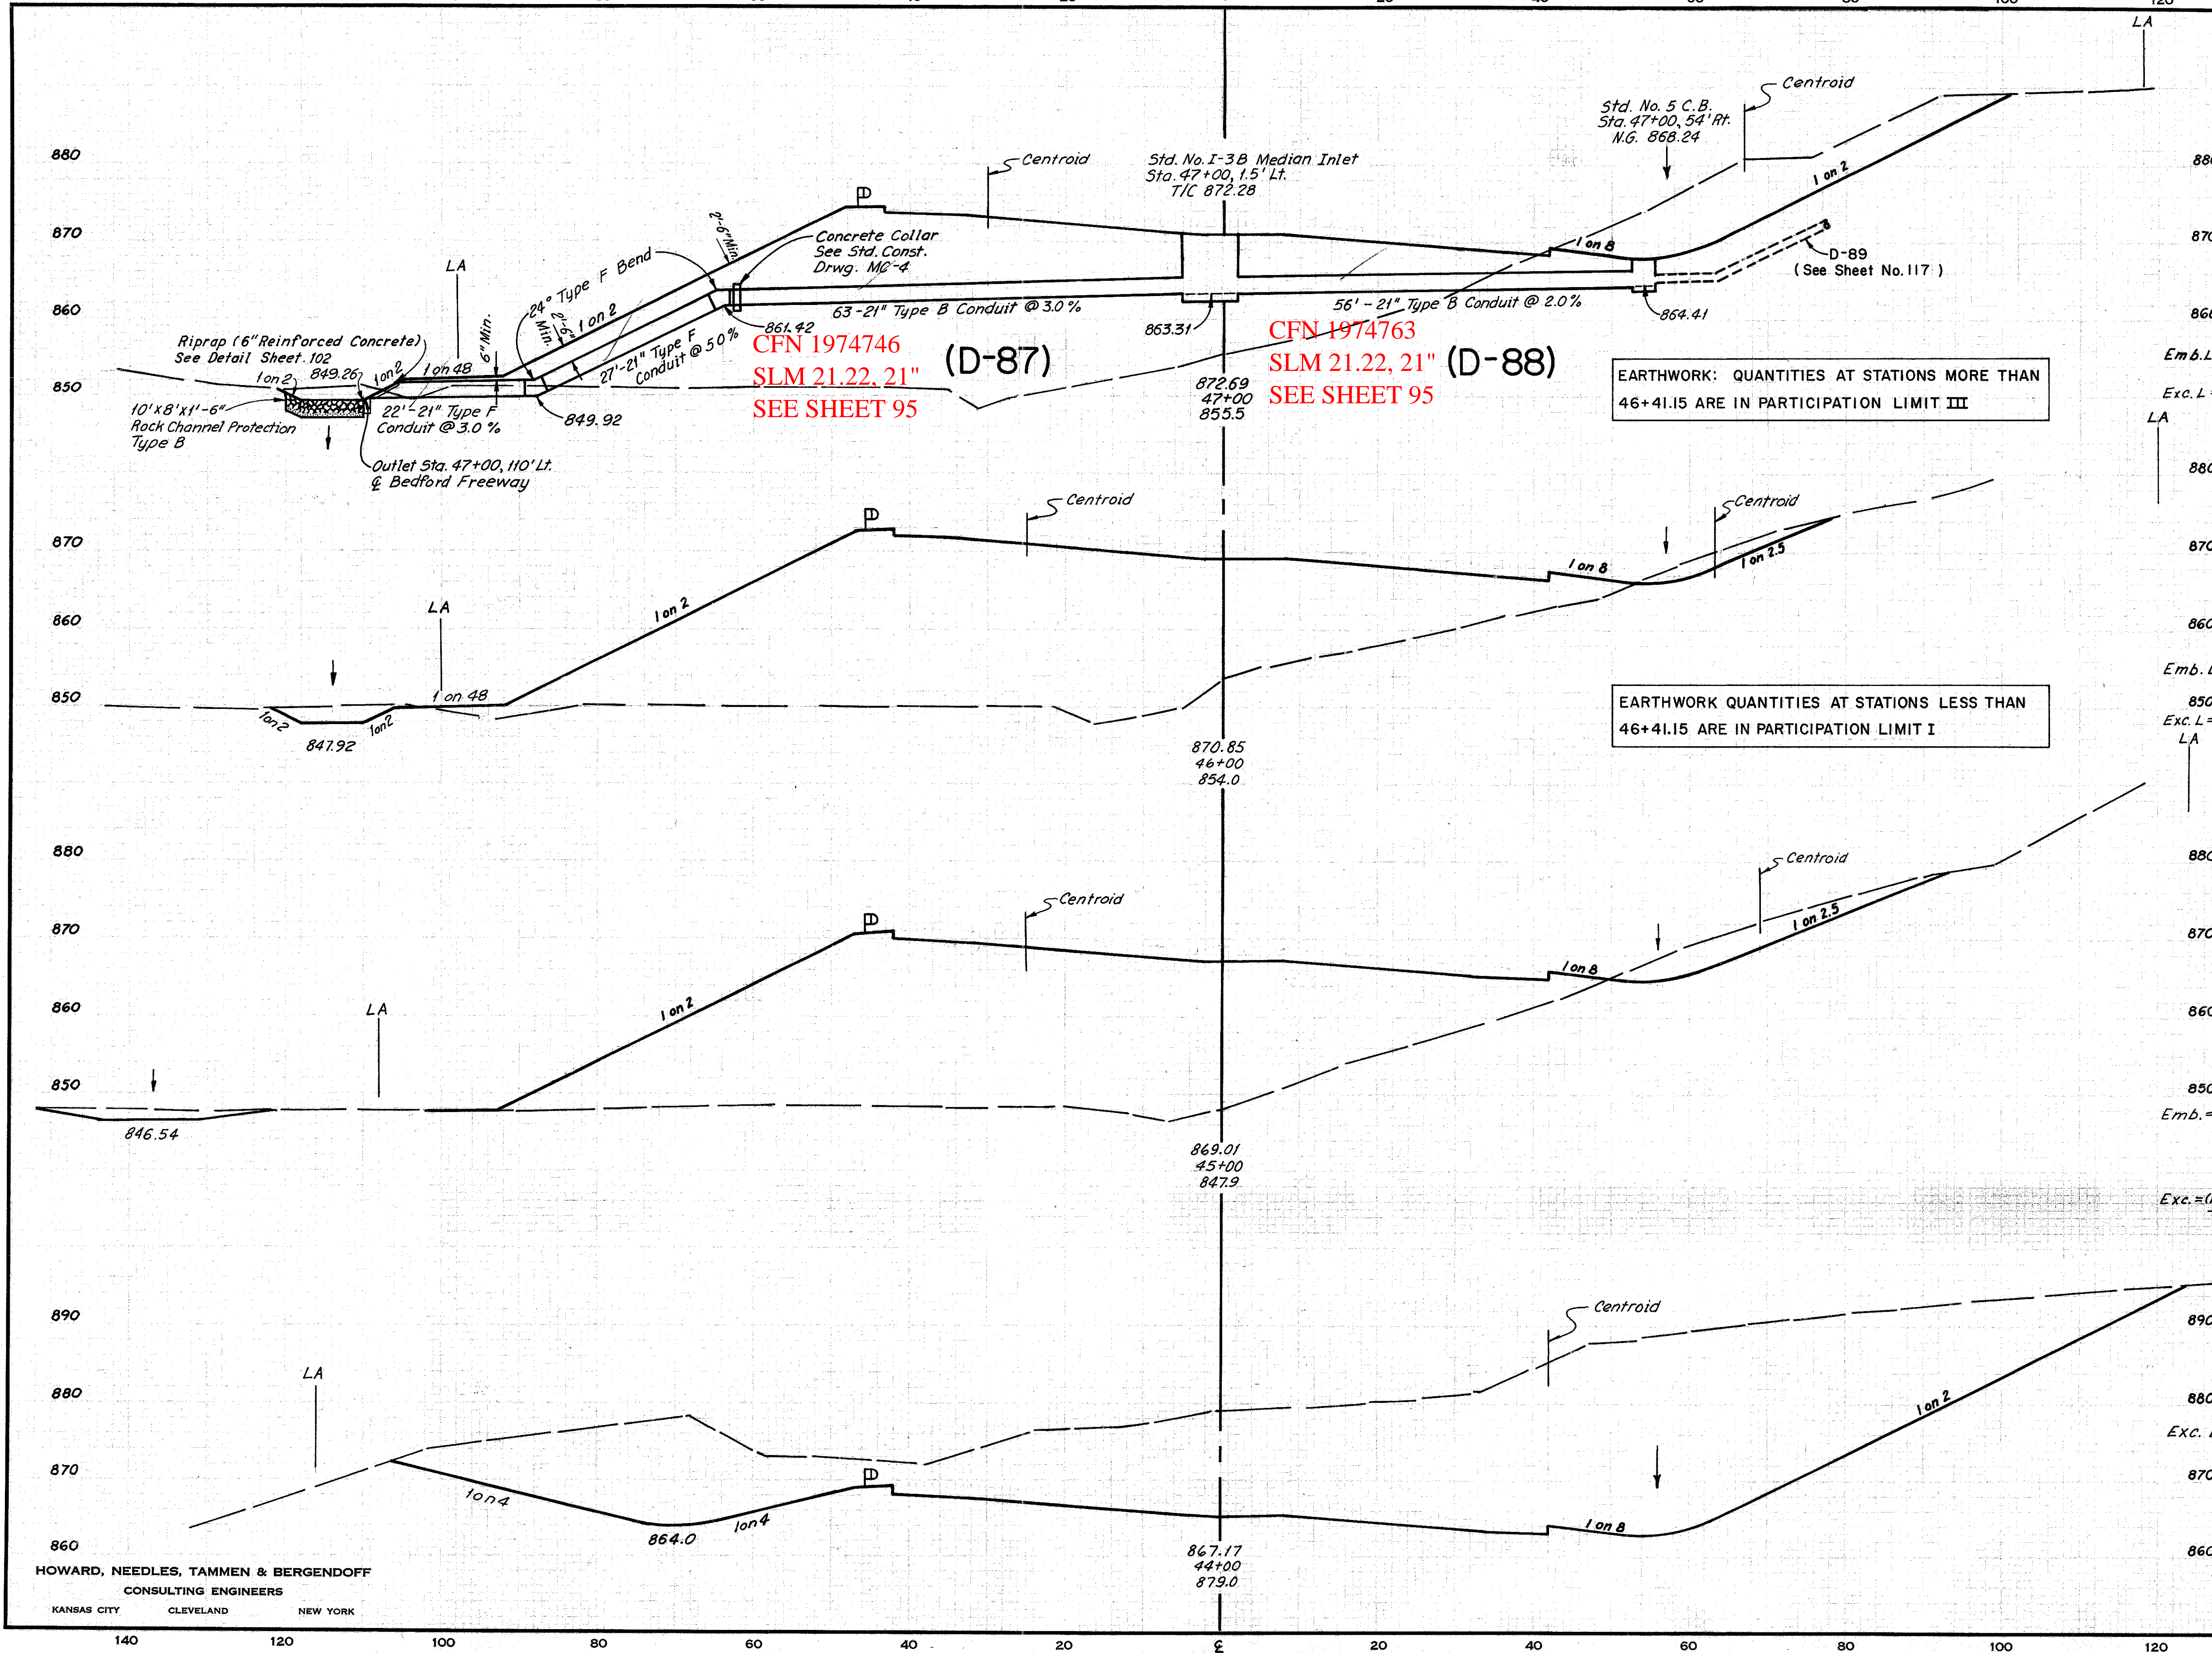

SLM 21.22, 21" (D-87)  
SEE SHEET 95

CFN 1974763  
SLM 21.22, 21" (D-88)  
SEE SHEET 95

W.L.L.  
R.F.L.  
J.E.N.  
I.M.