


FED. RD. DIVISION	STATE	PROJECT
2	OHIO	

66
392

CUYAHOGA COUNTY
C.U.Y. 80-15.81

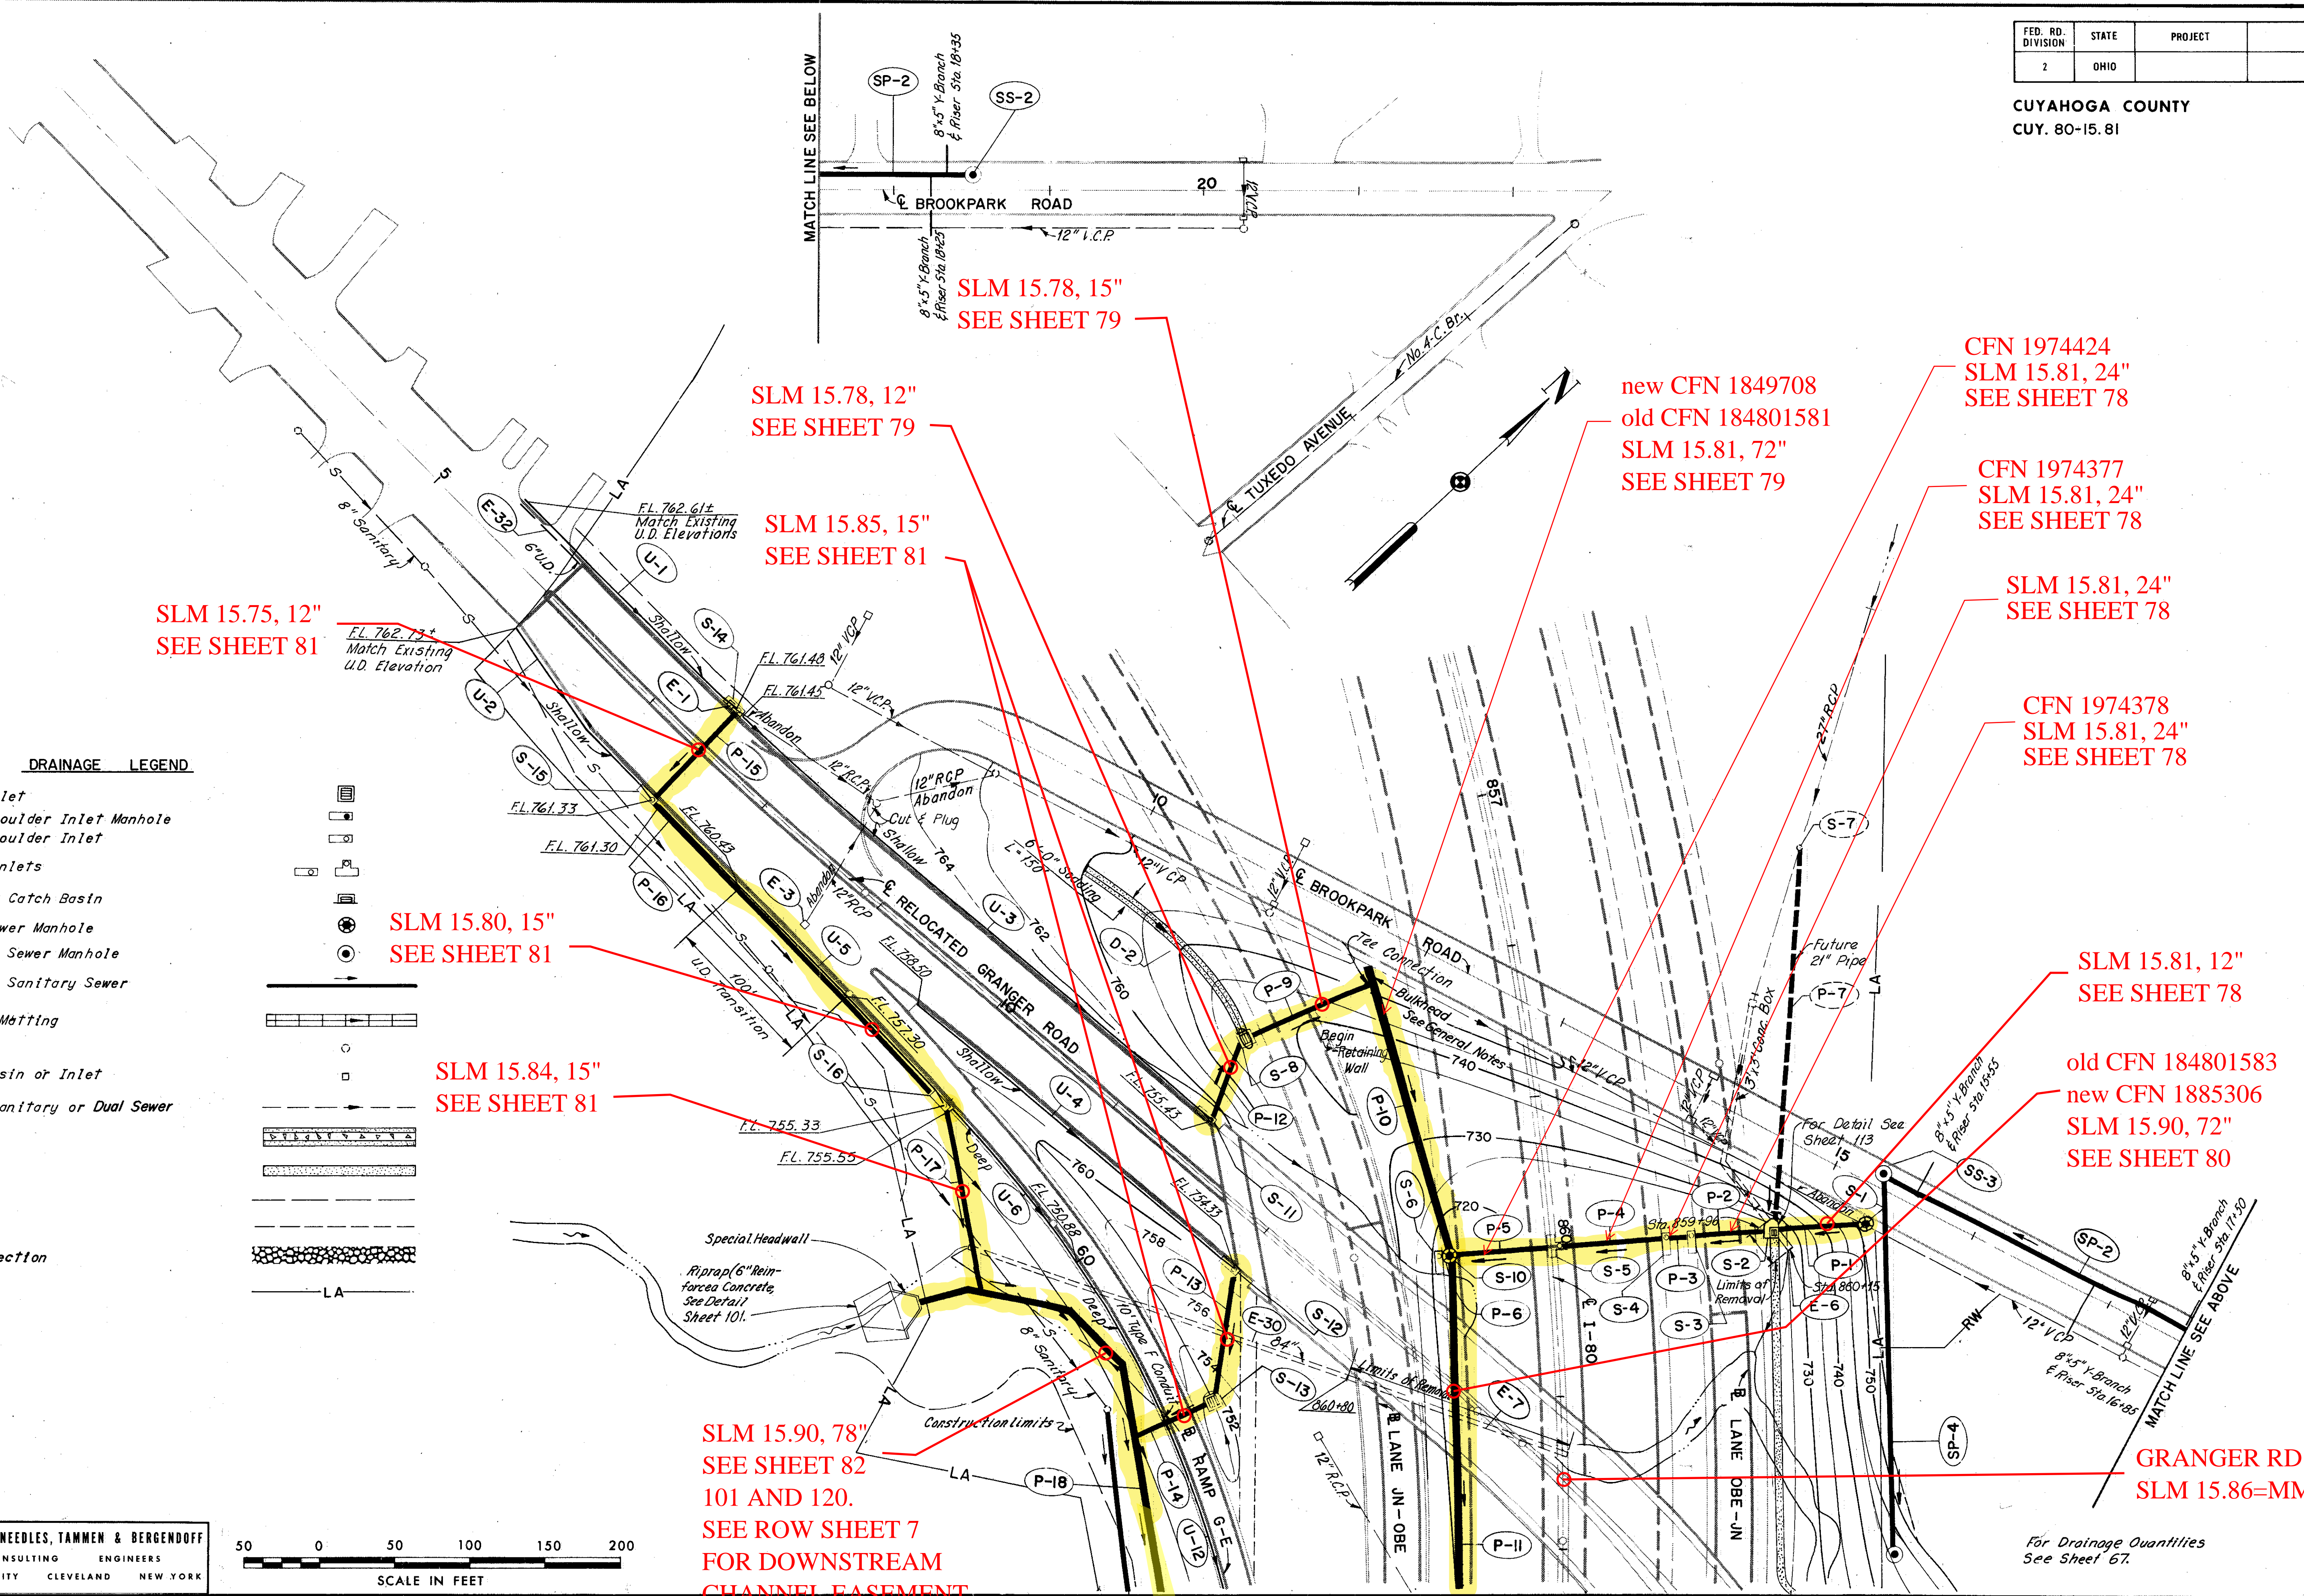

SCALE 1" = 50'
HOWARD, NEEDLES, TAMMEN & BERGENDOFF
MADE AHS DATE 5-4-70 CONSULTING ENGINEERS
TRCD. TZM. DATE 5-5-70 KANSAS CITY CLEVELAND NEW YORK
CKD. DATE 5-7-70



SLM 15.90, 78"
SEE SHEET 82
101 AND 120.
SEE ROW SHEET 7
FOR DOWNSTREAM
CHANNEL EASEMENT