

FED. RD. DIVISION	STATE	PROJECT	71 392
2	OHIO		

CUYAHOGA COUNTY
CUY. 80-15.81

CFN 1974447
SLM 16.26, 18"
SEE SHEET 87

CFN 1974438
SLM 16.26, 18"
SEE SHEET 87

CFN 1974445
SLM 16.26, 18"
SEE SHEET 87

CFN 1974453
SLM 16.26, 18"
SEE SHEET 87

SLM 16.13, 108"
SEE SHEET 88

SLM 16.20, 15"
SEE SHEET 96

SLM 16.21, 84"
SEE SHEET 87

SLM 16.28, 84"
SEE SHEET 87

Low Priority Outfall
CUY22004R



BRIDGE
SFN 1812769
MM 18.45
SLM 16.28, 120"
SEE SHEET 88

CFN 1974435
SLM 16.34, 15"
SEE SHEET 87

CFN 1974443
SLM 16.34, 15"
SEE SHEET 87

CFN 1974439
SLM 16.34, 15"
SEE SHEET 87

SLM 16.39, 21"
SEE SHEET 89

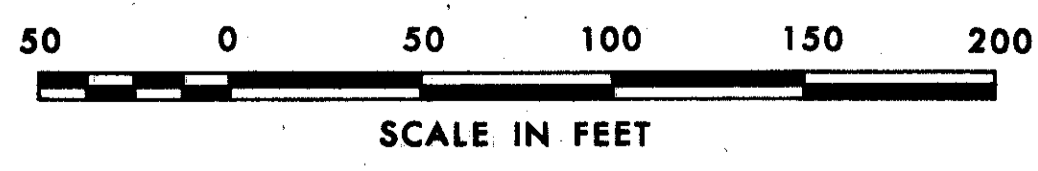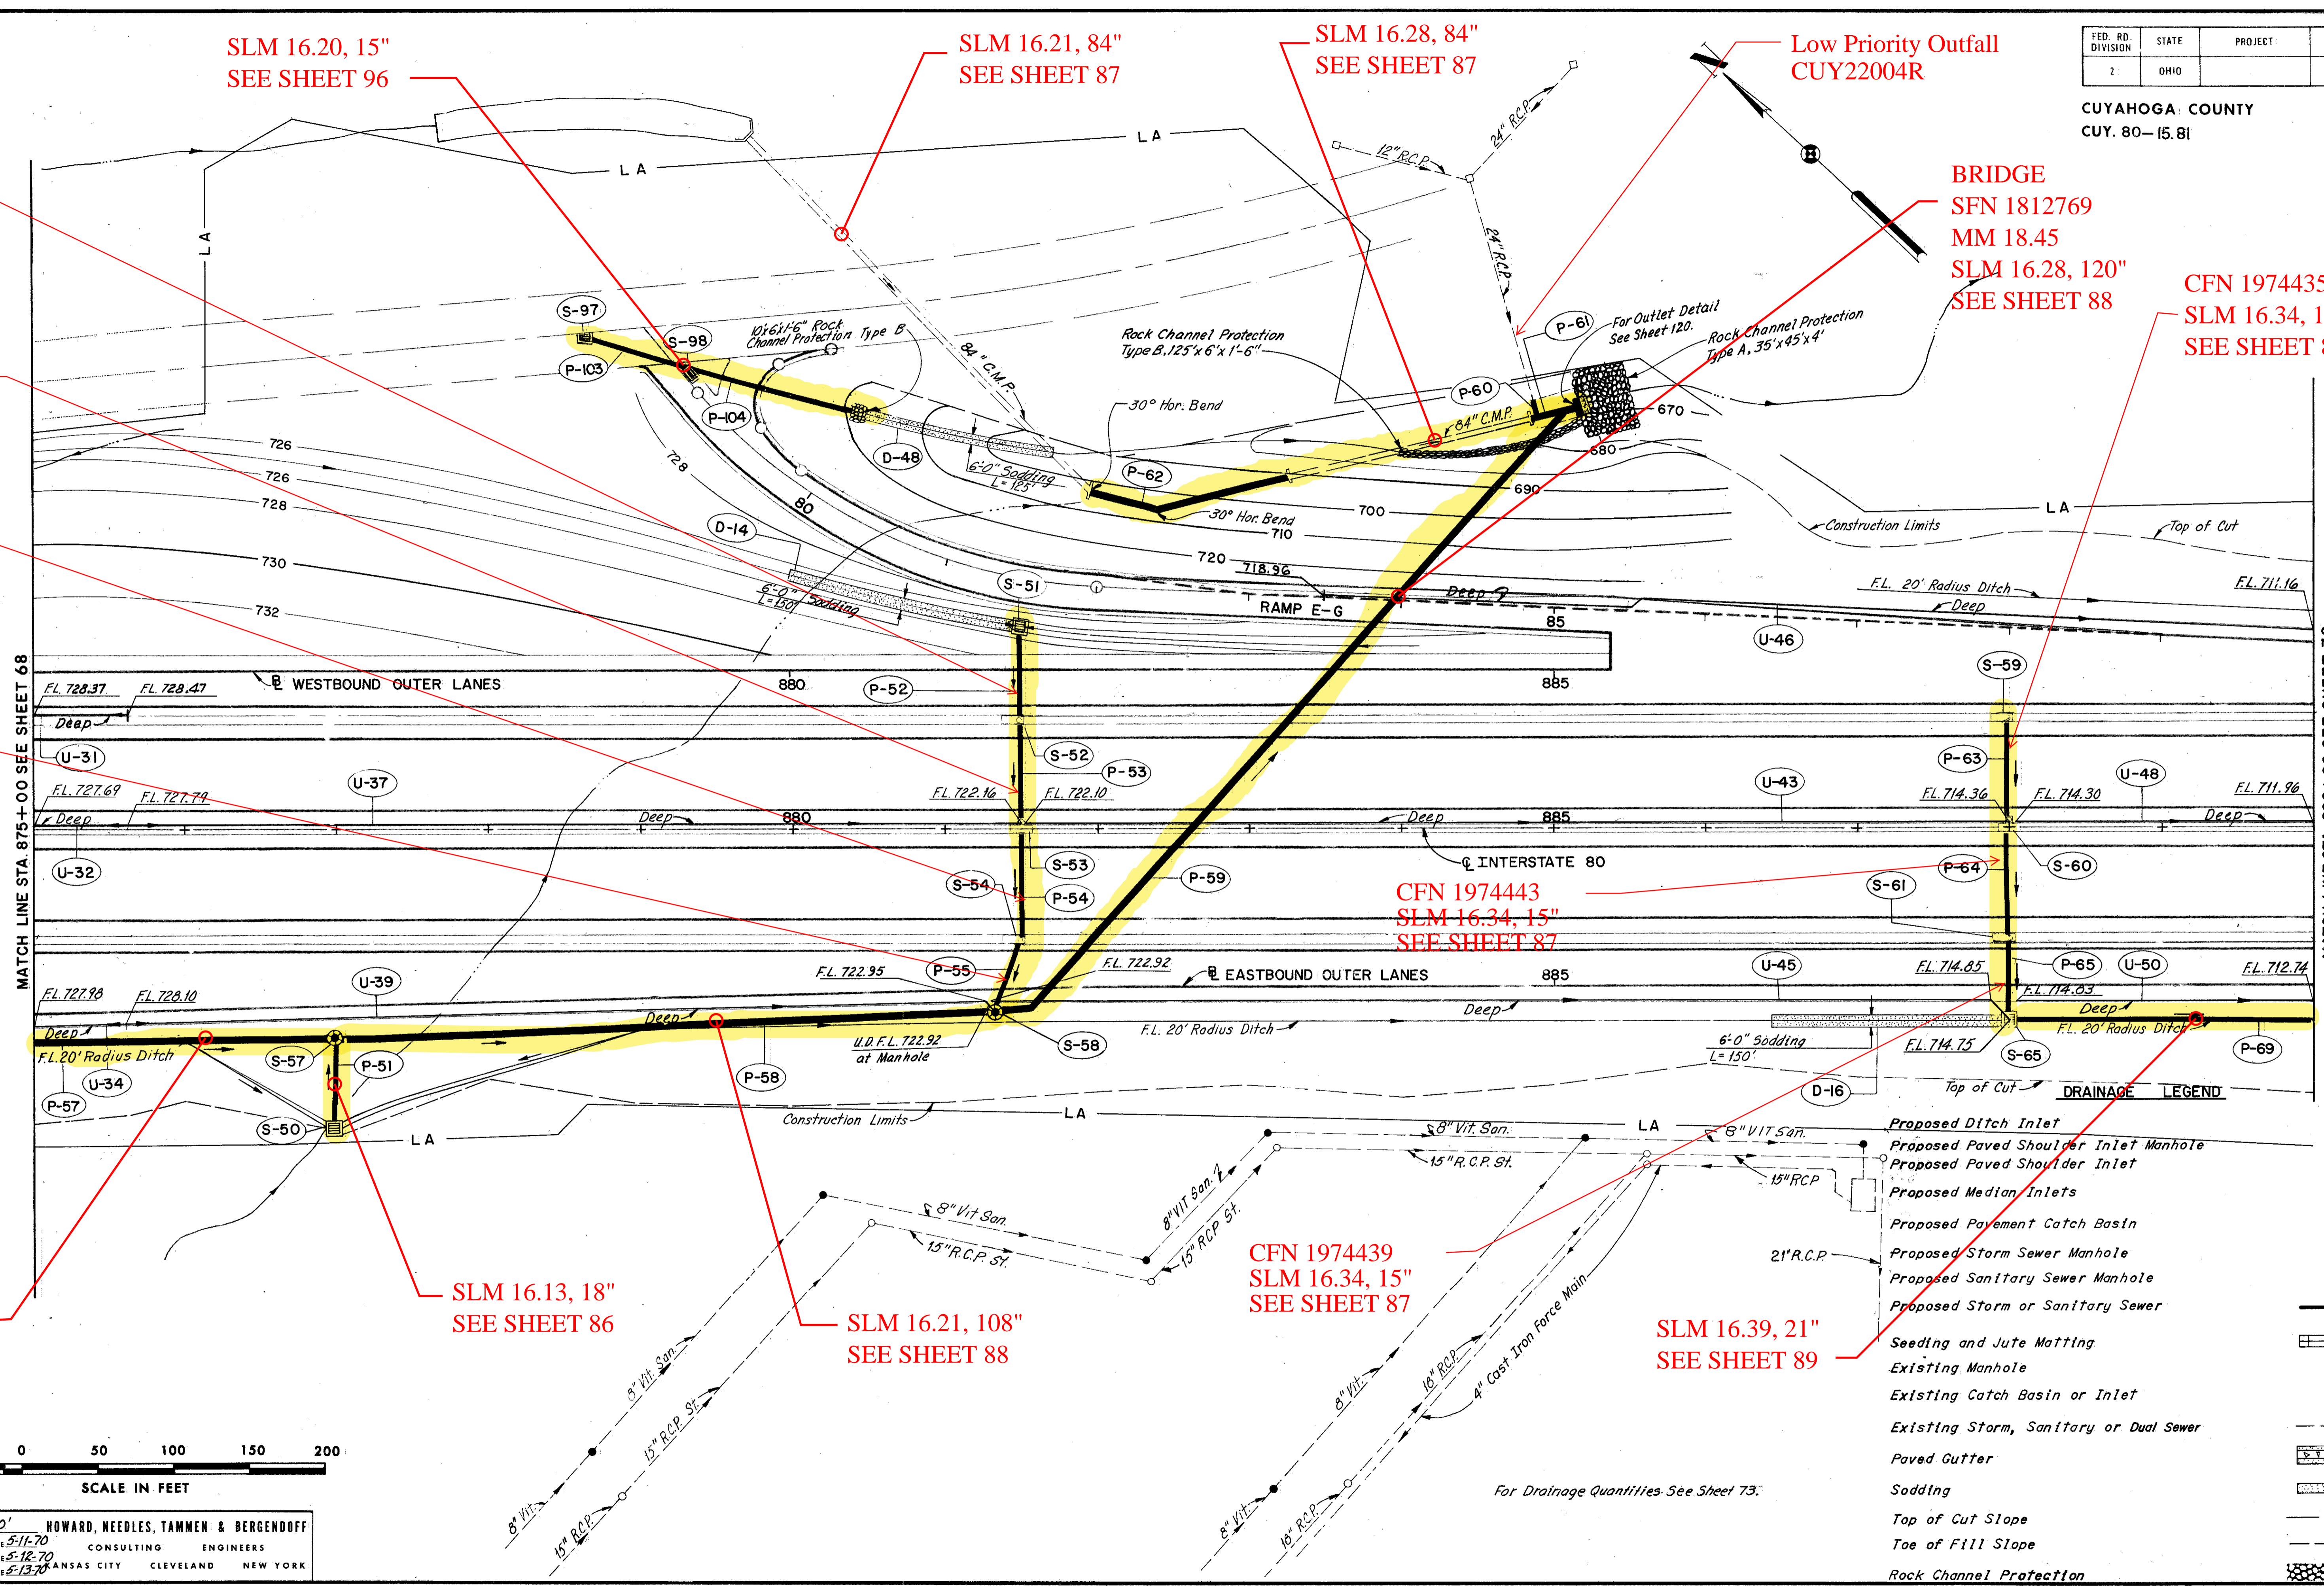

SCALE 1" = 50'
HOWARD, NEEDLES, TAMMEN & BERGENDOFF
CONSULTING ENGINEERS
MADE A.H.S. DATE 5-11-70
TRCD T.P.M. DATE 5-12-70
C.K.D. G.L. DATE 5-13-70
ANSAS CITY CLEVELAND NEW YORK

DRAINAGE LEGEND

- Proposed Ditch Inlet
- Proposed Paved Shoulder Inlet Manhole
- Proposed Paved Shoulder Inlet
- Proposed Median Inlets
- Proposed Payment Catch Basin
- Proposed Storm Sewer Manhole
- Proposed Sanitary Sewer Manhole
- Proposed Storm or Sanitary Sewer
- Seeding and Jute Matting
- Existing Manhole
- Existing Catch Basin or Inlet
- Existing Storm, Sanitary or Dual Sewer
- Paved Gutter
- Sodding
- Top of Cut Slope
- Toe of Fill Slope
- Rock Channel Protection