



FED. RD. DIVISION	STATE	PROJECT
2	OHIO	

78  
392

CUYAHOGA COUNTY  
CUY.-80-15.81

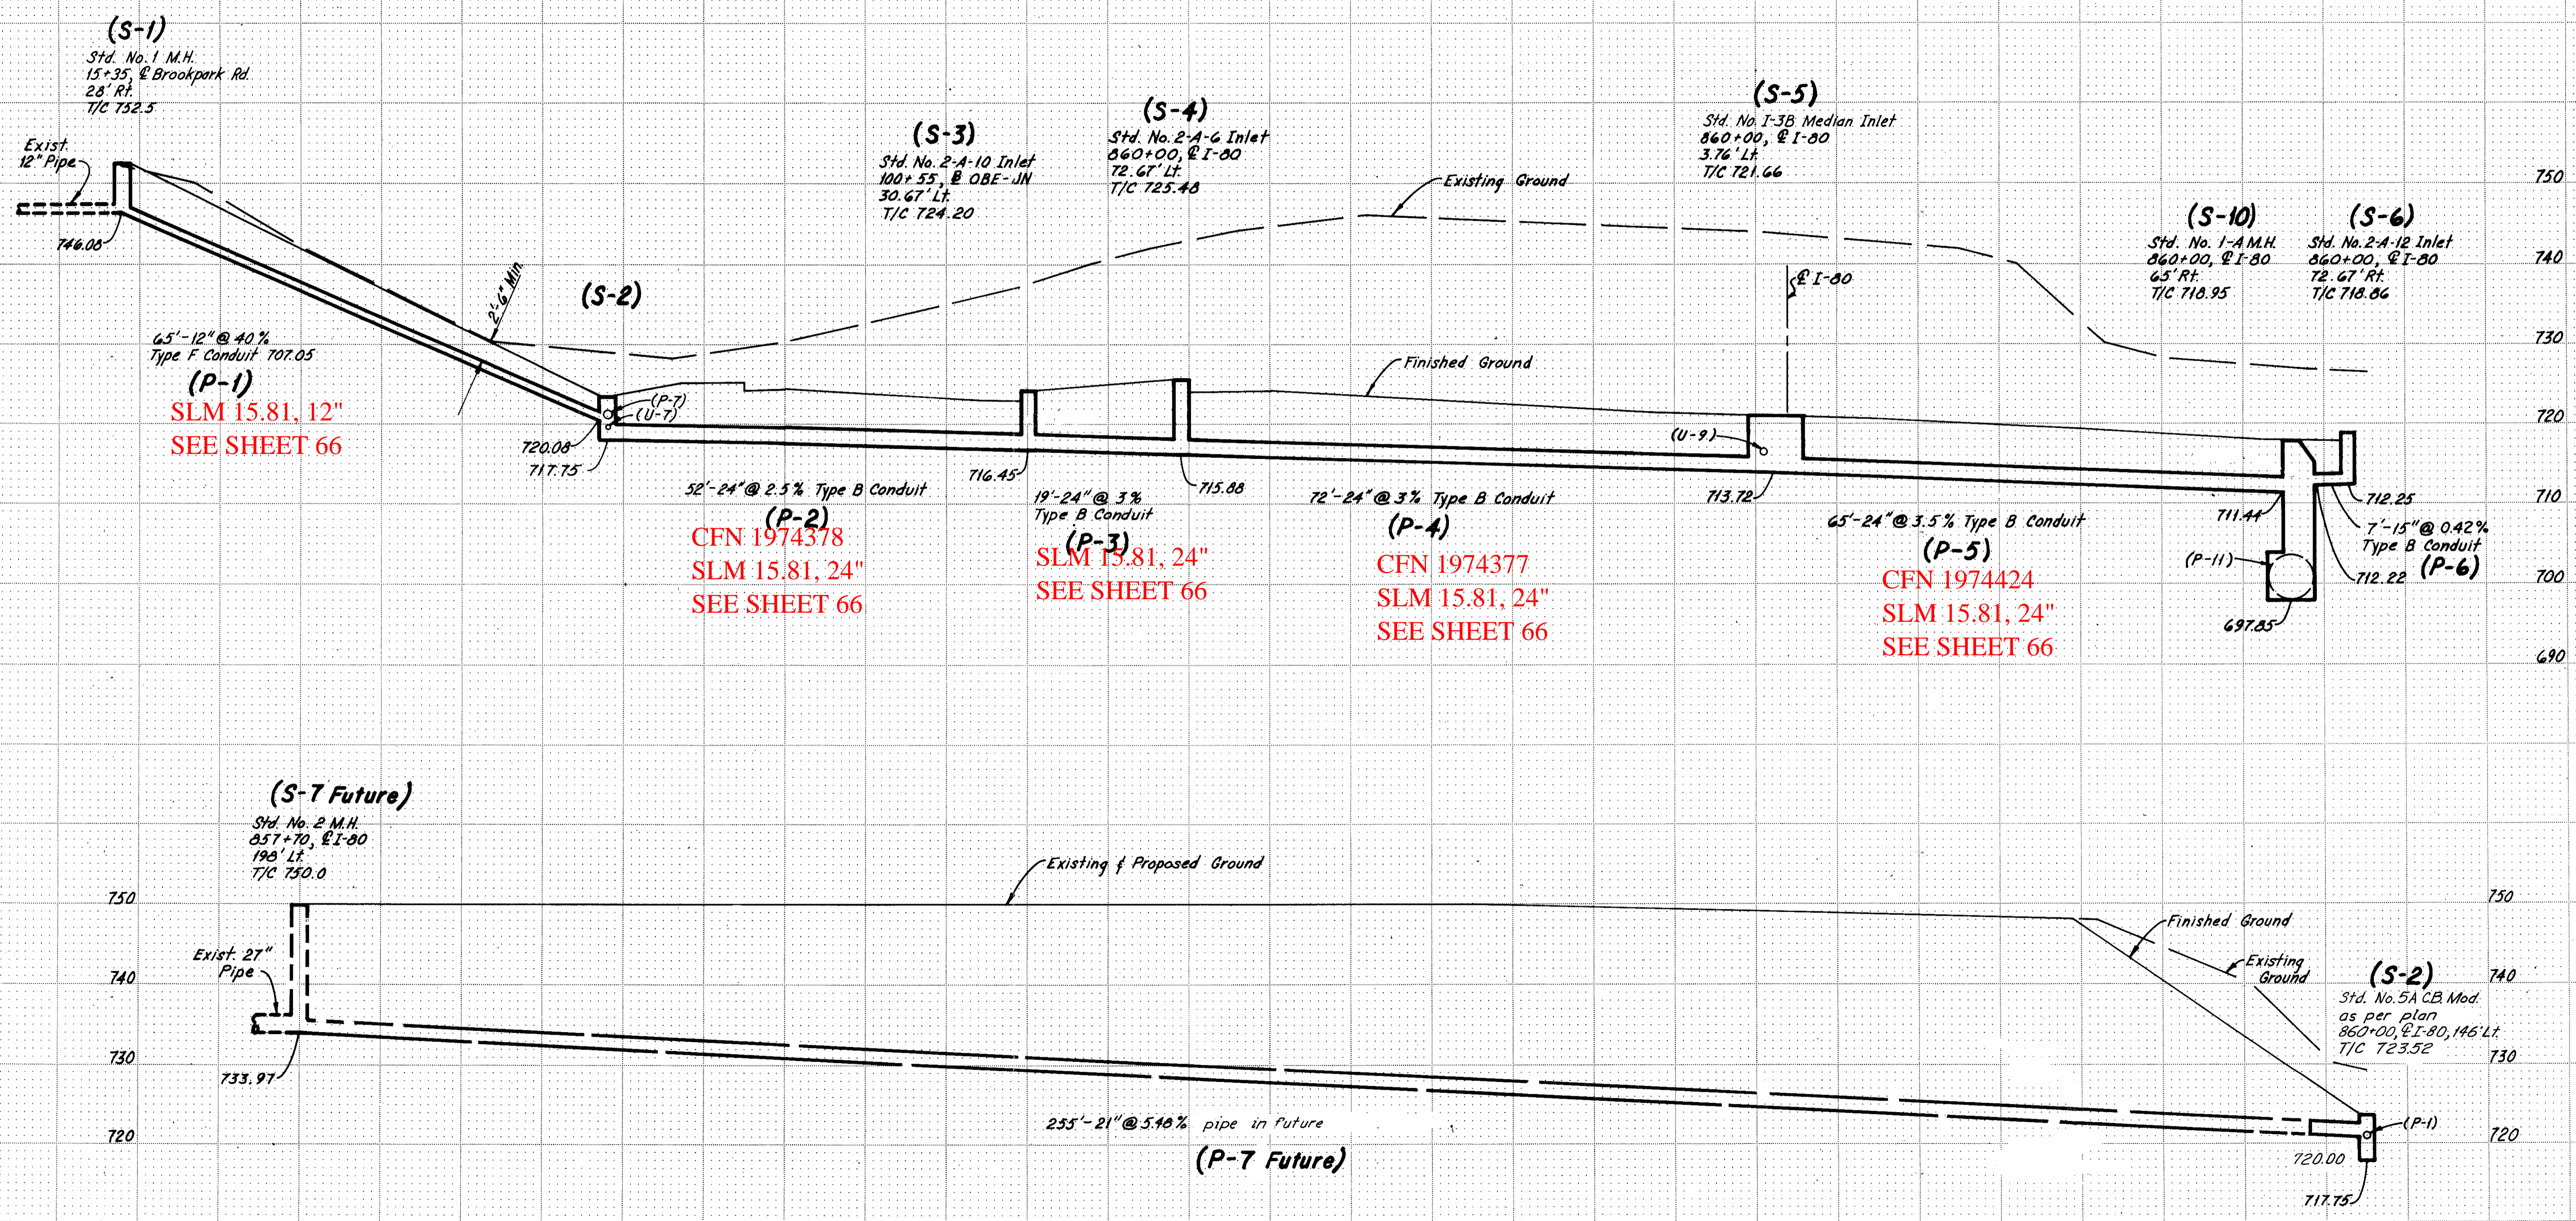

SCALE 1"=10' Hor. & Vert. HOWARD, NEEDLES, TAMMEN & BERGENOFF  
MADE A.H.S. DATE 6-8-70 CONSULTING ENGINEERS  
TRCD. T.P.M. DATE 8-17-70  
CKD. G.L. DATE 8-2-70 KANSAS CITY CLEVELAND NEW YORK  
A.H.S. DATE 8-2-70

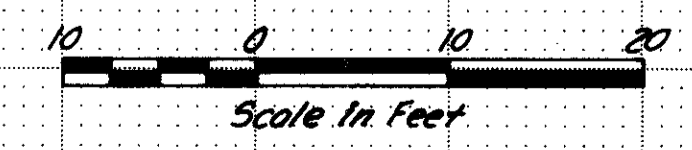

6'-21" @ 5.48% Type B Conduit 706.02 Class IV  
Bulkhead pipe, Payment included in Item 604  
Std. No. 5A C.B. Mod. as per plan