


CUYAHOGA COUNTY  
CUY-480-1943

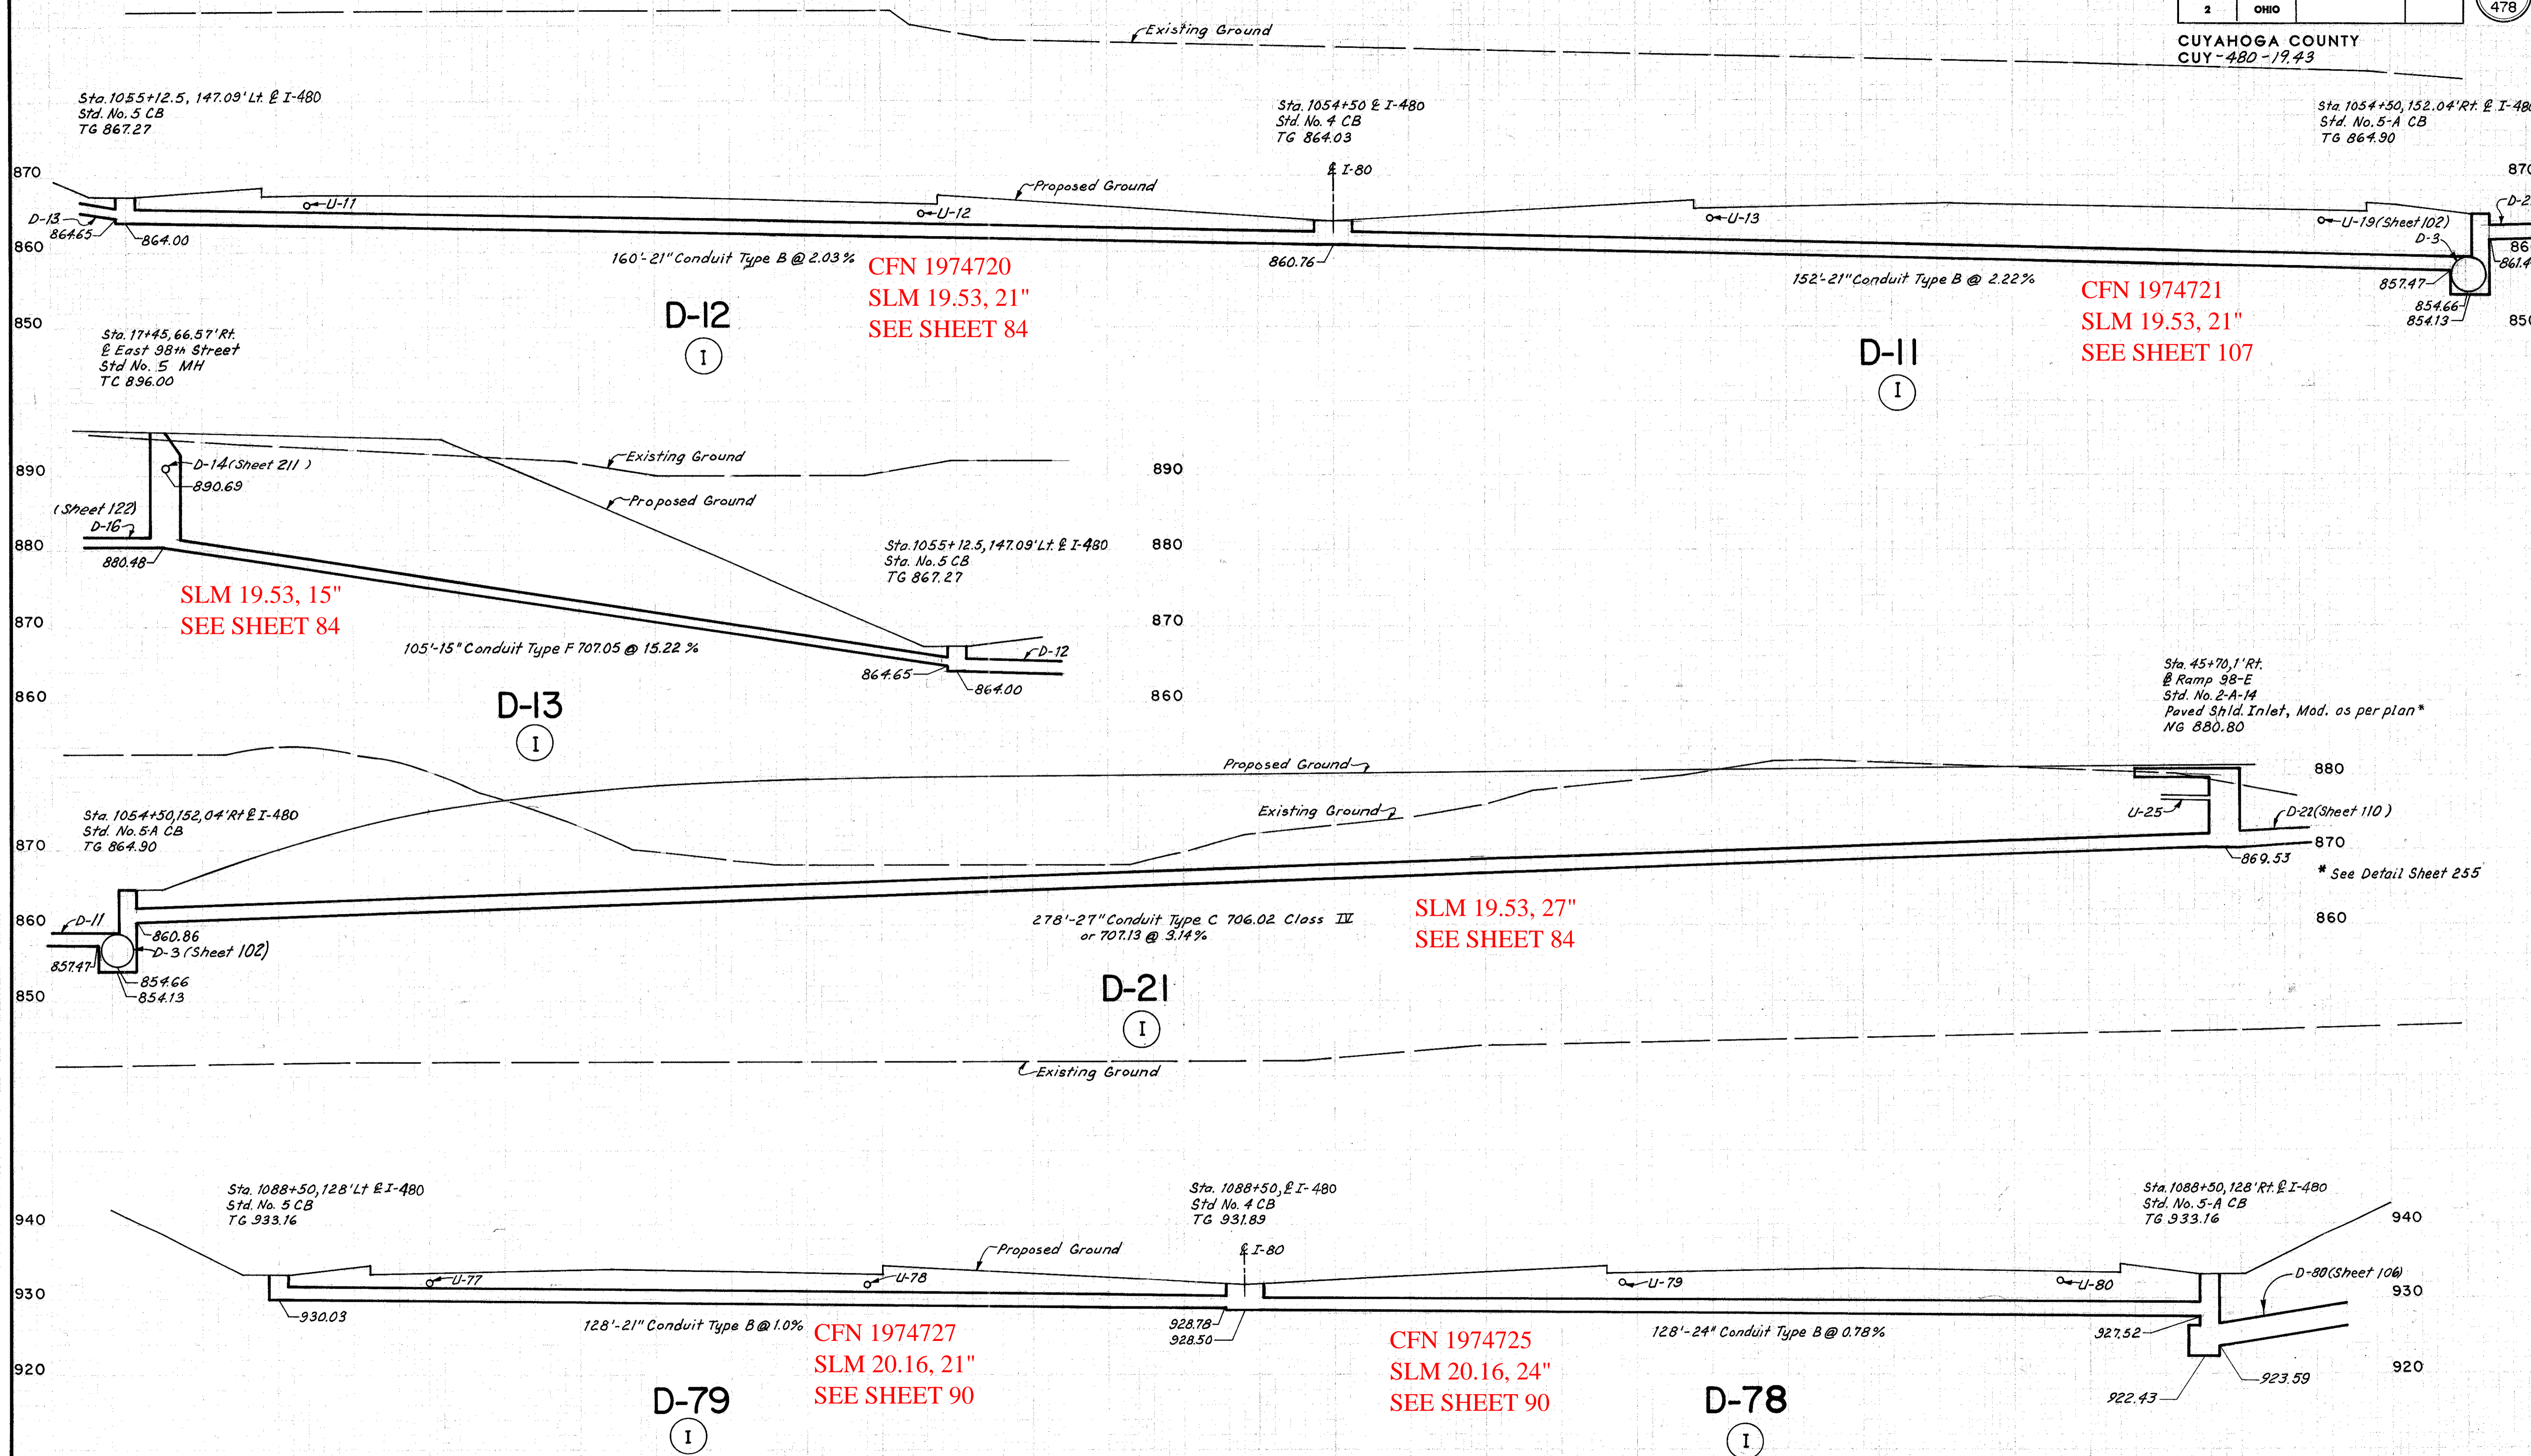

CFN 1974720  
SLM 19.53, 21"  
SEE SHEET 84

CFN 1974721  
SLM 19.53, 21"  
SEE SHEET 107

SLM 19.53, 15"  
SEE SHEET 84

SLM 19.53, 27"  
SEE SHEET 84

CFN 1974727  
SLM 20.16, 21"  
SEE SHEET 90

CFN 1974725  
SLM 20.16, 24"  
SEE SHEET 90

Made Checked  
 E.R.A. R.A.E.  
 6-8-70 6-9-70