MICROFILMED
DEC 6 1982

B.M. Elev. 787.96
+ Chiseled on W. Side of M.H.
Sta. 442+04 ℄ Ramp B-1 (20' Lt)

CALC. BY T.R.B. DATE 11-75
CHKD. BY E.J.K. DATE 12-75
REV. T.R.B. 5-1-78

3.9
317

CUYAHOGA COUNTY
CUY-480 - 6.78

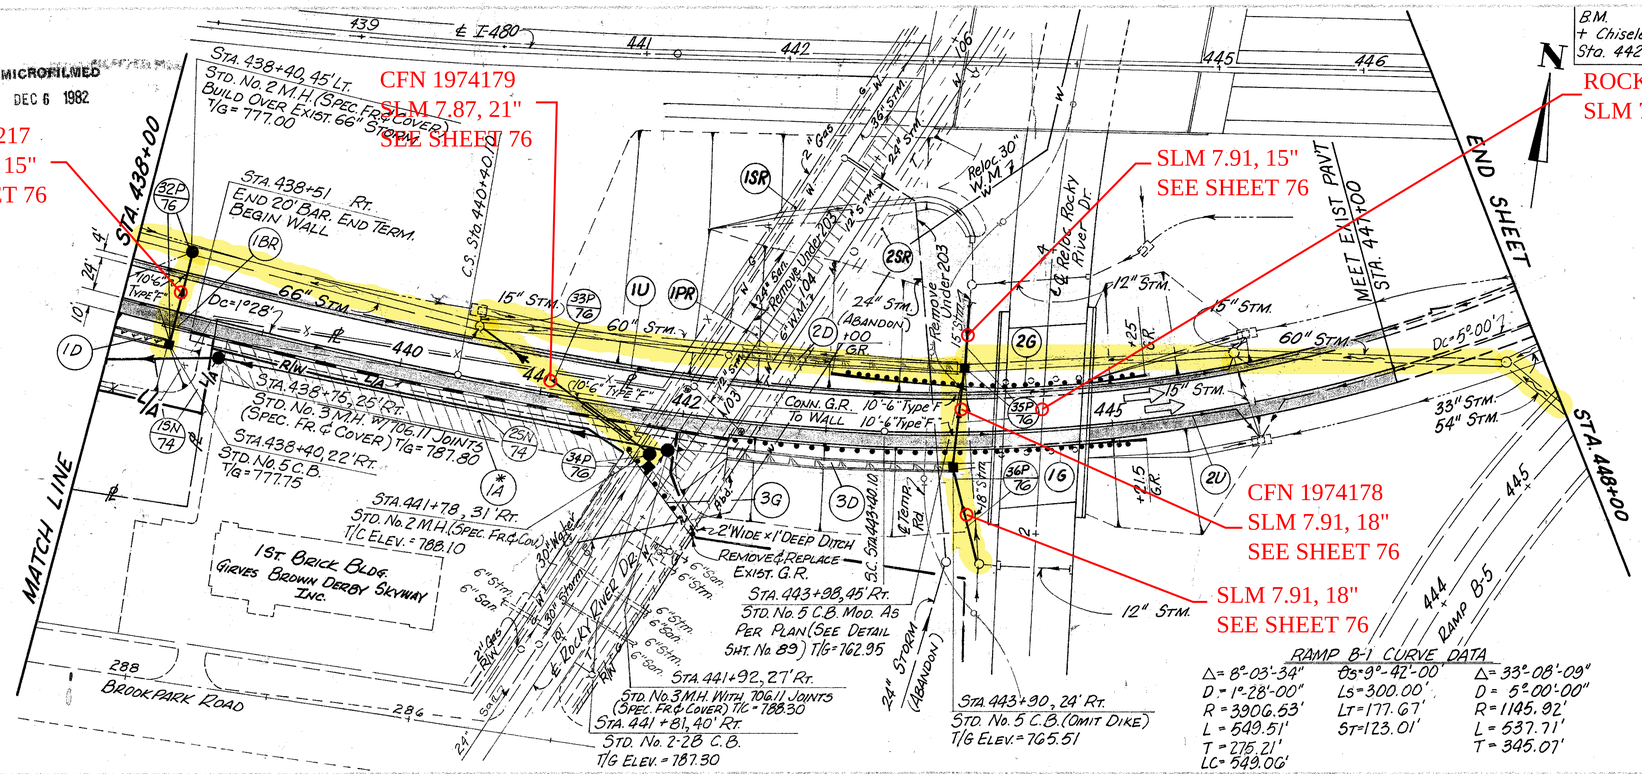

CROSS REFERENCE	
SH. No.	ITEM
55	ROCKY RIVER DR. P&P.
76	STORM SEWER PROFILE
74	SANITARY SEWER PROFILE
58	Temporary Rd. P&P.
209, 210	Relocated 30" Water Main
276A	RAMP B-1 RETAINING WALL

EXCAVATION	45,570 C.Y.
EMBANKMENT	7 C.Y.
SEEDING	9,121 S.Y.

| Estimated Quantities | | |