


CUYAHOGA COUNTY
CUY 480-10.39

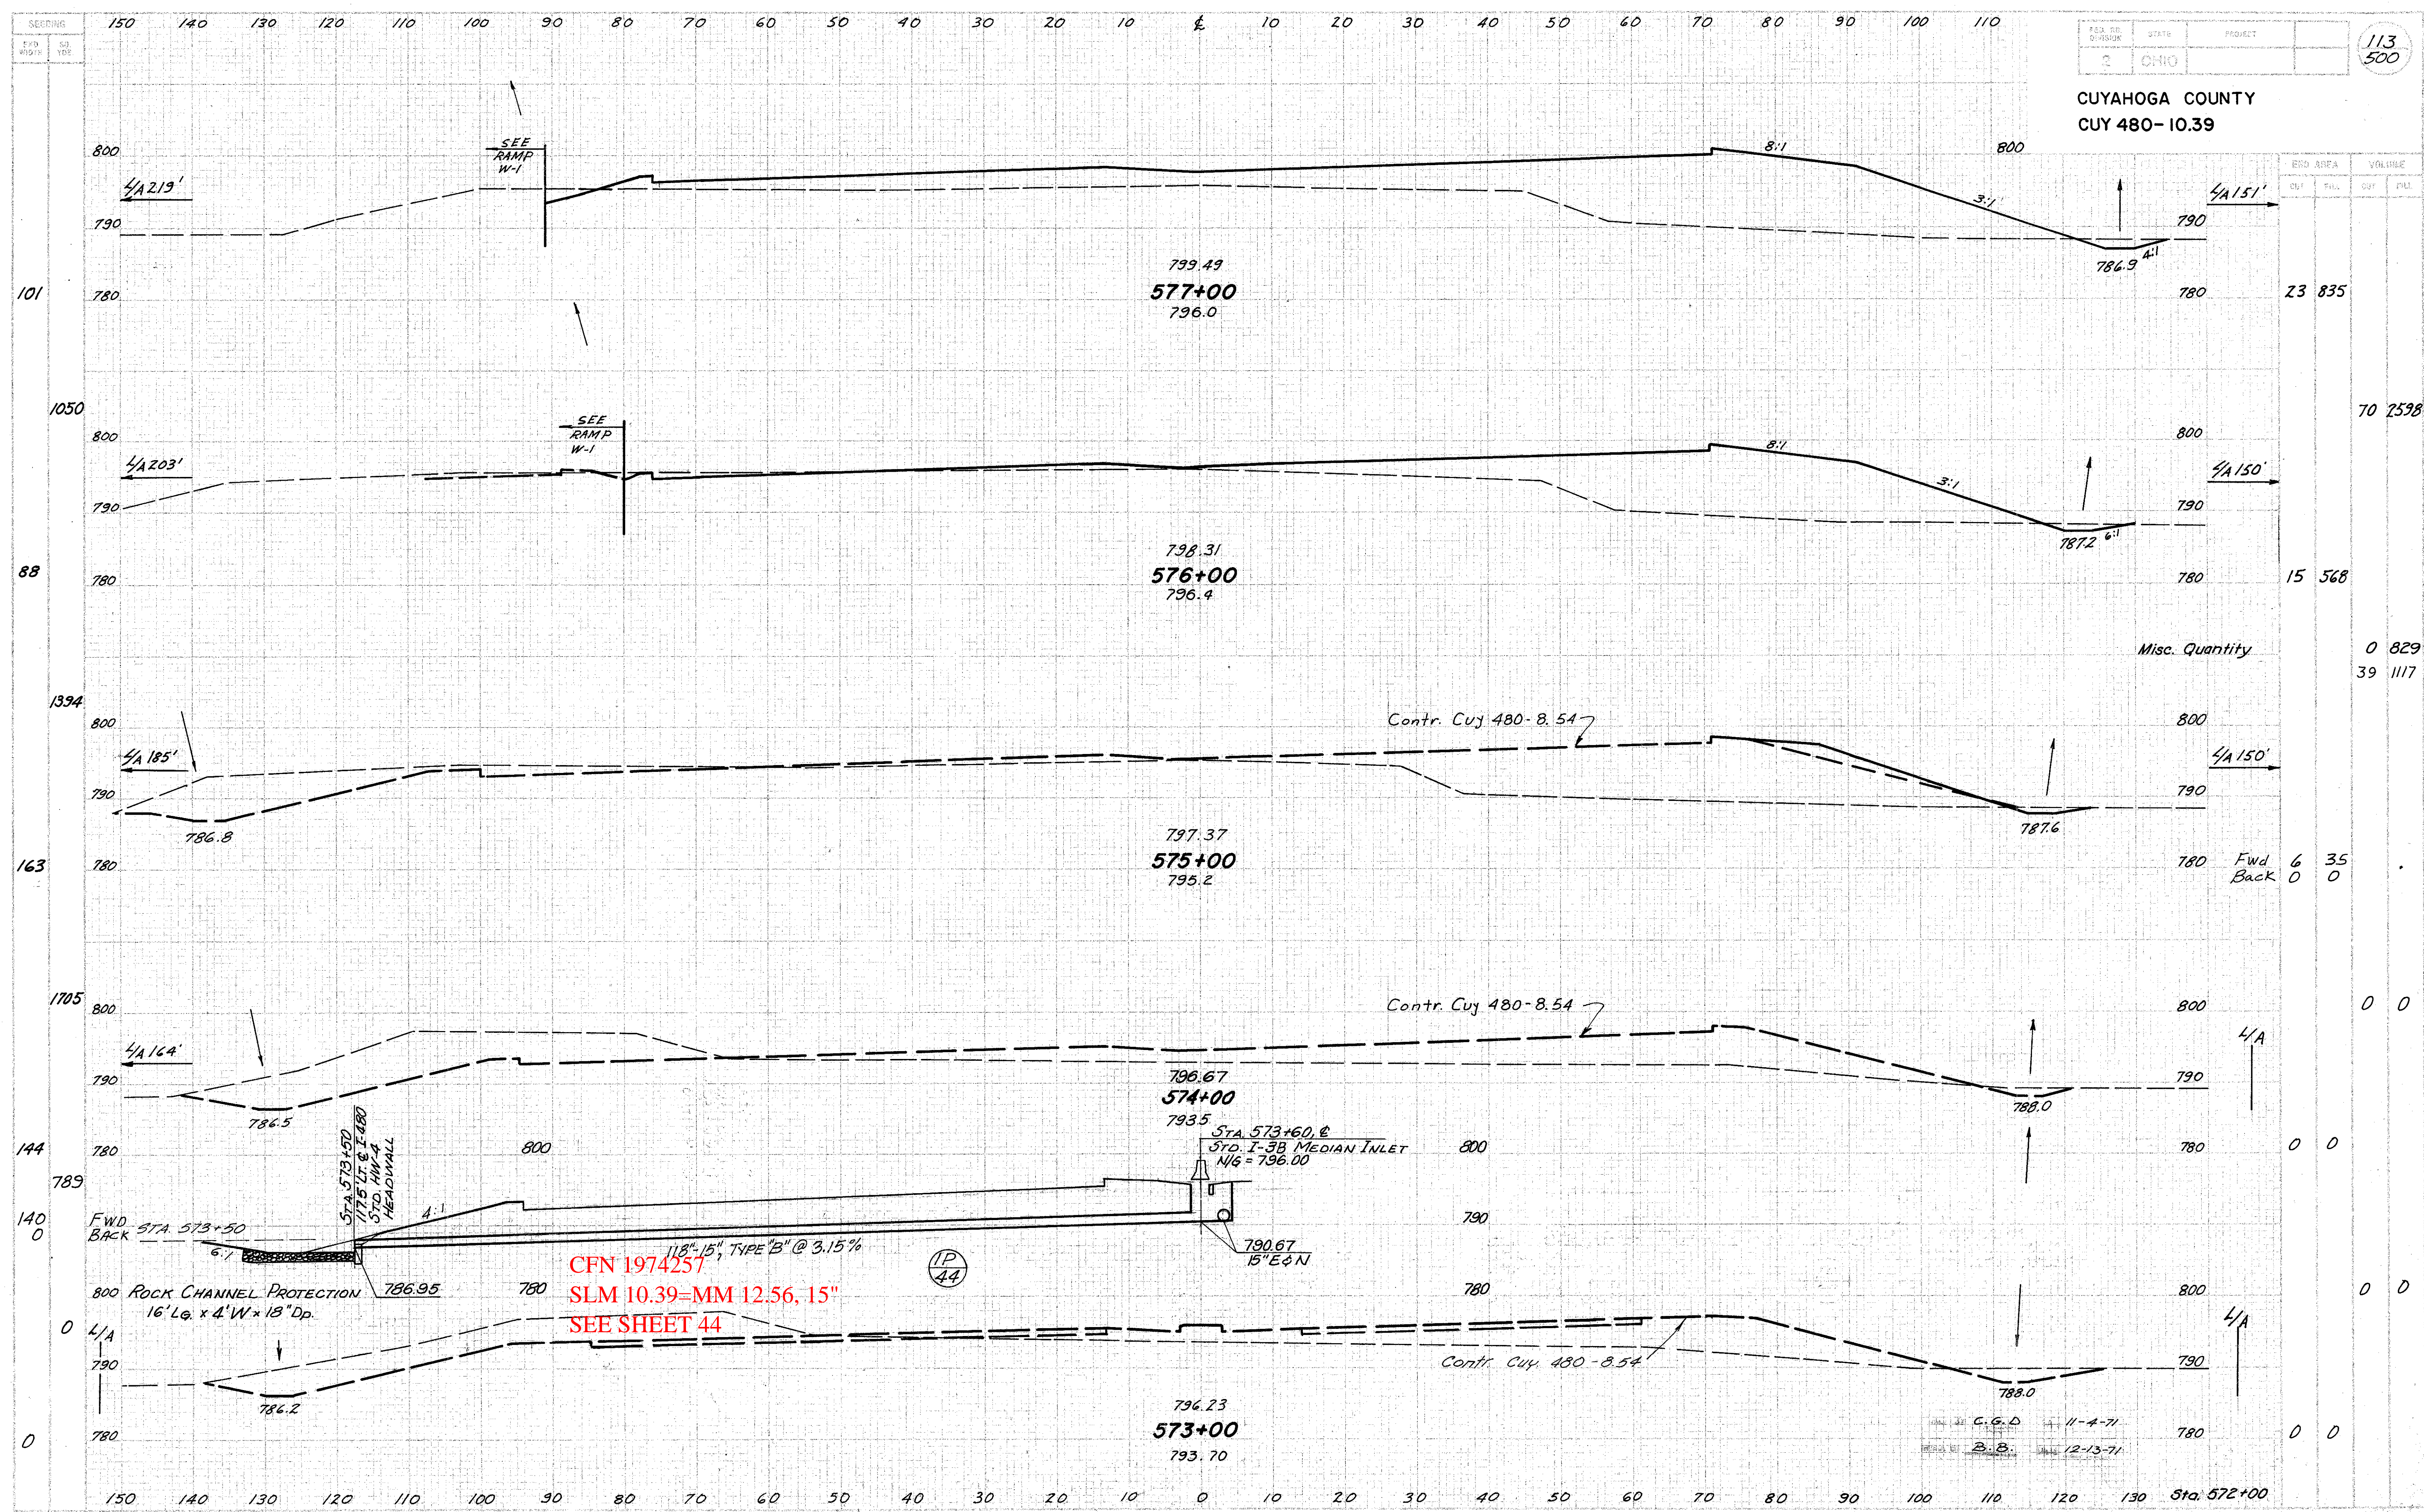

STATION	CROSS AREA		VOLUME	
	CUT	FILL	CUT	FILL
577+00			23	835
576+00			15	568
575+00			6	35
574+00			0	0
573+00			0	0
Misc. Quantity				
0 829				
39 1117				

CFN 1974257
SLM 10.39=MM 12.56, 15"
SEE SHEET 44

C.G.D. 11-4-71
B.B. 12-13-71

