

SLM 12.74, 15"
 SEE BELOW

CFN 1974353
 SLM 12.83, 15"
 SEE SHEET 131



CFN 1974345
 SLM 12.93, 15"
 SEE SHEET 132

SHT. No.	ITEM
44	SUPERELEVATION TABLE
93-94	RAMP R-1 PAVEMENT DETAIL
95-96	RAMP R-2 PAVEMENT DETAIL
60	RAMP R-1 PLAN & PROFILE
61	RAMP R-2 PLAN & PROFILE

SEE PLAN 1983 CUY-480-10.39
 SHEET 57

TREE REMOVAL
 700+00 TO 710+00

SIZE	No.
18"	175
30"	9

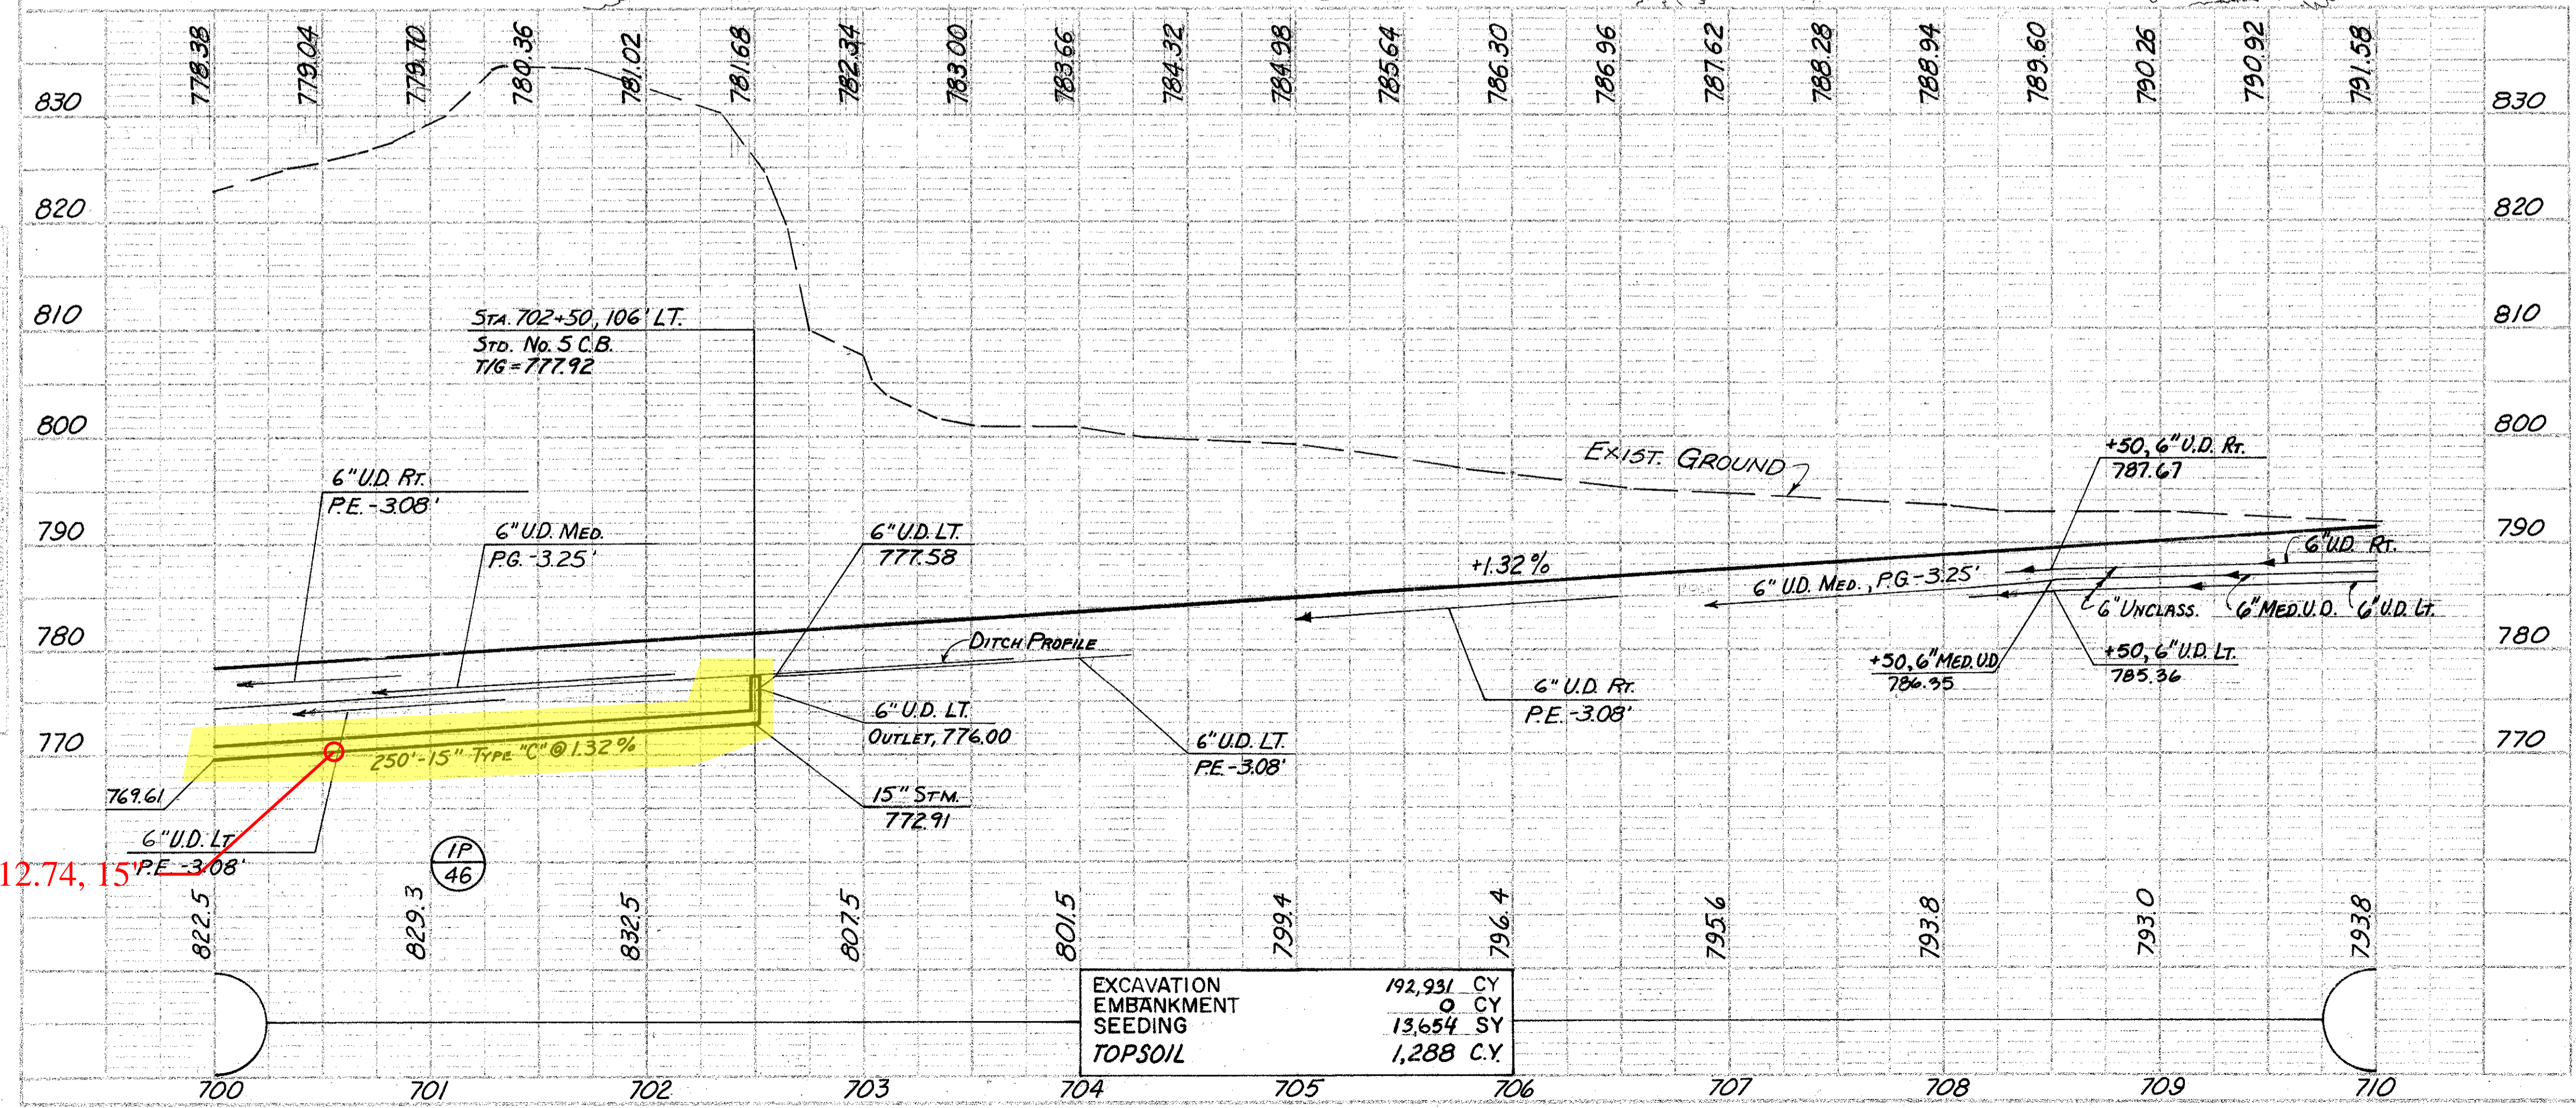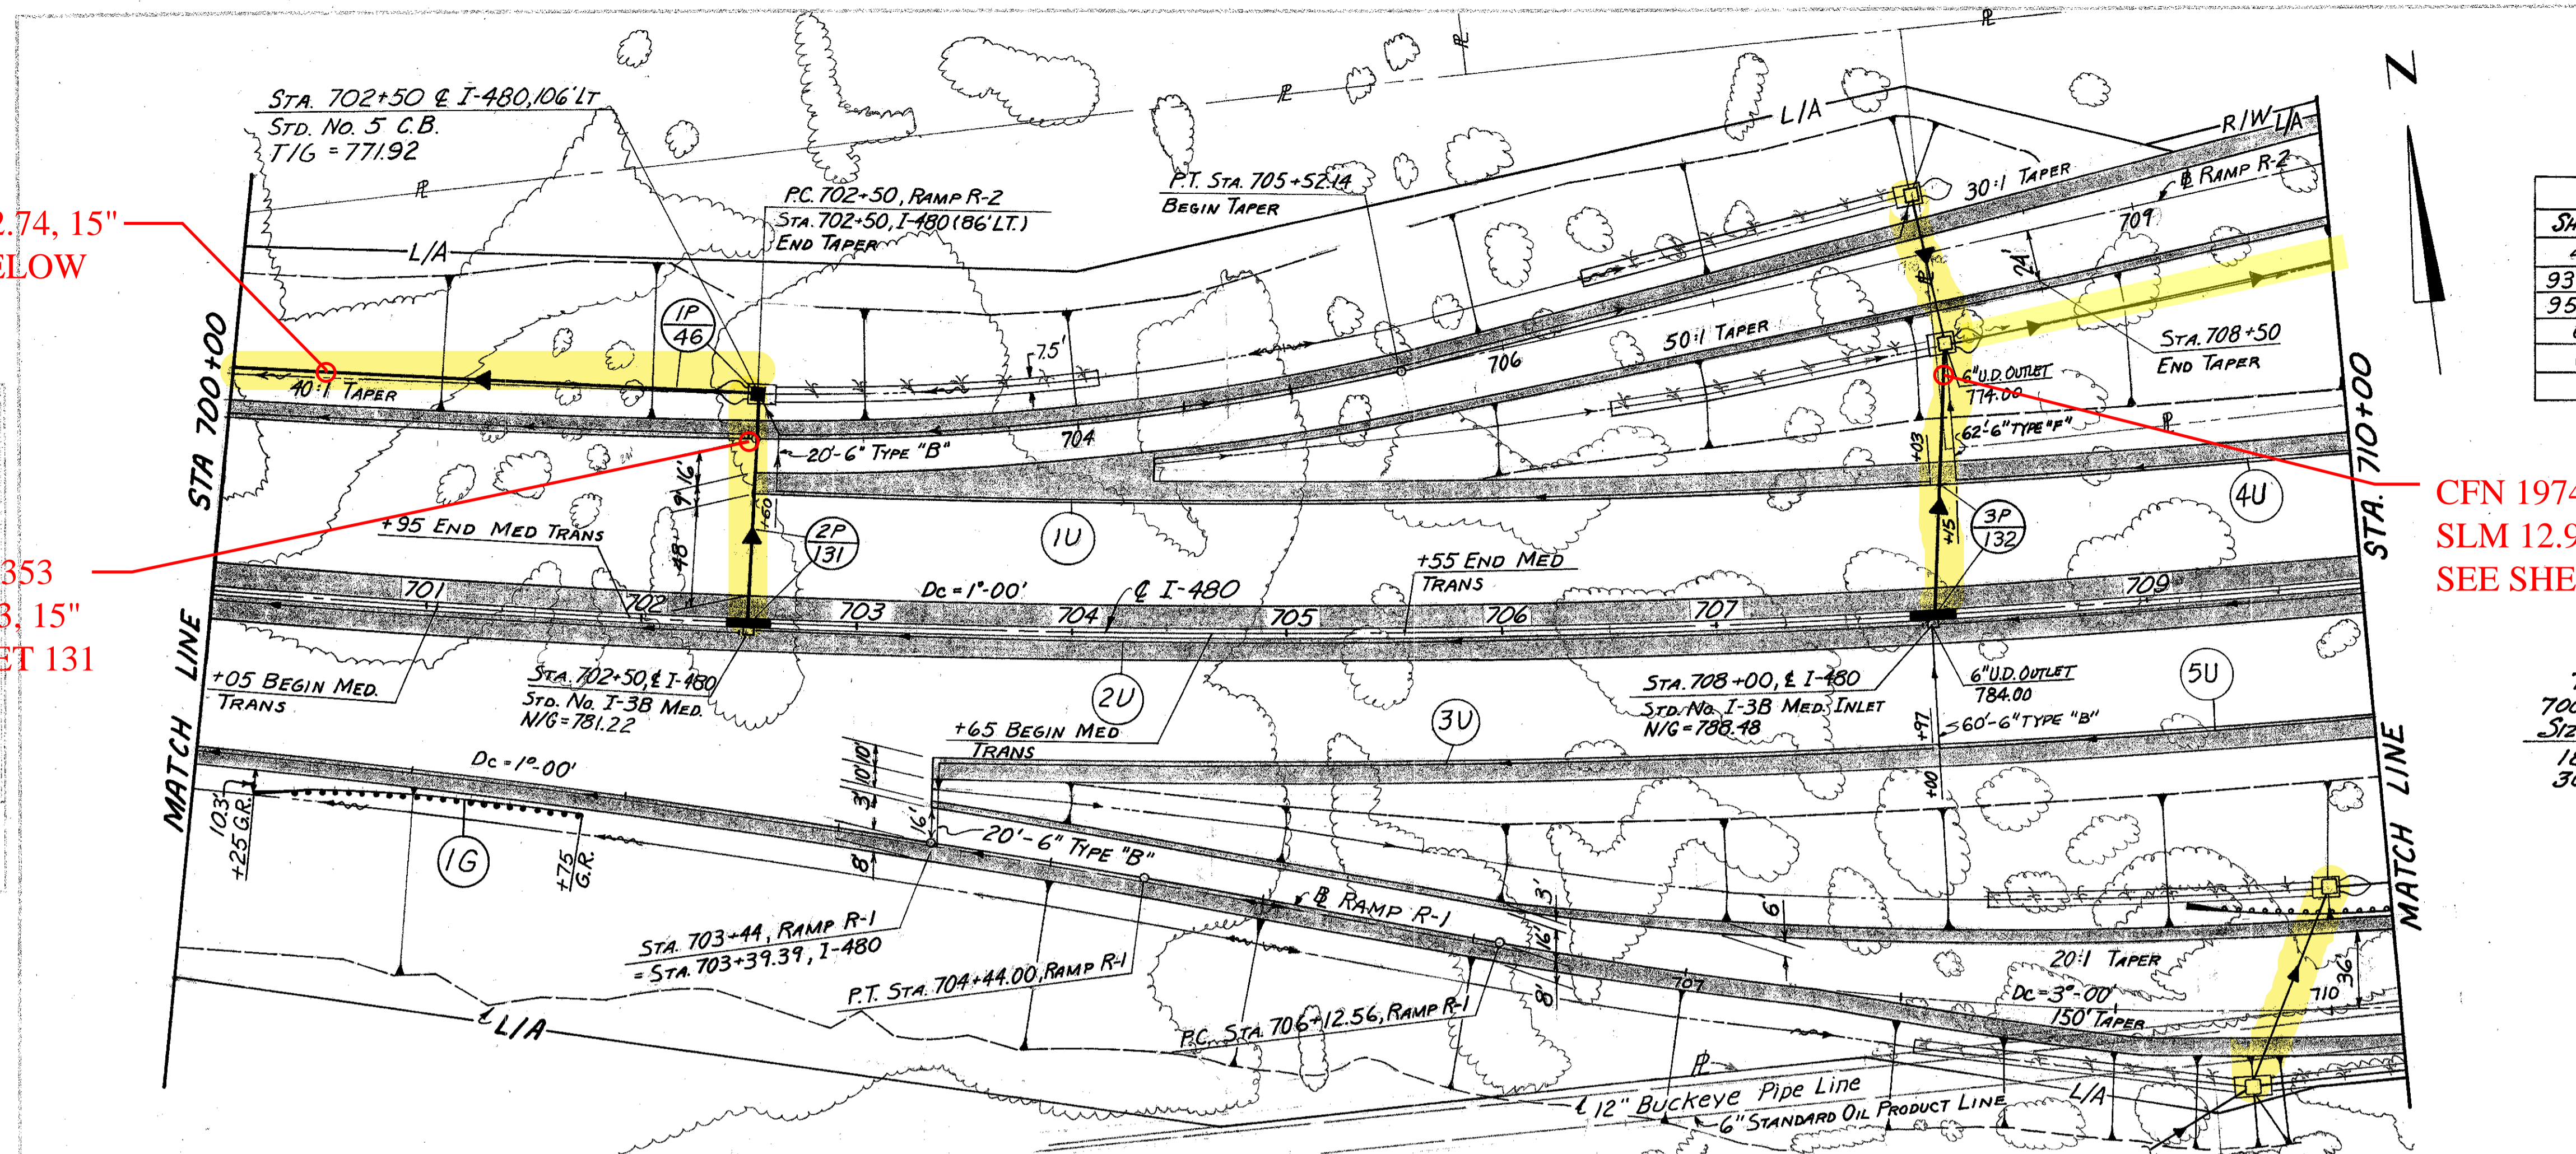

SLM 12.74, 15"

ITEM	UNIT	QTY	EST. QTY
SEEDING & EROSION CONTROL MATTING	EA	125	125
Anchor Assembly Type A	EA	1	1
Guardrail Type 5	EA	112.5	112.5
Anchor Assembly Type T	EA	1	1
UNCLASSIFIED UNDERDRAIN BENDS & BRANCHES	EA	296	296
Std. No. 5 C.B.	EA	1	1
Std. No. I-38 MEDIAN INLET	EA	2	2
TYPE "C"	LF	250	250
TYPE "B"	LF	106	230
TYPE "B"	LF	124	230
TYPE "F"	LF	82	100
ESTIMATED QUANTITIES			
REF. SIDE	LOCATION		
1P	700+00 TO 702+50		
2P	702+50		
3P	702+00		
1U	700+00 TO 708+03		
2U	700+00 TO 710+00		
3U	700+00 TO 707+97		
4U	708+15 TO 710+00		
5U	708+00 TO 710+00		
1G	700+25 TO 701+75		
CITY OF BROOKLYN TOTAL *		82	100
NOTE: QUANTITIES CARRIED TO SUB-SUMMARY			