CALC BY ALM 10/92
CHKD BY JJB 10/92

CUY-271-6.41

OHIO
FHWA REGION 5

64
145

SEEDING		END AREA		VOLUME	
END WIDTH	SQ. YDS.	CUT	FILL	CUT	FILL
63	718	35	9	7	17
17.85					
63	350	33	9	59	17
63	350	31	9		
63		25	9	52	17
				118	51

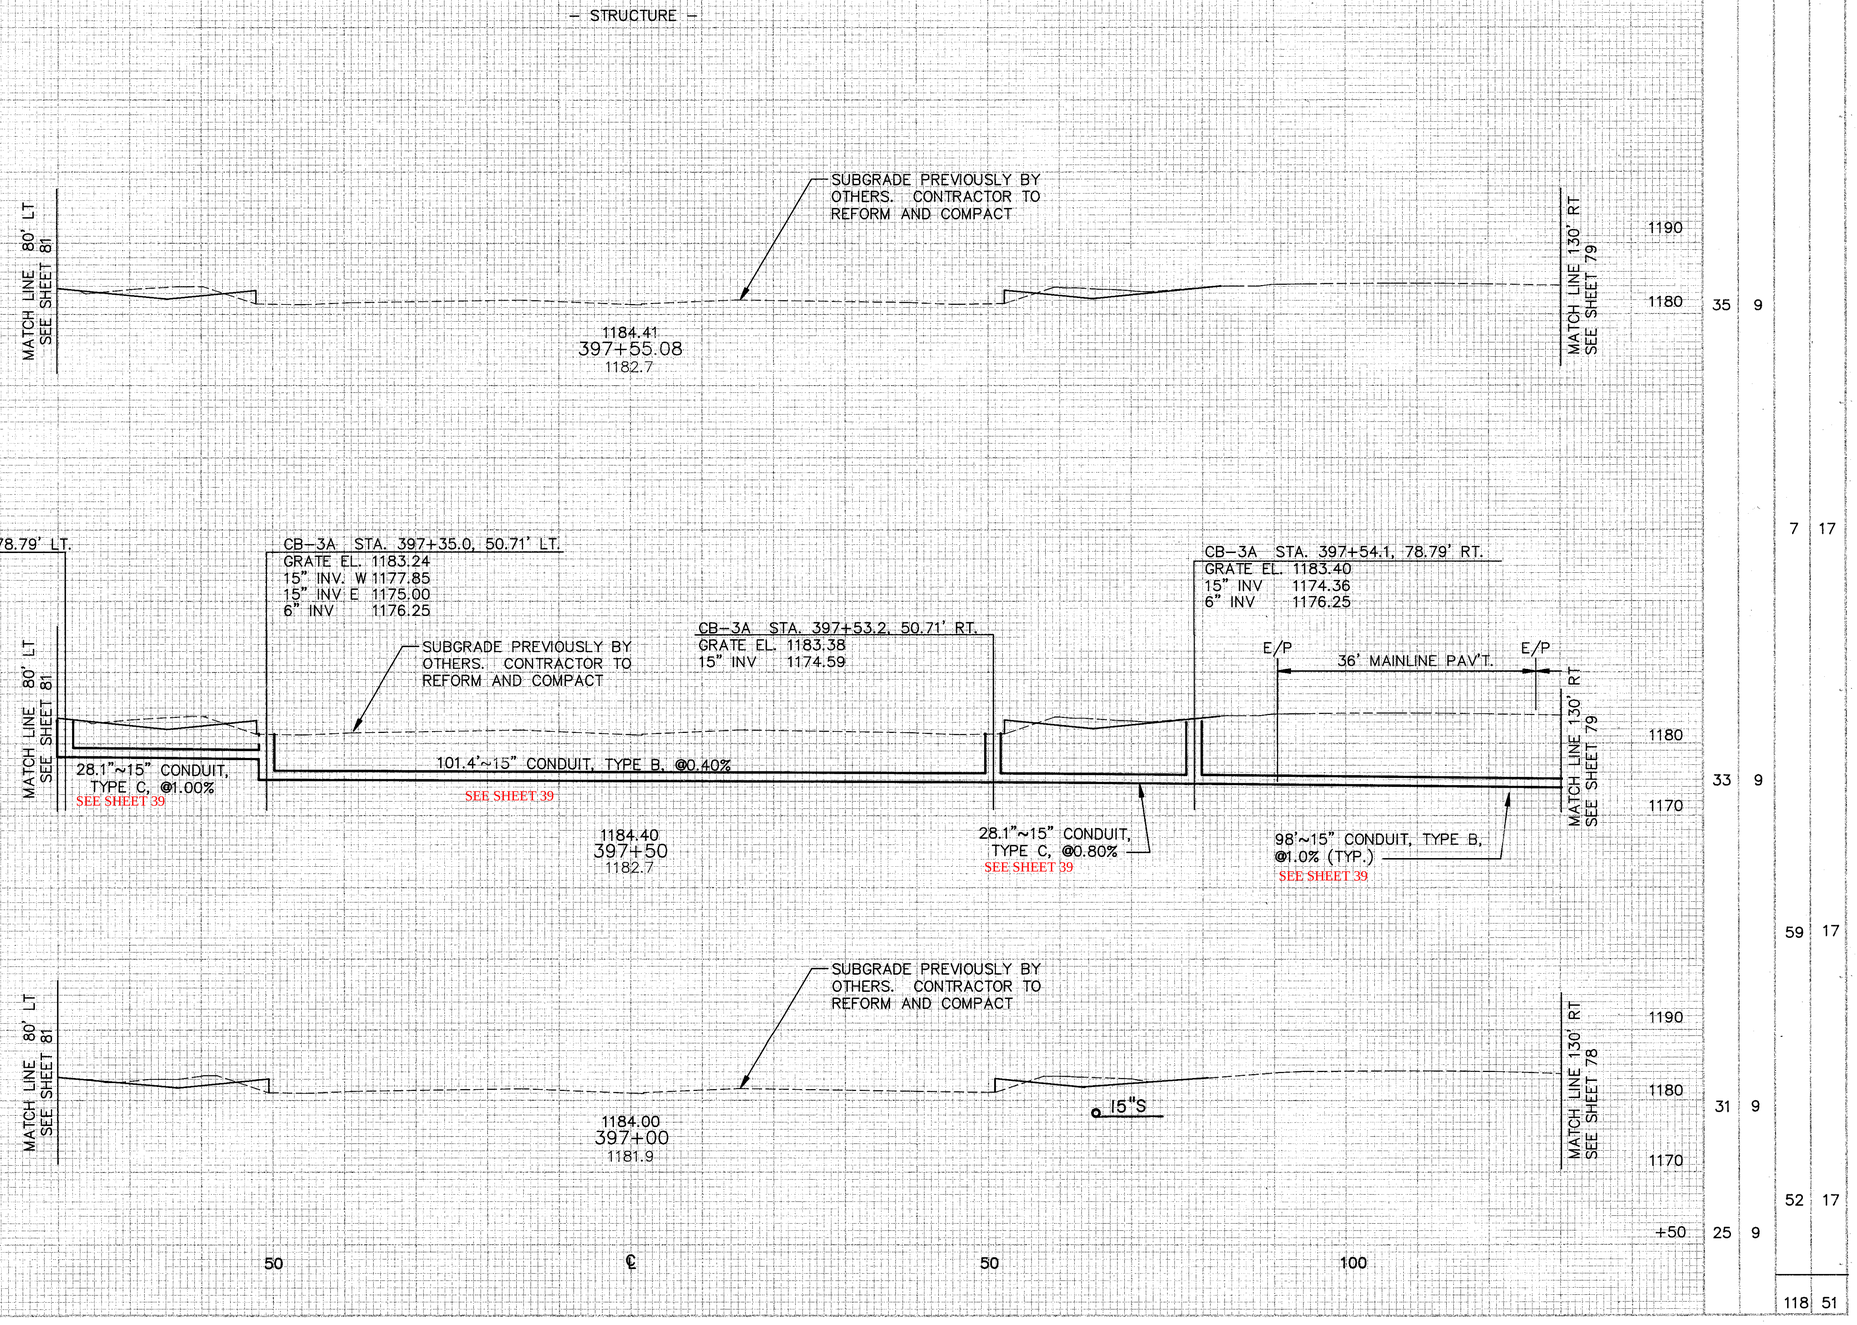

CROSS SECTIONS STA. 397+00 TO STA. 399+91.50

ACAD BLUEPRINT 020719