


SEEDING

END WIDTH (L.F.) AREA (S.Y.)

CALC. BY M.A.F. DATE 12/93  
 CHKD. BY P.J.P. DATE 1/94  
 OHIO REGION 5  
 CUYAHOGA COUNTY  
 CUY-271-6.53

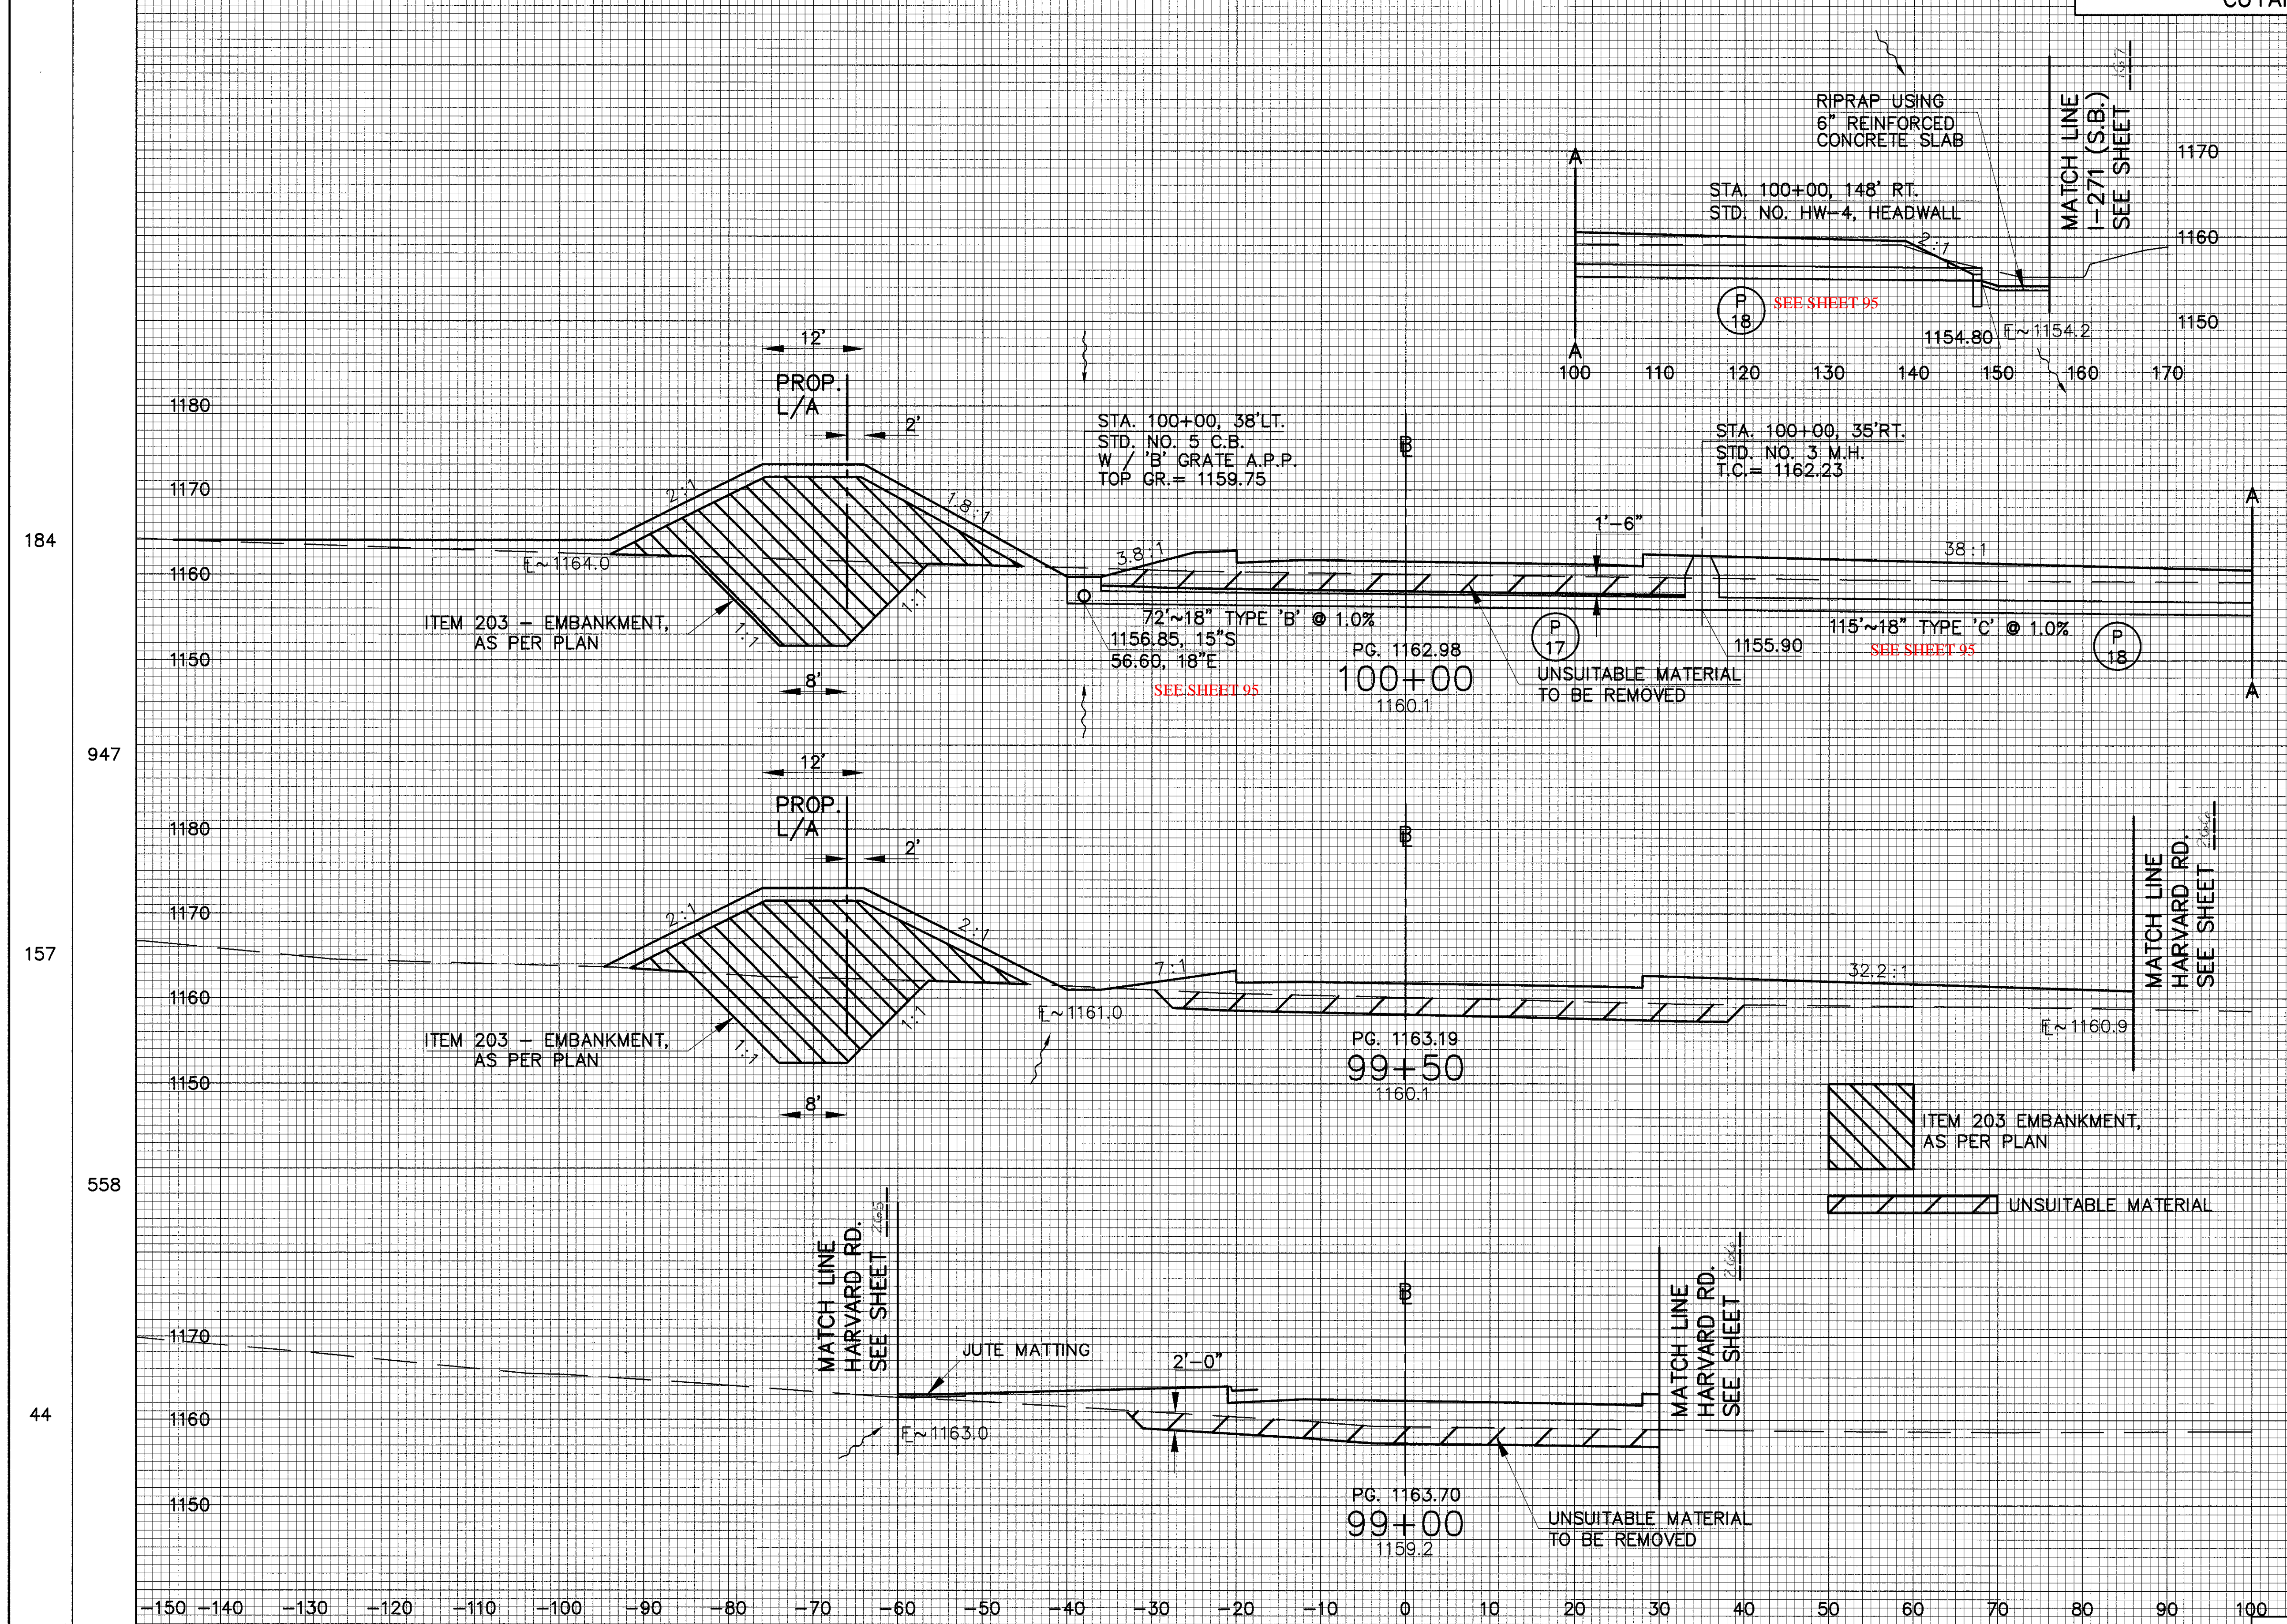

EMBANKMENT, AS PER PLAN		EARTHWORK			
END AREA (S.F.)	VOLUME (C.Y.)	END AREA (S.F.)		VOLUME (C.Y.)	
		CUT	FILL	CUT	FILL
486	318	546			
907			577	948	
494	306	479			
457			404	757	
0	131	339			
TOTAL	1364	TOTAL	981	1705	

TOTAL 1505

STA. 99+00 TO STA. 100+00  
 RAMP S-WE CROSS SECTIONS