

CALC.
BY _____
DATE _____
CHKD.
BY _____
DATE _____

CUY-271-6.53

OHIO

F.H.W.A.
REGION 5


85
394

CUYAHOGA COUNTY

Low Priority Outfall
CUY13036L (Pipe)

Low Priority Outfall
CUY13034L (Pipe)

Low Priority Outfall
CUY13511R (Pipe)

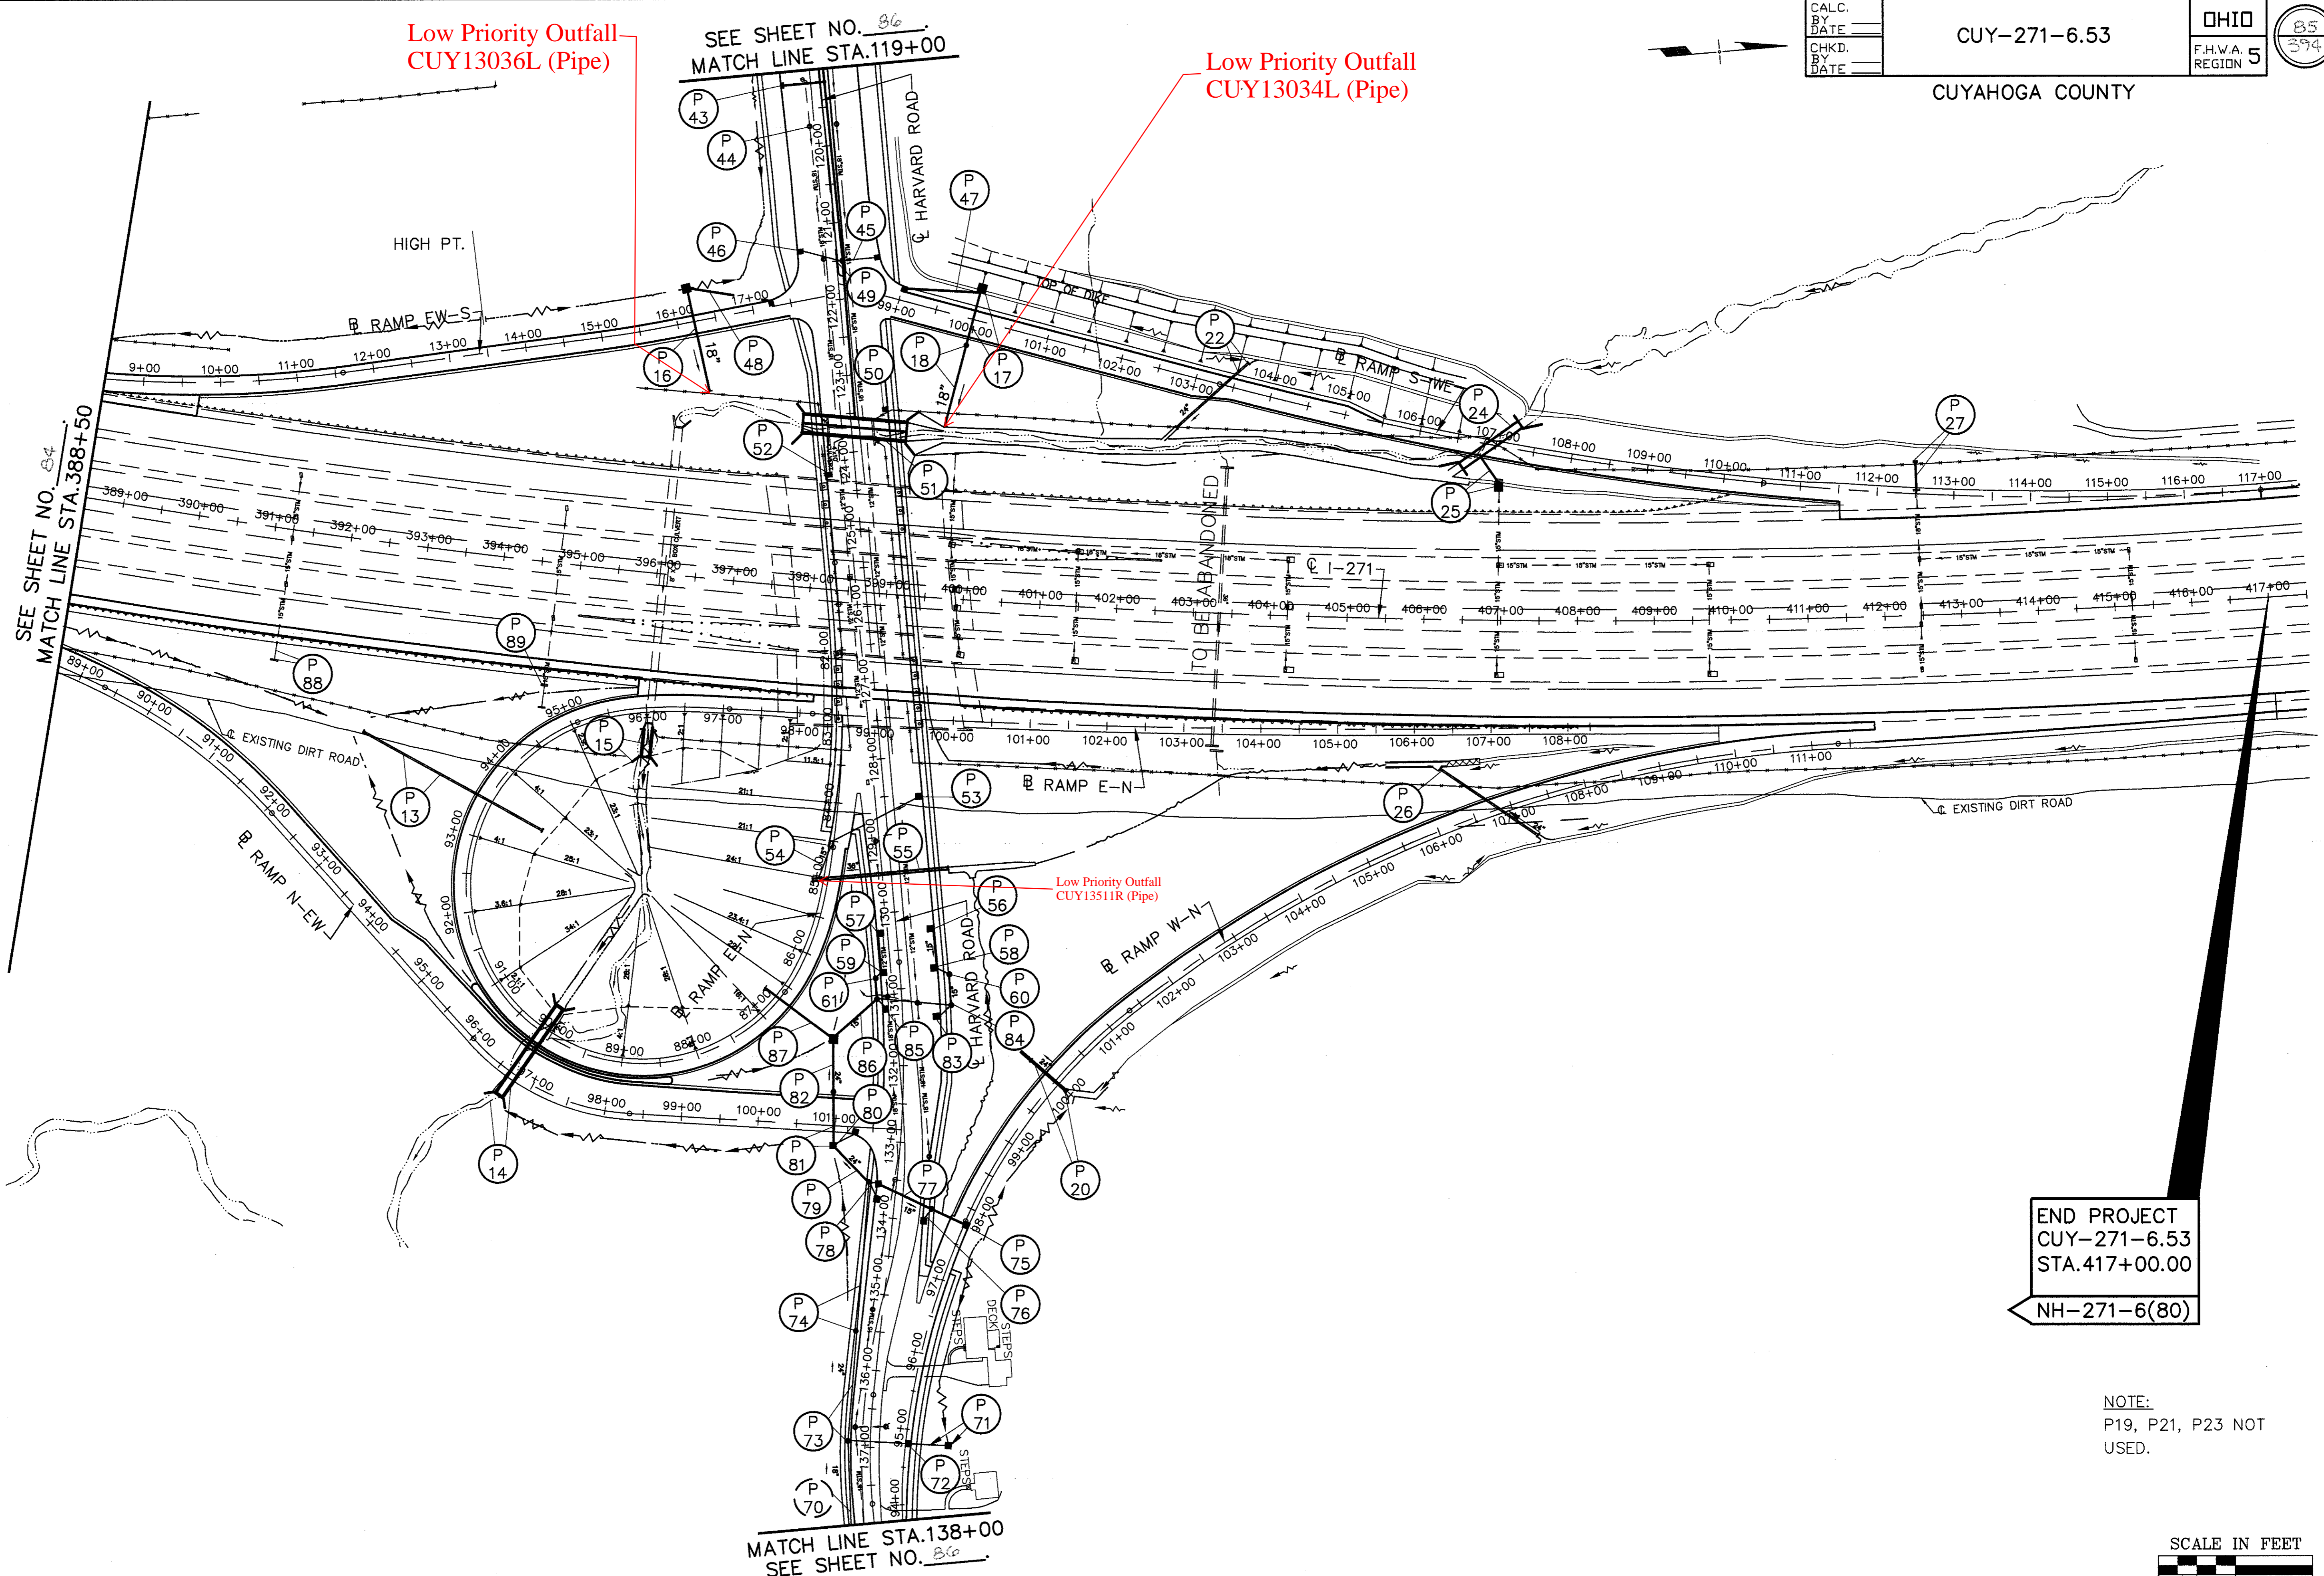

SEE SHEET NO. *B4*
MATCH LINE STA. 388+50

SEE SHEET NO. *B6*
MATCH LINE STA. 119+00

MATCH LINE STA. 138+00
SEE SHEET NO. *B6*

END PROJECT
CUY-271-6.53
STA. 417+00.00
NH-271-6(80)

NOTE:
P19, P21, P23 NOT
USED.

SCALE IN FEET
0 50 100 200

DESIGNED BY: EJK
DATE: 10/5/93
DRAWN BY: T.K.L.
DATE: 10/5/93
CAD FILE NAME: 7014900-271DRS63

DRAINAGE SCHEMATIC