old CFN 283220565
new CFN 1850935
SLM 5.65, 12" VCP
SEE SHEET 28

Rockhaven Road
SLM 5.65

old CFN 283220567
new CFN 1851530
SLM 5.67, 3'x1.5'
CONCRETE BOX
SEE SHEET 29

old CFN 283220595
new CFN 1833265
SLM 5.95, 12" VCP
SEE SHEET 29

FED. RD. DIST. NO.	STATE	FED. AID. PROJECT	FISCAL YEAR
10	OHIO	469-B	1928

I.C.H. 15 SEC. -H.
GEAUGA COUNTY

5/38

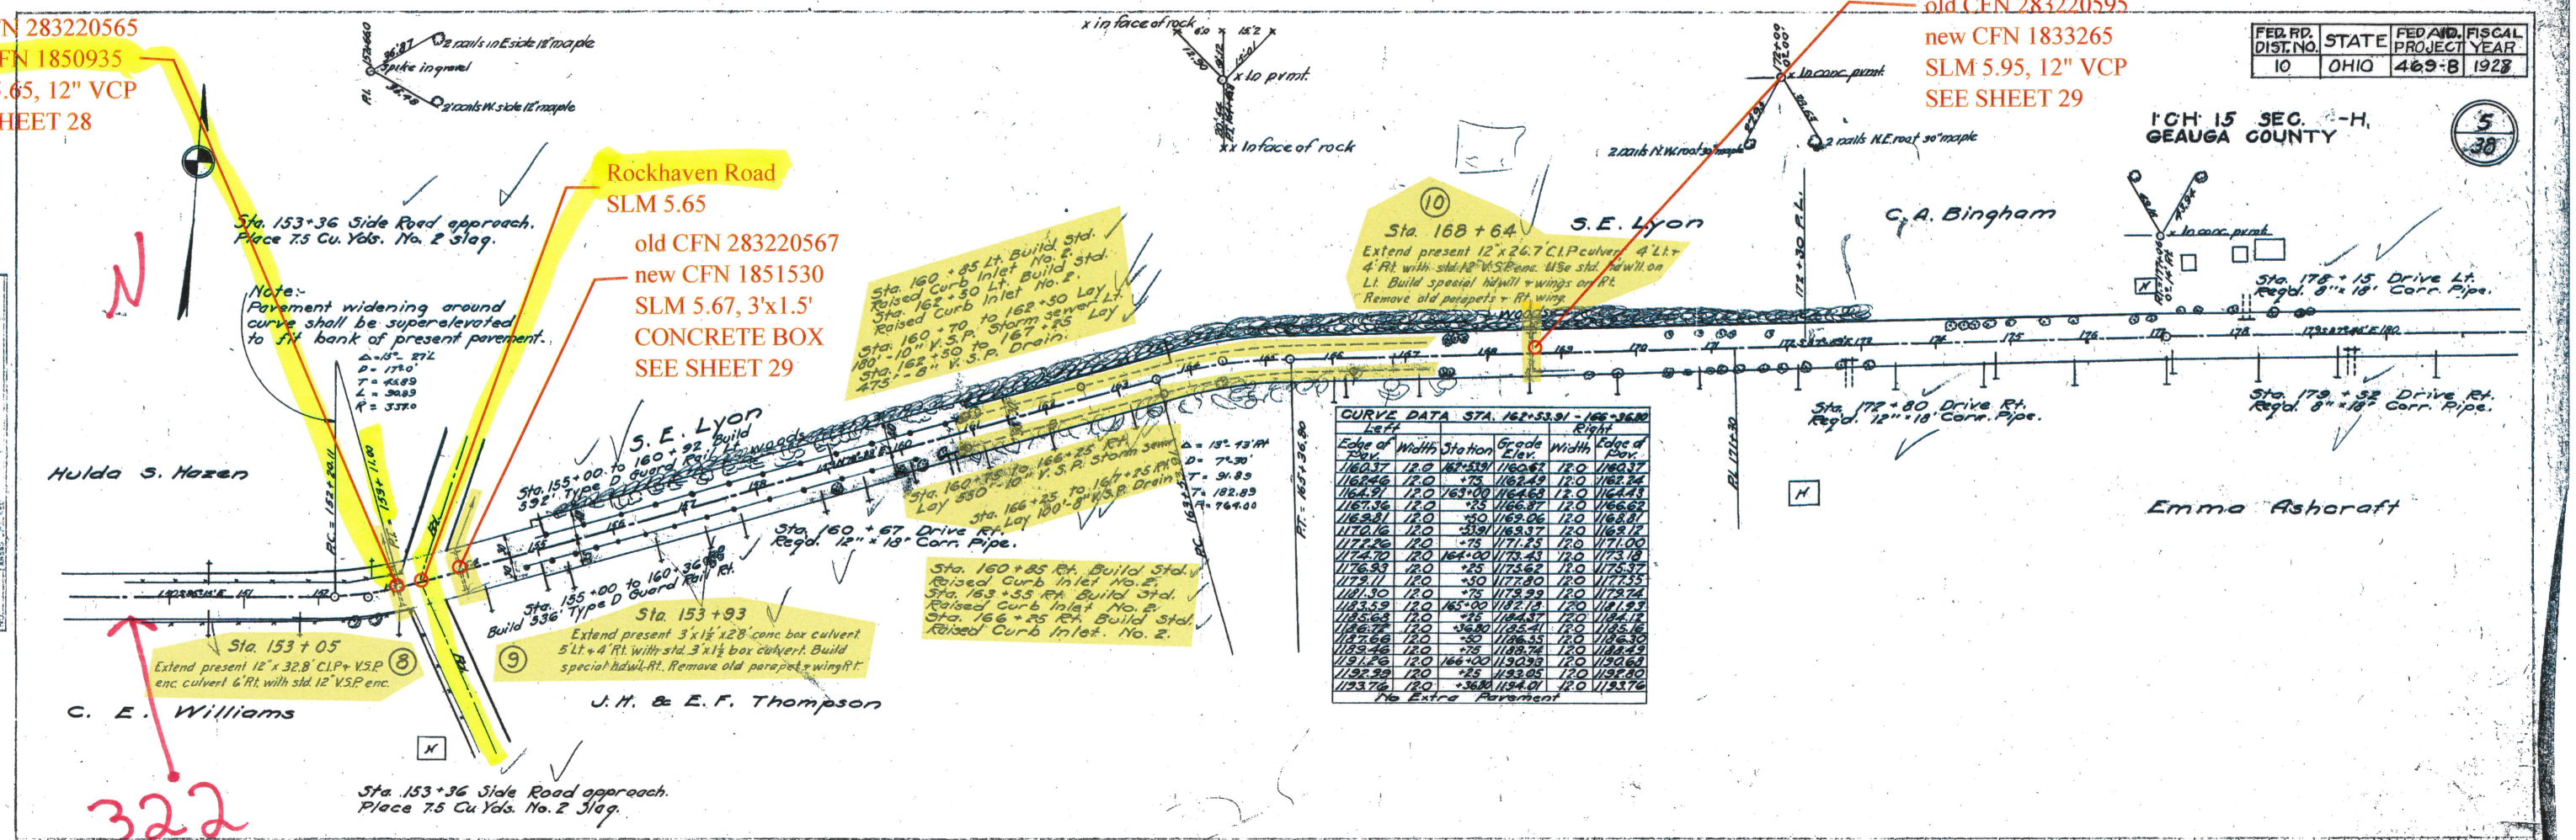

CURVE DATA STA. 162+53.91 - 166+36.80

Left Edge of Pav.	Left Width	Station	Grade Elev.	Right Width	Right Edge of Pav.
160.37	12.0	167+53.9	160.62	12.0	160.37
162.46	12.0	+75	162.49	12.0	162.24
164.91	12.0	163+00	164.68	12.0	164.43
167.36	12.0	+25	166.87	12.0	166.62
169.81	12.0	+50	169.06	12.0	168.81
170.16	12.0	+53.91	169.37	12.0	169.12
172.26	12.0	+75	171.25	12.0	171.00
174.70	12.0	164+00	173.43	12.0	173.18
176.93	12.0	+25	175.62	12.0	175.37
179.11	12.0	+50	177.80	12.0	177.55
181.30	12.0	+75	179.99	12.0	179.74
183.59	12.0	165+00	182.18	12.0	181.93
185.64	12.0	+25	184.37	12.0	184.12
186.72	12.0	+36.80	185.41	12.0	185.16
187.66	12.0	+50	186.55	12.0	186.30
189.46	12.0	+75	188.74	12.0	188.49
191.26	12.0	166+00	190.92	12.0	190.67
192.99	12.0	+25	193.05	12.0	192.80
193.76	12.0	+36.80	194.01	12.0	193.76

No Extra Pavement