


FOR DETAILS ON CULVERT D-2 SEE SHEET 201  
FOR PAVEMENT DETAILS SEE SHEET 168

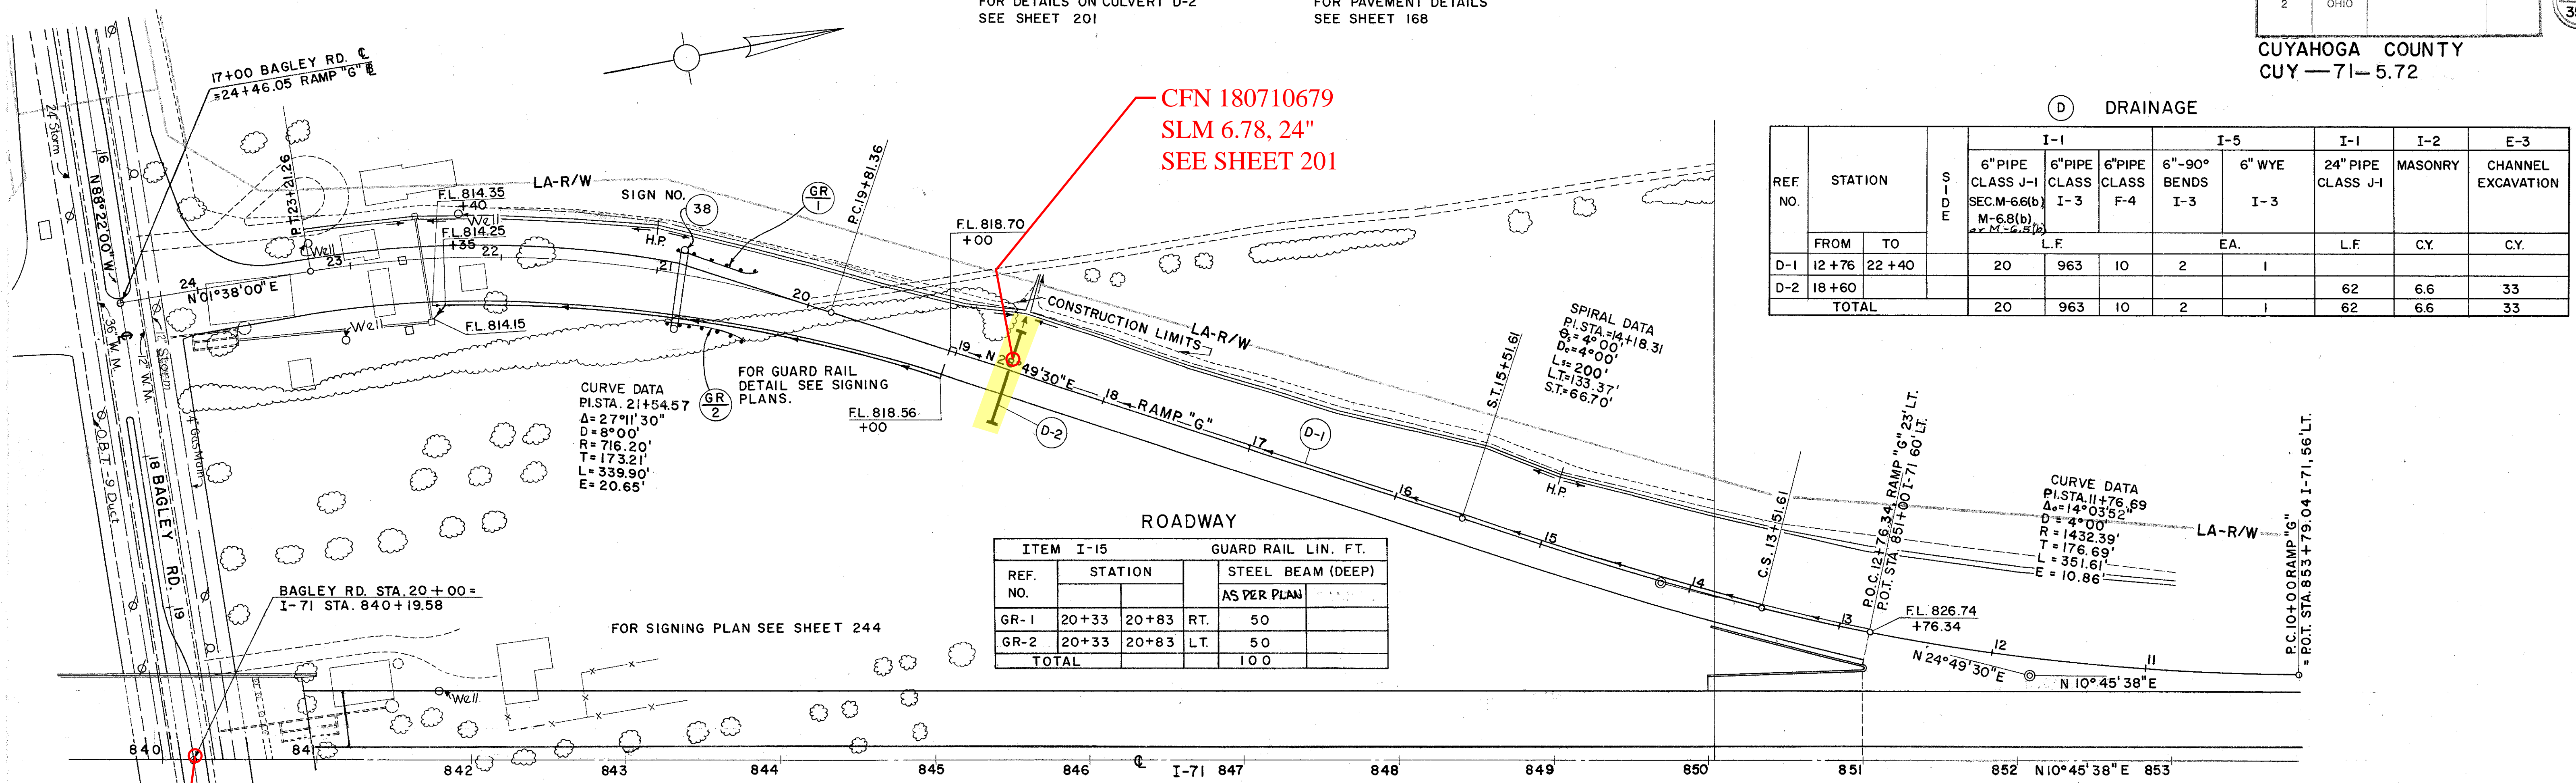

BAGLEY ROAD  
SLM 6.68 = MM 235.39

