


FED. RD. DIVISION	STATE	PROJECT	FISCAL YEAR
2	OHIO		

184  
353

CUYAHOGA COUNTY  
CUY-71-5.72

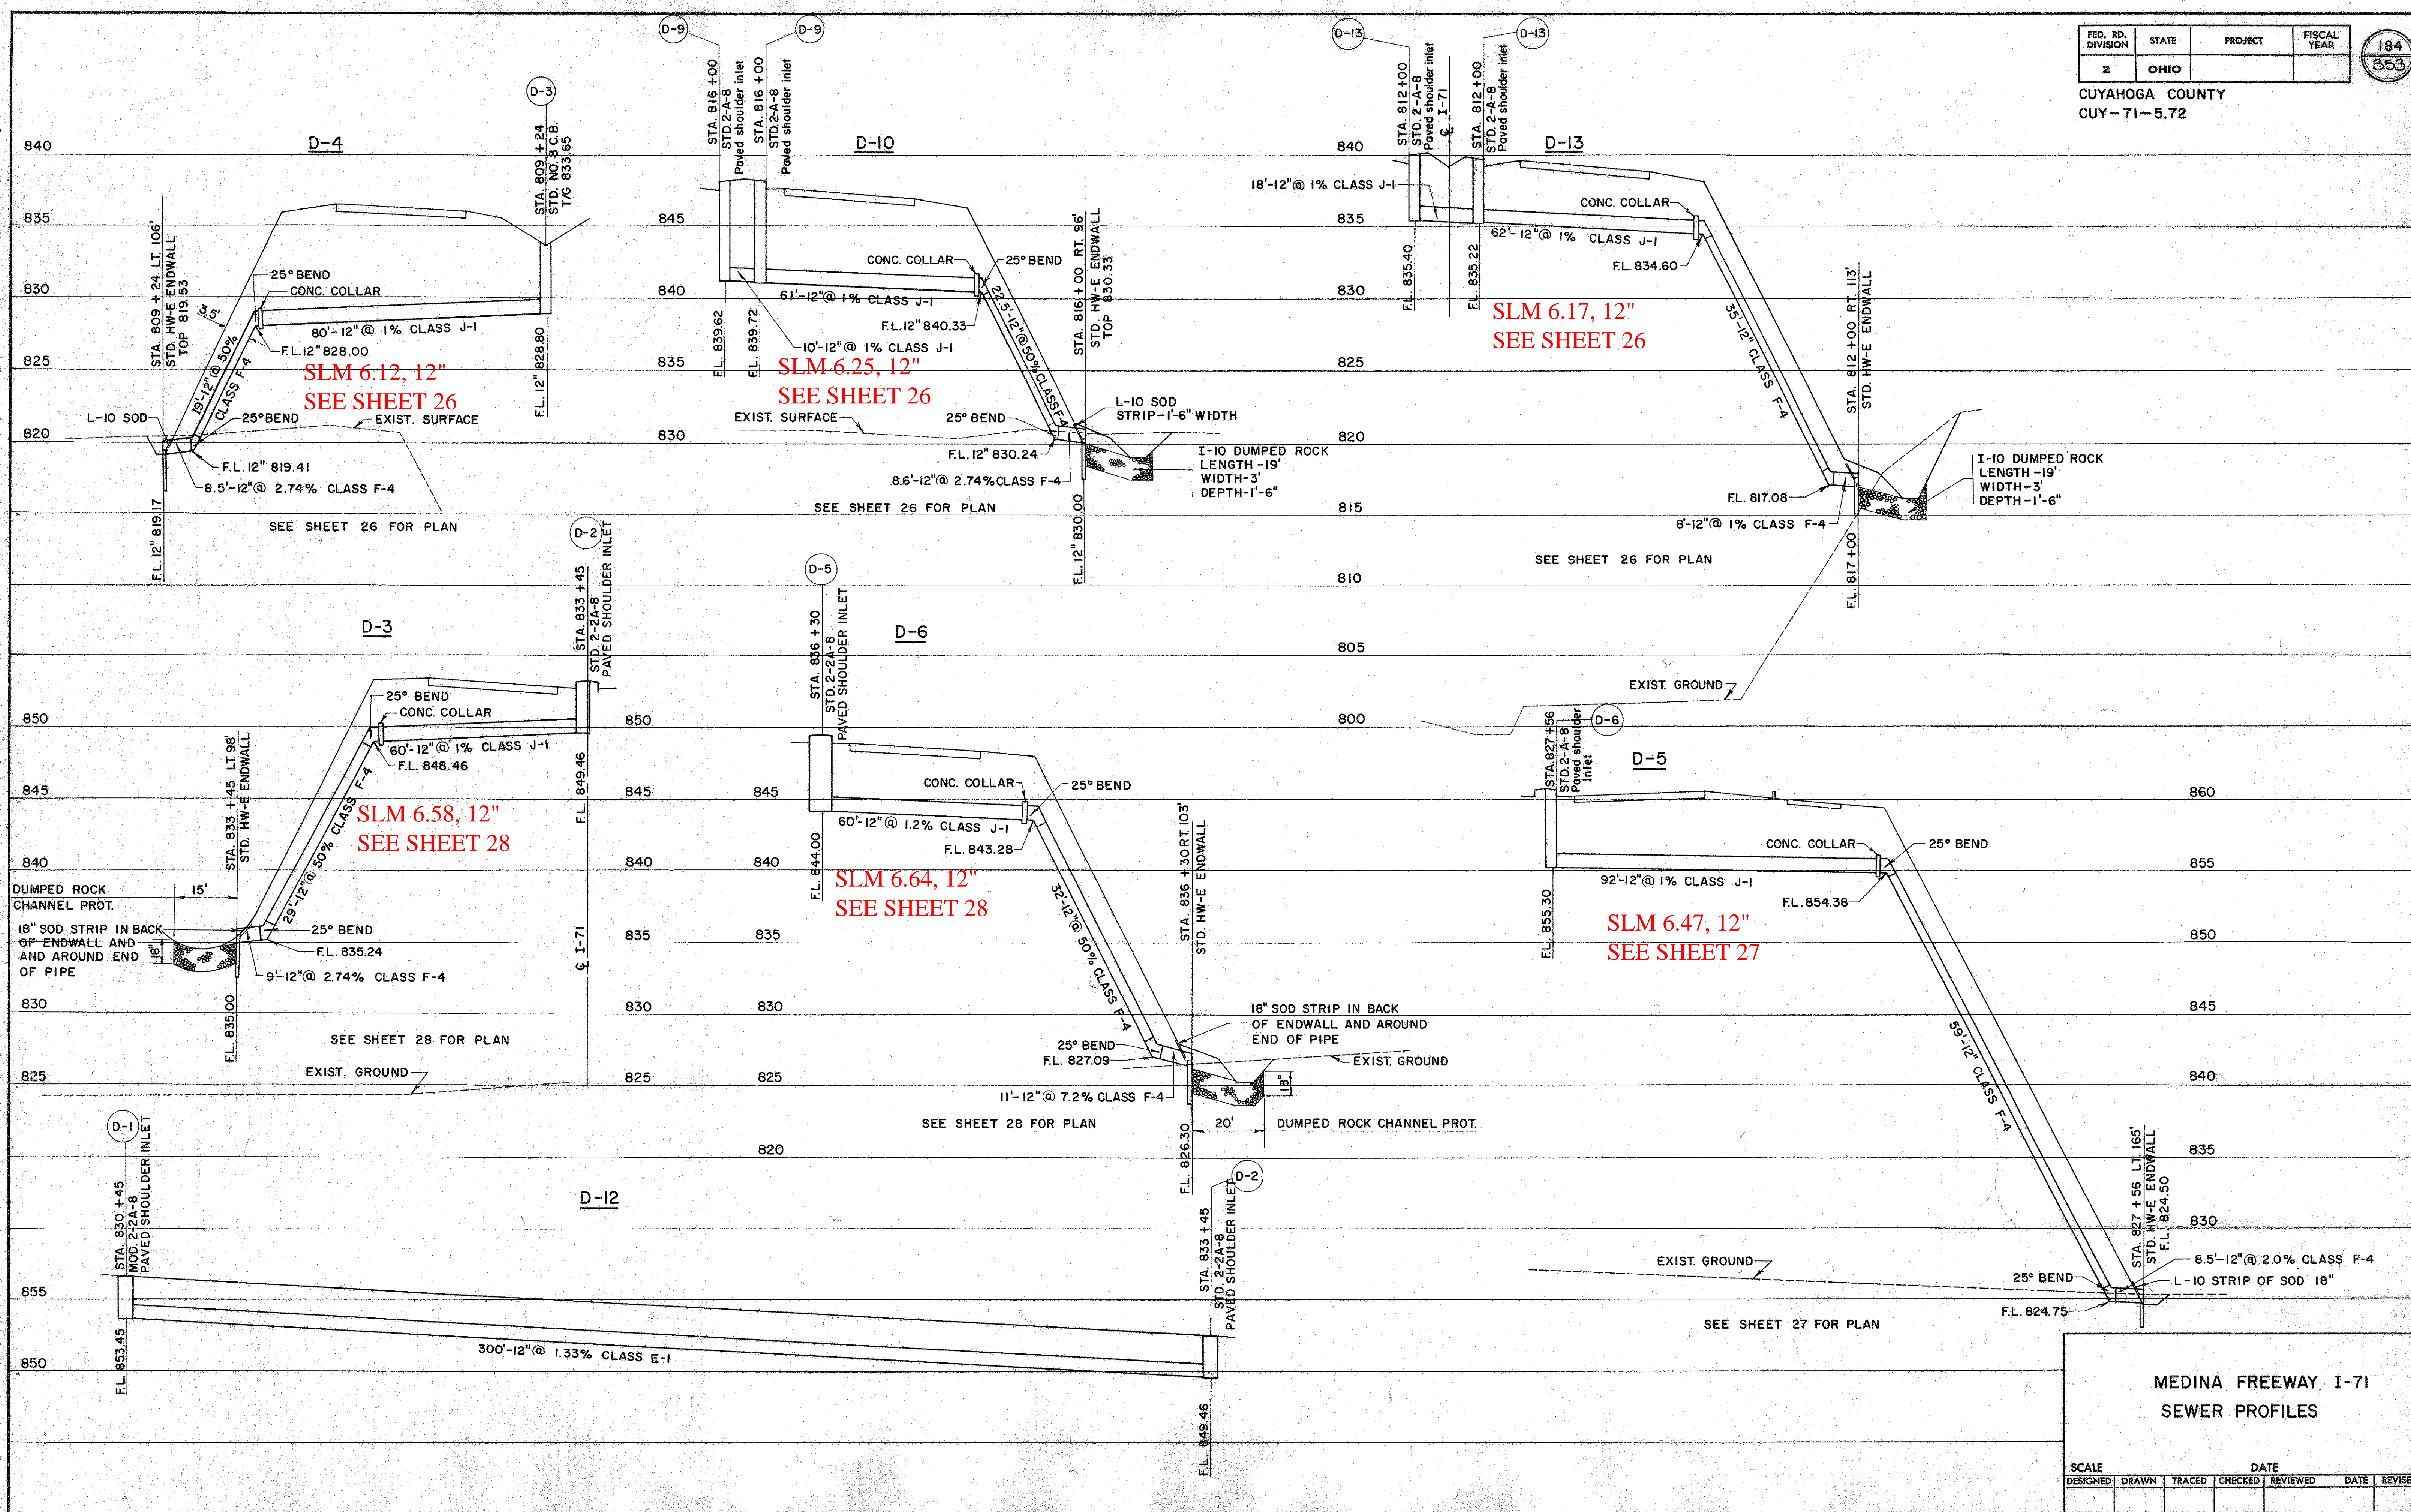

MEDINA FREEWAY I-71  
SEWER PROFILES

SCALE		DATE			
DESIGNED	DRAWN	TRACED	CHECKED	REVIEWED	DATE