FED. RD. DIVISION	STATE	PROJECT		231
2	OHIO			

CUYAHOGA COUNTY
CUY-71-15.06

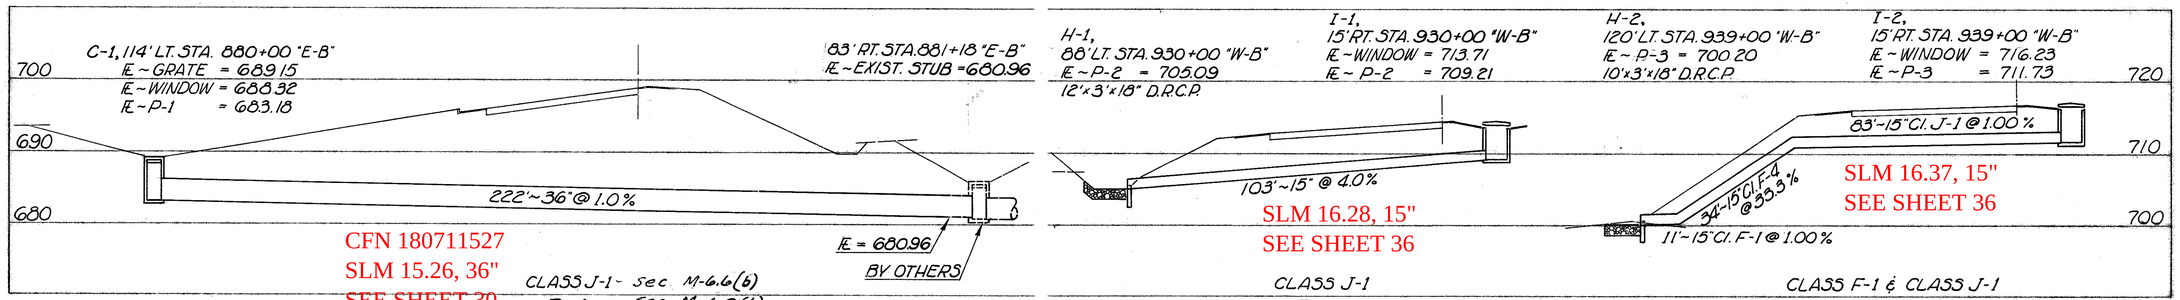

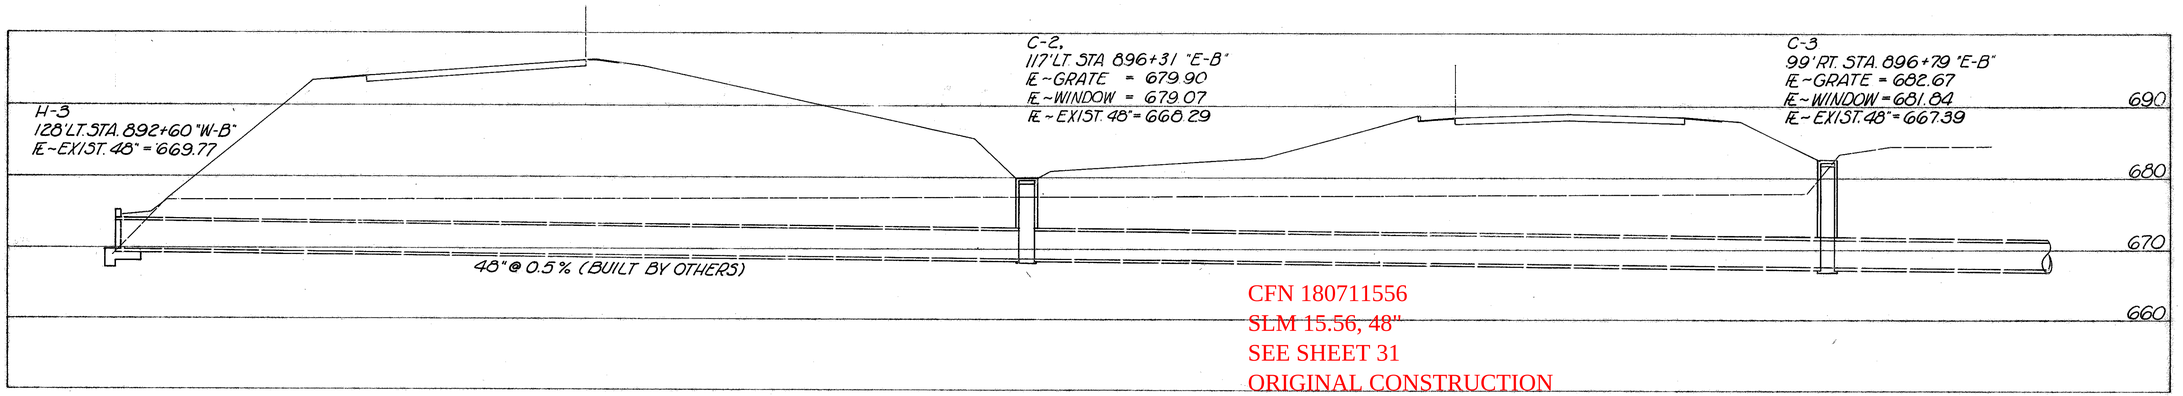

ESTIMATED QUANTITIES

PIPE REFERENCE	STRUCTURES INCLUDED	I-10 SODDING SQ.YDS.	I-1 CLASS F-4 15" LIN.FT.	I-1 CLASS J-1 Sec. M-6.6(6) 15" LIN.FT.	I-1 CLASS J-1 Sec. M-6.6(6) 36" M-6.8(6)	I-2 MASONRY CU.YDS.	I-5 15" Cl. F-4 PIPE SPECIAL 30° BENDS EACH	I-8 STANDARD REINF. CONC. CATCH BASIN No. 2-5 MODIFIED AS PER R.M. EACH	I-8 SPECIAL INLETS No. 2-6 EACH	I-8 SPECIAL INLETS No. 2-12 EACH	I-8 C.B. No. 2-4 EACH	I-10 DUMPED ROCK CHANNEL PROTECT CU.YDS.	SEE SHEET NO.
								See Sh. 15					
P-1	C-1			222							1		29
P-2	H-1, I-1	2		103		0.26				1		2.0	30
P-3	H-2, I-2	2	45	83		0.26	2		1			1.7	30
EXIST. 48"	C-2, C-3, H-3	4				8.7		2					31
	TOTALS	8	45	186	222	9.2	2	2	1	1		4	

DRAINAGE PROFILES P-1, P-2, & P-3