FED. RD. DIVISION	STATE	PROJECT	
2	OHIO		

232

CUYAHOGA COUNTY
CUY-71-15.06

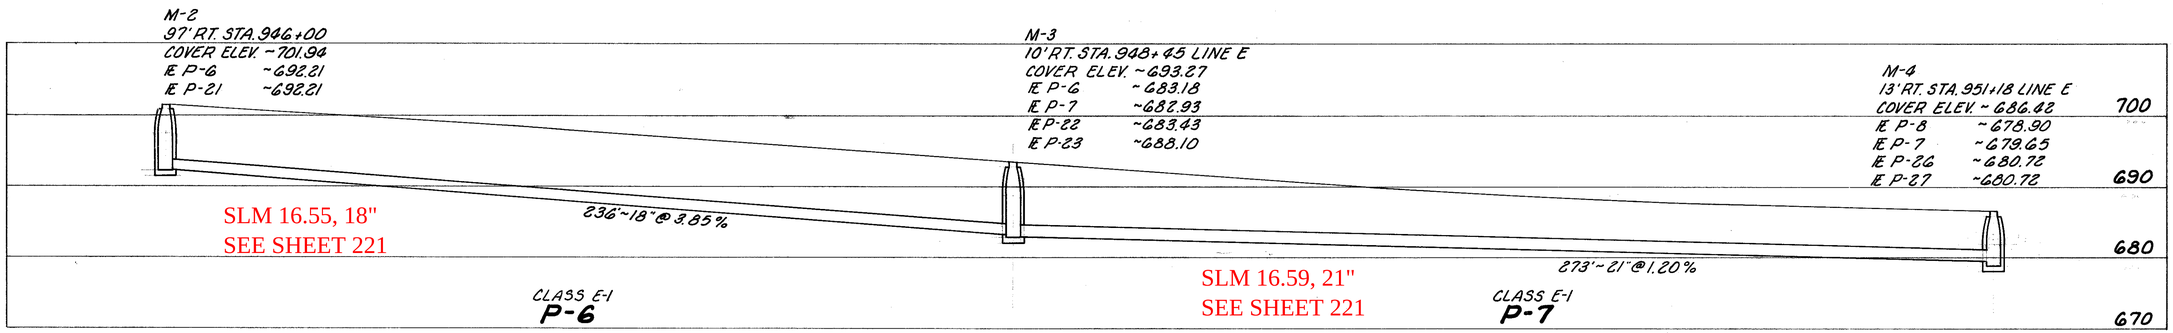

ESTIMATED QUANTITIES

PIPE REFERENCE	STRUCTURES INCLUDED	I-1 CLASS E-1 18" L.F.	I-1 CLASS E-1 21" L.F.	I-8 STANDARD NO.1 MANHOLE EA.	SEE SHEET NO.
	M-2			1	
P-6	M-3	236		1	221
P-7	M-4		273	1	221
	TOTALS	236	273	3	

DRAINAGE PROFILES P-6 & P-7