FED. RD. DIVISION	STATE	PROJECT	
2	OHIO		

233

CUYAHOGA COUNTY
CUY-71-15.06

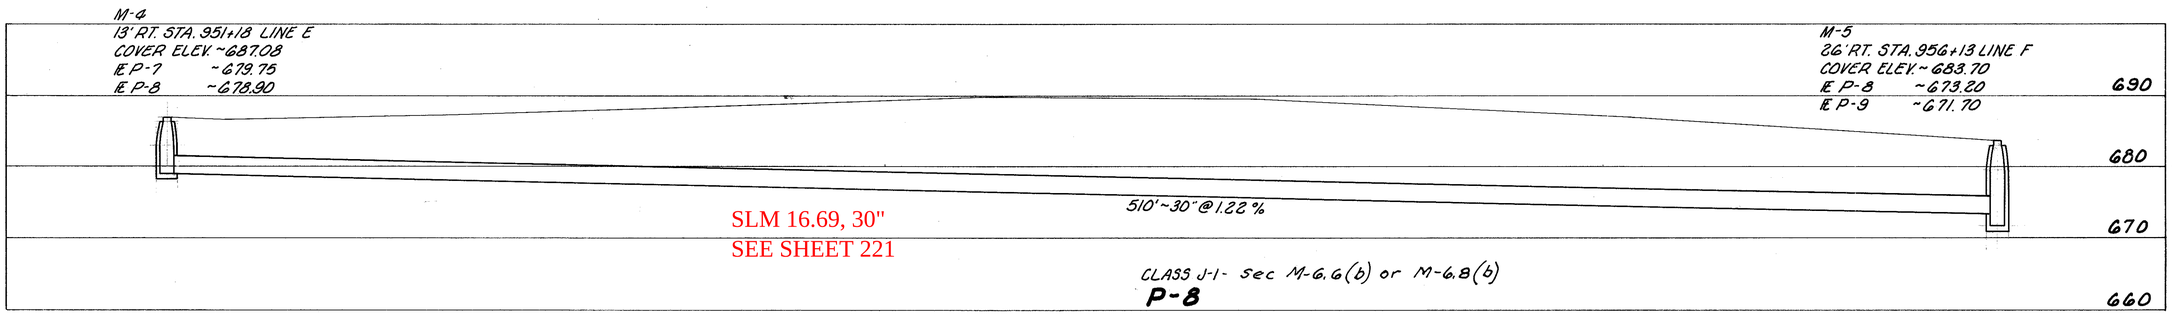

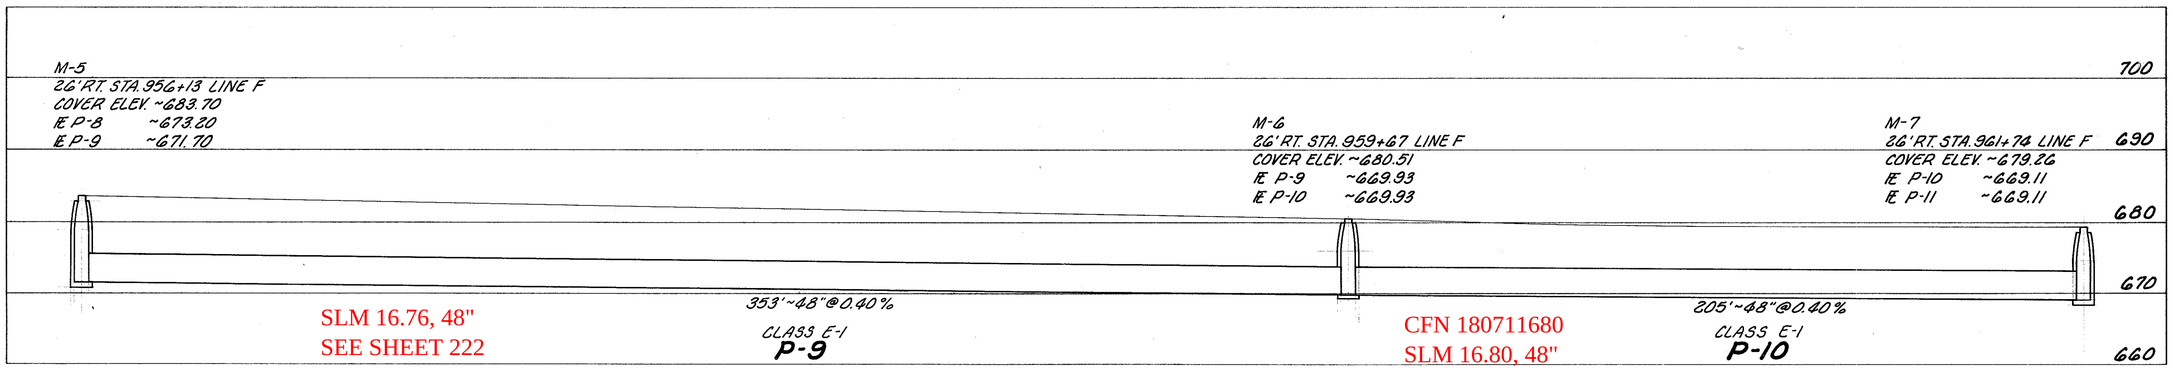

ESTIMATED QUANTITIES

PIPE REFERENCE	STRUCTURES INCLUDED	I-1 CLASS J-1 30" L.F.	I-1 CLASS E-1 48" L.F.	STANDARD NO. 1 MANHOLE EA.	SEE SHEET NO.
P-8	M-5	510		1	221
P-9	M-6		353	1	222
P-10	M-7		205	1	222
	TOTALS	510	558	3	

DRAINAGE PROFILES P-8, P-9 & P