FED. RD. DIVISION	STATE	PROJECT	
2	OHIO		

234

CUYAHOGA COUNTY
CUY-71-15.06

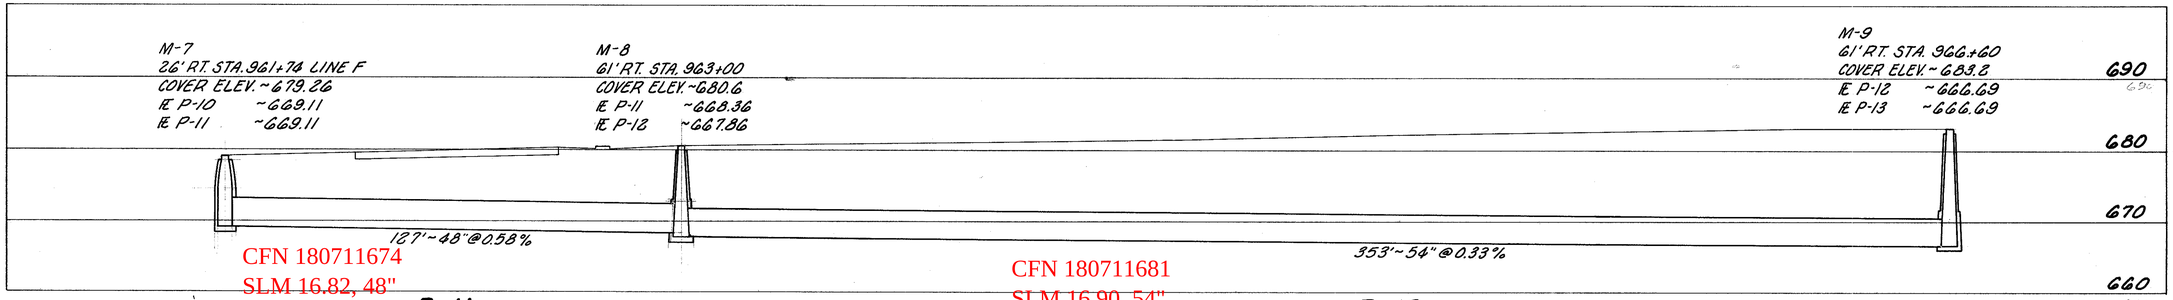

CFN 180711674
SLM 16.82, 48"
SEE SHEET 222

CFN 180711681
SLM 16.90, 54"
SEE SHEET 222

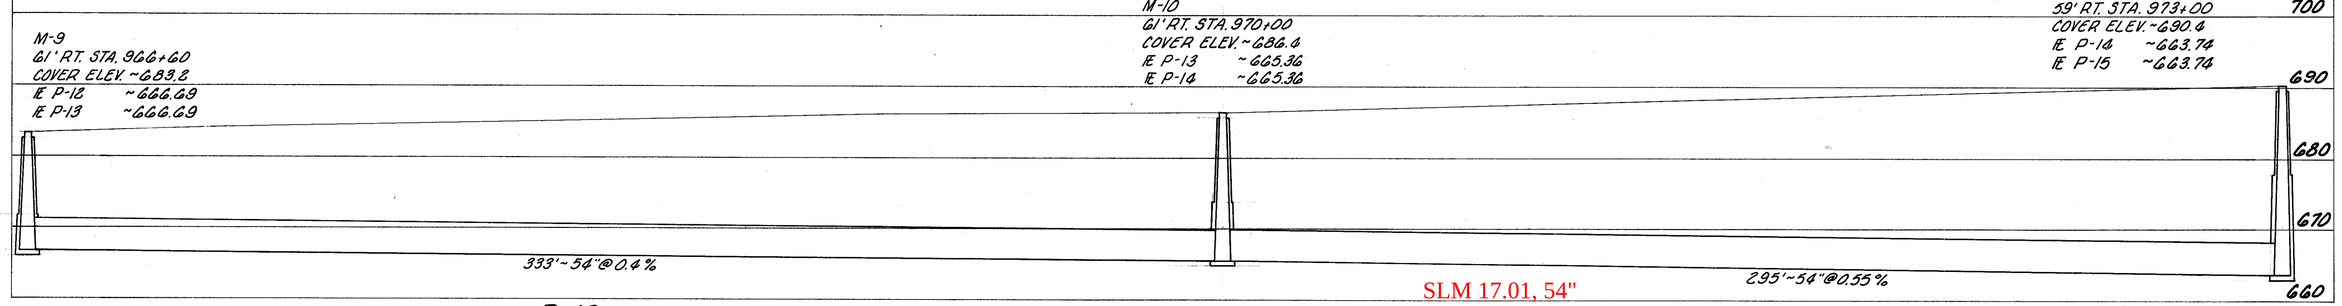

SLM 17.01, 54"
SEE SHEET 224

CFN 180711687
SLM 16.96, 54"
SEE SHEET 222

ESTIMATED QUANTITIES

PIPE REFERENCE	STRUCTURES INCLUDED	I-1 CLASS J-1 SEC. M-6.6(a) 48" L.F.	I-1 CLASS J-1 SEC. M-6.6(c) 54" L.F.	I-1 CLASS J-1 SEC. M-6.6(d) 54" L.F.	I-8 STANDARD NO. 2 MANHOLE 1% DROP PIPE EA.	SEE SHEET NO.
P-11	M-8	127			1	222
P-12	M-9		353		1	222
P-13	M-10		333		1	222
P-14	M-11			295	1	222
TOTALS		127	686	295	4	

DRAINAGE PROFILES P-11 THRU P-14