FED. RD. DIVISION	STATE	PROJECT	
2	OHIO		

235

CUYAHOGA COUNTY
CUY-71-15.06

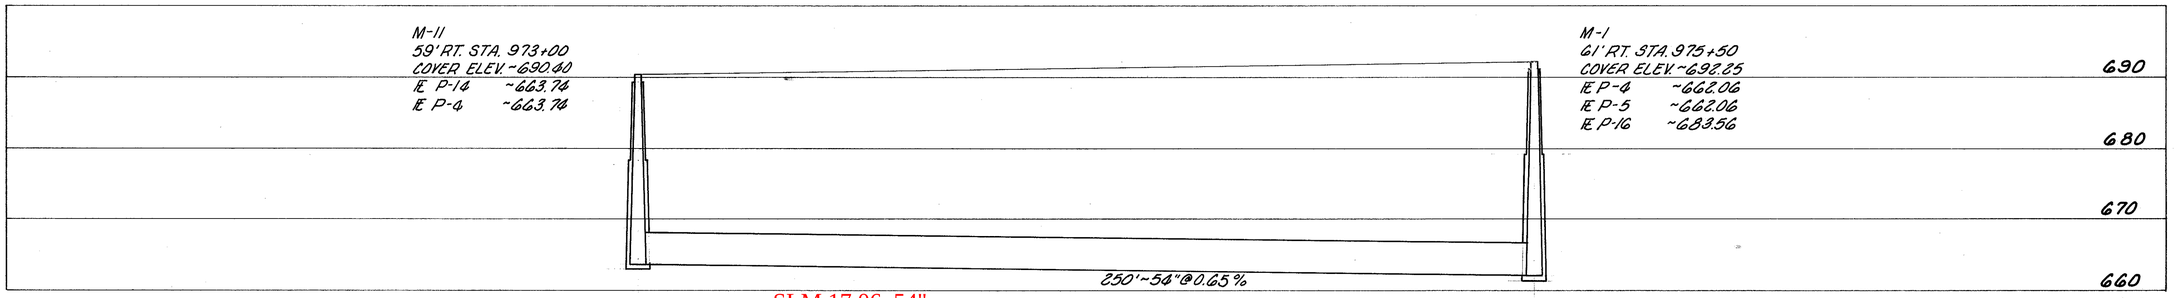

SLM 17.06, 54"
SEE SHEET 235

P-4

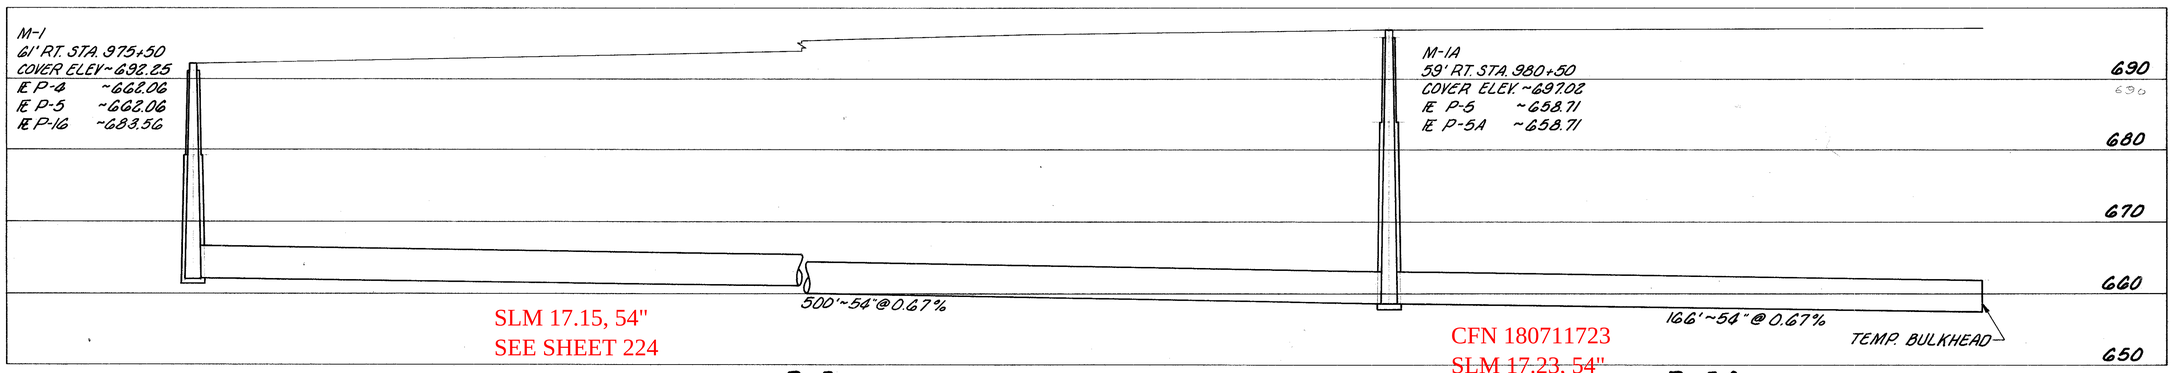

SLM 17.15, 54"
SEE SHEET 224

P-5

CFN 180711723
~~SLM 17.23, 54"~~
SEE SHEET 224

P-5A

ESTIMATED QUANTITIES

PIPE REFERENCE	STRUCTURES INCLUDED	I-1 CLASS J-1 SEC. M-6.06(1) 54" L.F.	I-8 STANDARD NO. 2 MANHOLE W/6 DROP PIPE EA.	SEE SHEET NO.
P-5	M-1	500	1	224
P-5A	M-1A	166	1	224
TOTALS		916	2	

DRAINAGE PROFILES P-4, P-5 & P-5A