

SLM 16.50, 18"
SEE SHEET 221

SLM 16.50, 18"
SEE SHEET 221

SLM 16.55, 15"
SEE SHEET 221

SLM 16.55, 15"
SEE SHEET 221

SLM 16.59, 18"
SEE SHEET 221

SLM 16.59, 18"
SEE SHEET 221

SLM 16.59, 18"
SEE SHEET 221

CLASS J-1
P-20

CLASS J-1
P-21

CLASS J-1
P-22


CLASS E-1
P-23

CLASS J-1
P-24

CLASS J-1
P-25

CLASS J-1
P-26

CLASS E-1
P-27

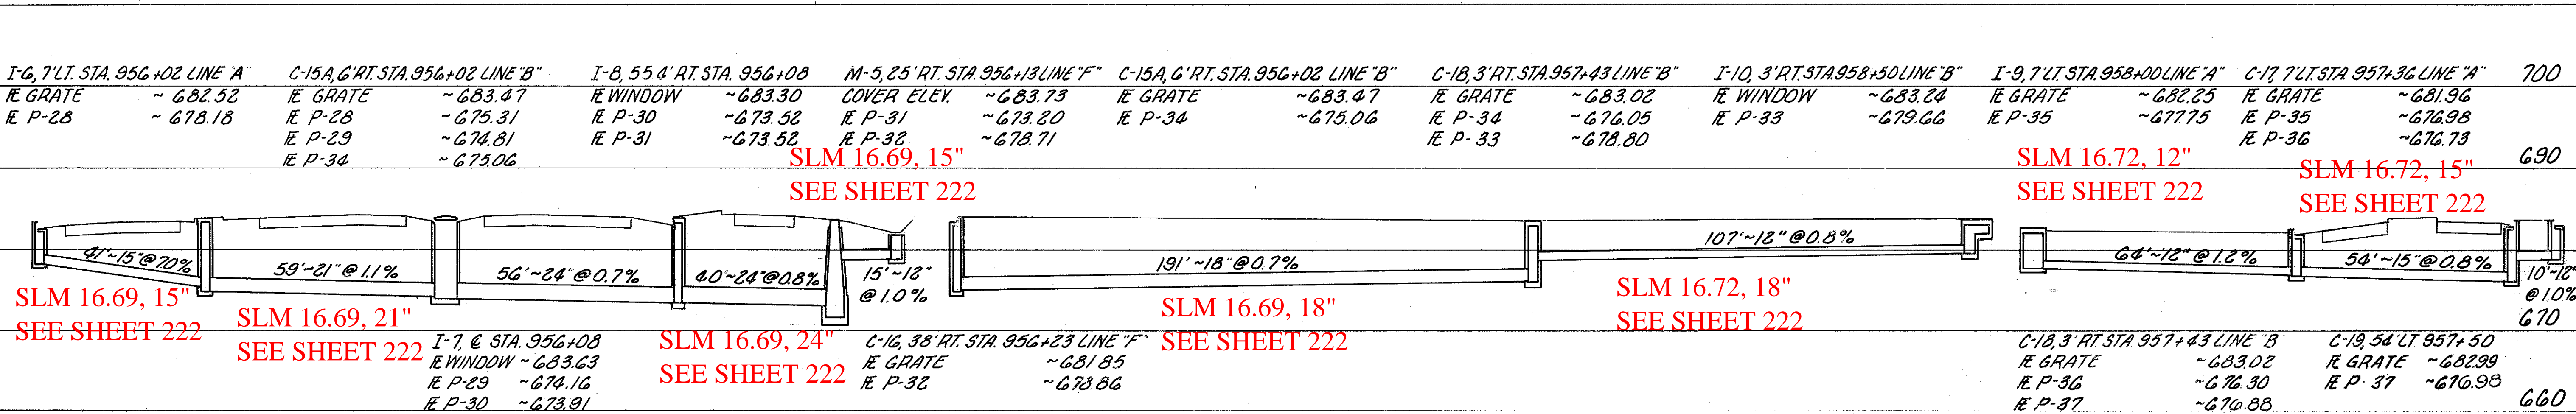

SLM 16.69, 15"
SEE SHEET 222

SLM 16.69, 21"
SEE SHEET 222

SLM 16.69, 24"
SEE SHEET 222

SLM 16.69, 18"
SEE SHEET 222

SLM 16.72, 18"
SEE SHEET 222

SLM 16.72, 12"
SEE SHEET 222

SLM 16.72, 15"
SEE SHEET 222

CLASS J-1
P-28

CLASS J-1
P-29

CLASS J-1
P-30
SLM 16.69, 24"
SEE SHEET 222

CLASS J-1
P-31

CLASS E-1
P-32

CLASS J-1
P-34

CLASS J-1
P-33

CLASS J-1
P-35

CLASS J-1
P-36

CLASS J-1
P-37

SLM 16.72, 12"
SEE SHEET 222

ESTIMATED QUANTITIES																			
PIPE REFERENCE	STRUCTURES INCLUDED	CLASS J-1					CLASS E-1			CLASS J-1					CLASS E-1				
		12"	15"	18"	21"	24"	12"	15"	18"	12"	15"	18"	21"	24"	12"	15"	18"	21"	24"
		L.F.	L.F.	L.F.	L.F.	L.F.	L.F.	L.F.	L.F.	L.F.	L.F.	L.F.	L.F.	L.F.	L.F.	L.F.	L.F.	L.F.	L.F.
P-20, P-21	C-4, I-3																		
P-22, P-23	C-9, C-10		53	190															
P-24	C-14			102															
P-25	I-4			67															
P-26	I-5			62															
P-27	C-15																		
P-28	I-6		41																
P-29	C-15A				39														
P-30	I-7					56													
P-31	I-8					40													
P-32	C-16																		
P-33	I-10	107					15												
P-34	C-18			191															
P-35	I-9	64																	
P-36	C-17		54																
P-37	C-19	10																	
TOTALS		181	148	612	59	96	15	20	40	2	2	1	1	2	4	1	5	625	