


CUYAHOGA COUNTY
CUY-71-13.68

DESCRIPTION	DATE	INCHES	CHECKED
BY	BY	BY	BY
DATE	DATE	DATE	DATE
DATE	DATE	DATE	DATE
SLM 14.70, 15"
SEE SHEET 131

CFN 180711478
SLM 14.78, 48"
SEE SHEET 122

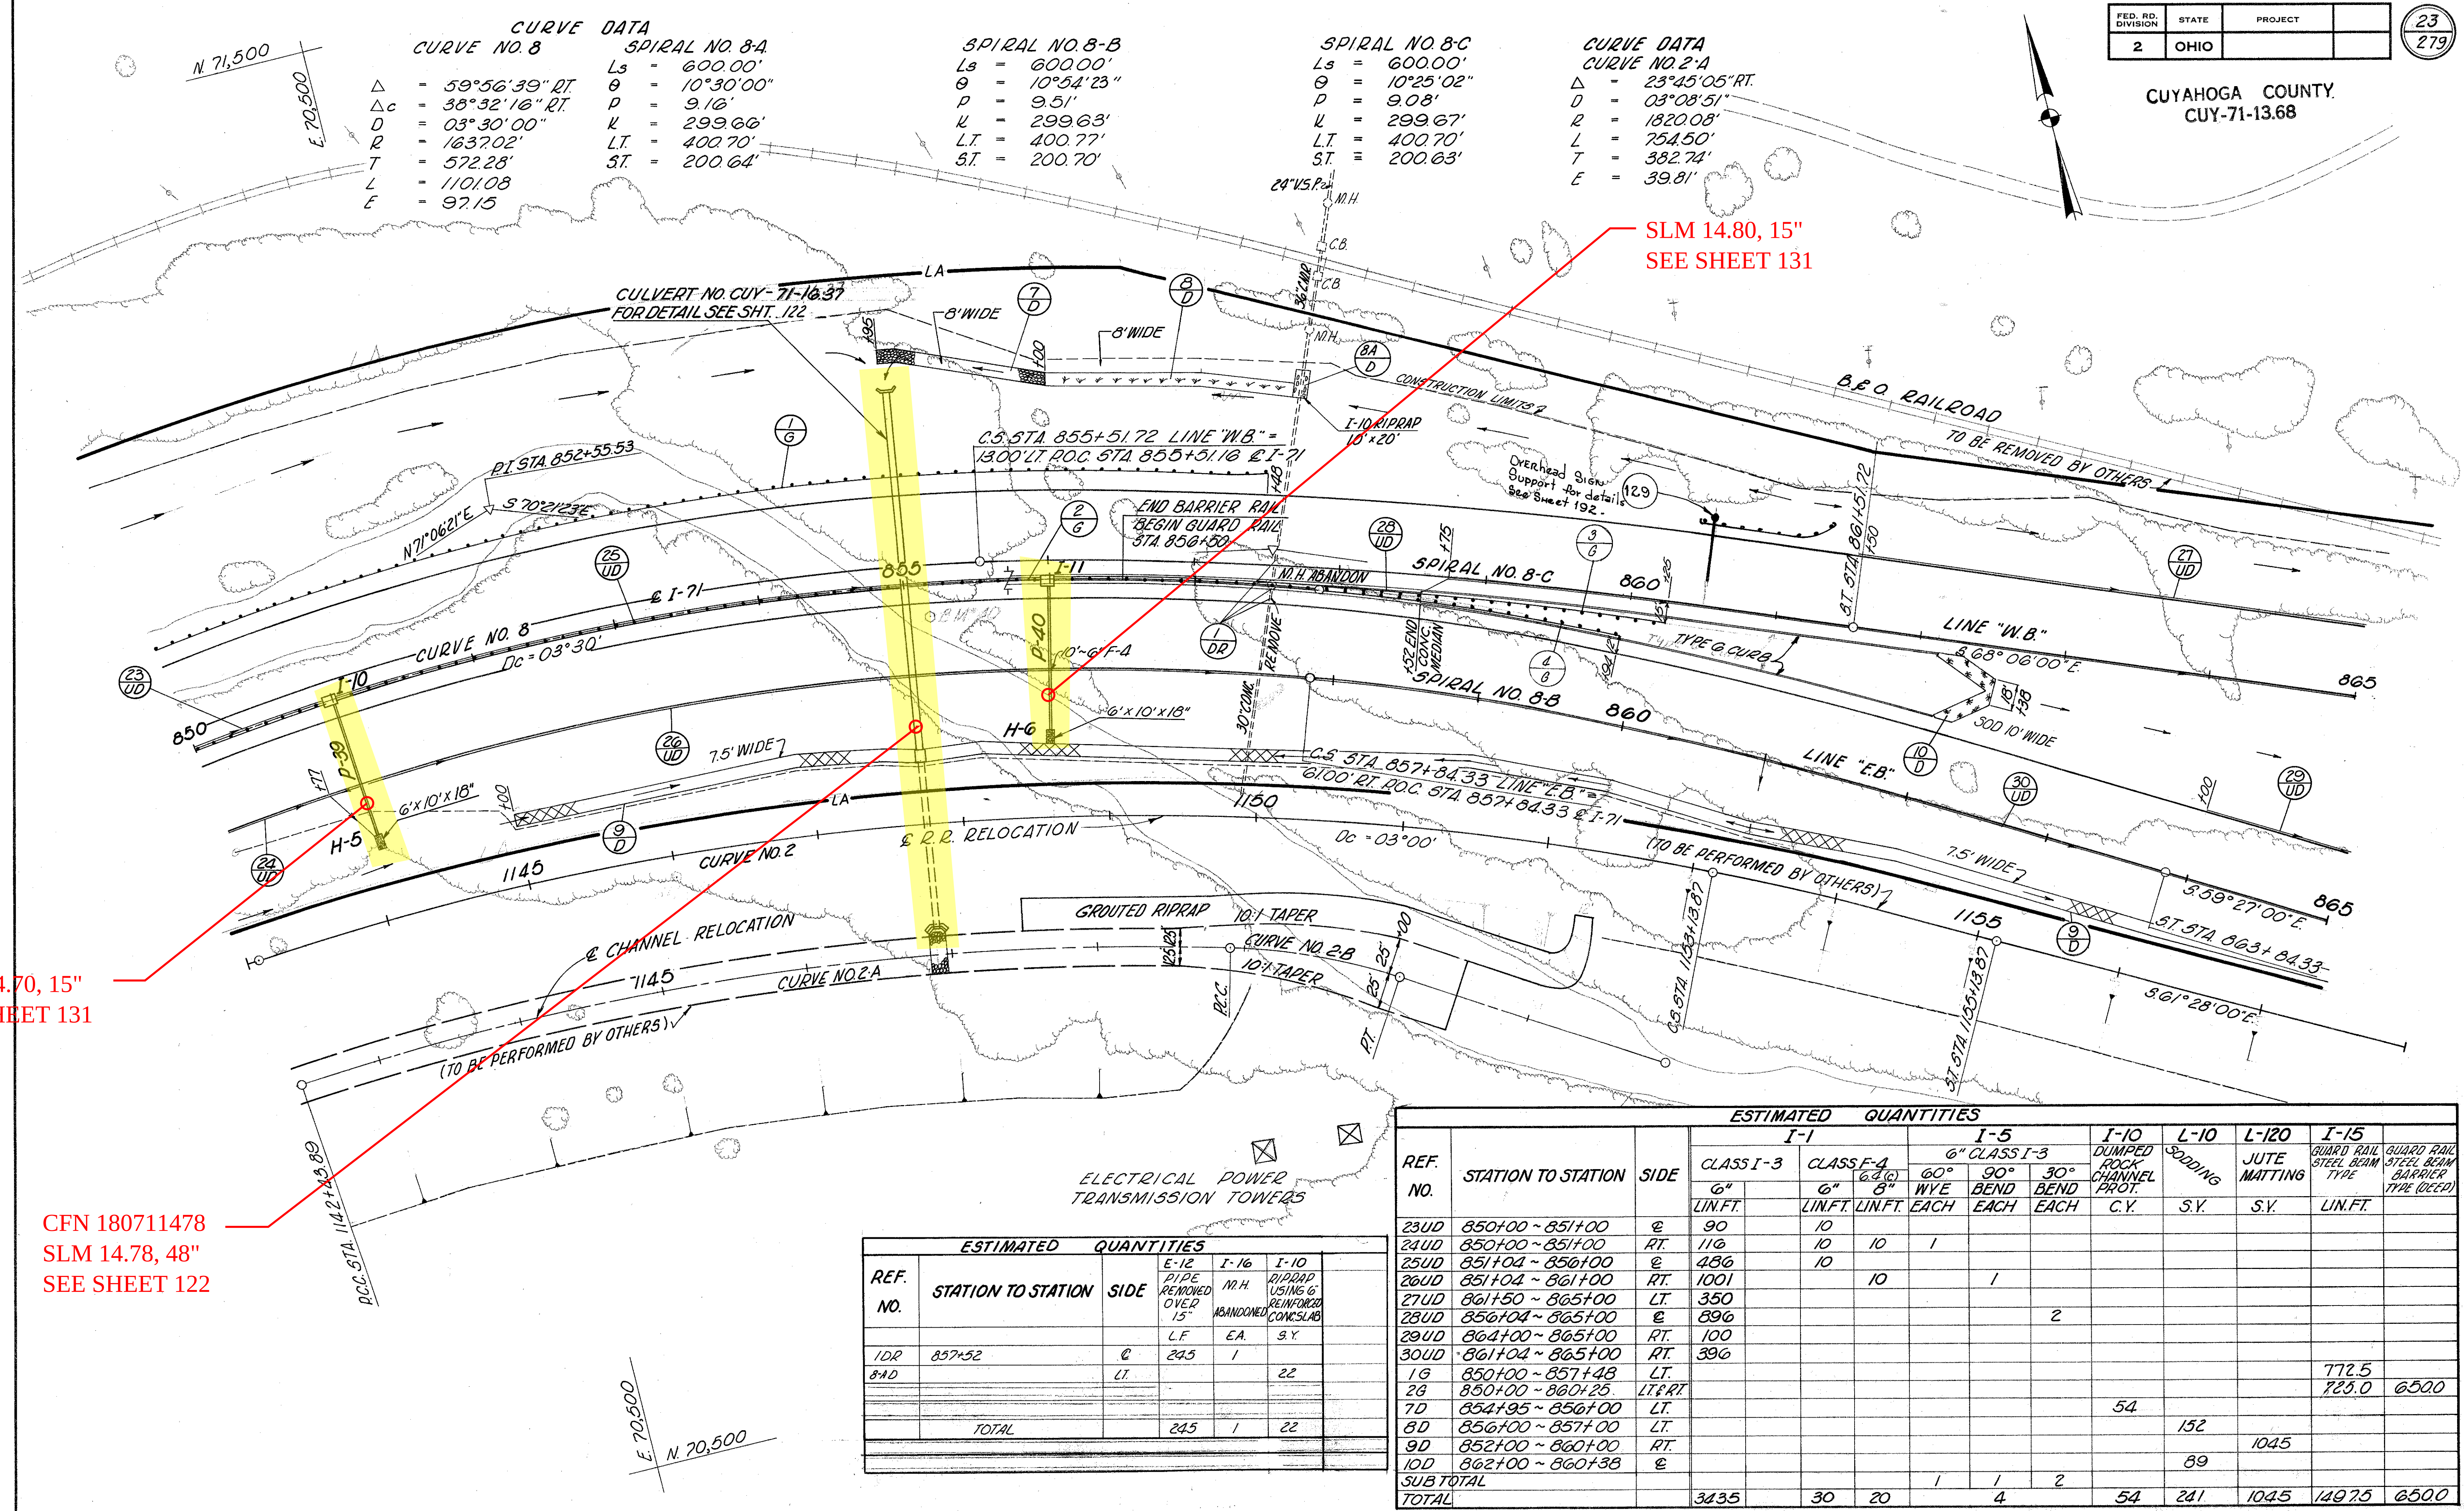

ESTIMATED QUANTITIES				
REF. NO.	STATION TO STATION	SIDE	E-12 PIPE REMOVED OVER 15"	I-16 M.H. ABANDONED
1DR	857+52	℄	245	1
84D		LT.		22
	TOTAL		245	22

ESTIMATED QUANTITIES											
REF. NO.	STATION TO STATION	SIDE	I-1		I-5		I-10		L-10	L-120	I-15
			CLASS I-3	CLASS F-4	6" CLASS I-3	60°	90°	30°			
			6"	6"	6"	WYE	BEND	BEND			
			LIN.FT.	LIN.FT.	LIN.FT.	EACH	EACH	EACH	C.V.	S.V.	S.V.
23UD	850+00 ~ 851+00	℄	90								
24UD	850+00 ~ 851+00	RT.	110	10	10	1					
25UD	851+04 ~ 856+00	℄	436	10							
26UD	851+04 ~ 861+00	RT.	1001	10			1				
27UD	861+50 ~ 865+00	LT.	350								
28UD	856+04 ~ 865+00	℄	896					2			
29UD	864+00 ~ 865+00	RT.	100								
30UD	861+04 ~ 865+00	RT.	396								
1G	850+00 ~ 857+48	LT.									772.5
2G	850+00 ~ 860+25	LT&RT									725.0
7D	854+95 ~ 856+00	LT.									6500
8D	856+00 ~ 857+00	LT.									
9D	852+00 ~ 860+00	RT.									
10D	862+00 ~ 860+38	℄									
SUB TOTAL						1	1	2			
TOTAL			3435	30	20		4		54	241	1045

STA 850+00 (℄ I-71) TO STA 865+00 (LINE "EB")
(LINE "WB")