


CUYAHOGA COUNTY
CUY-71-13.68

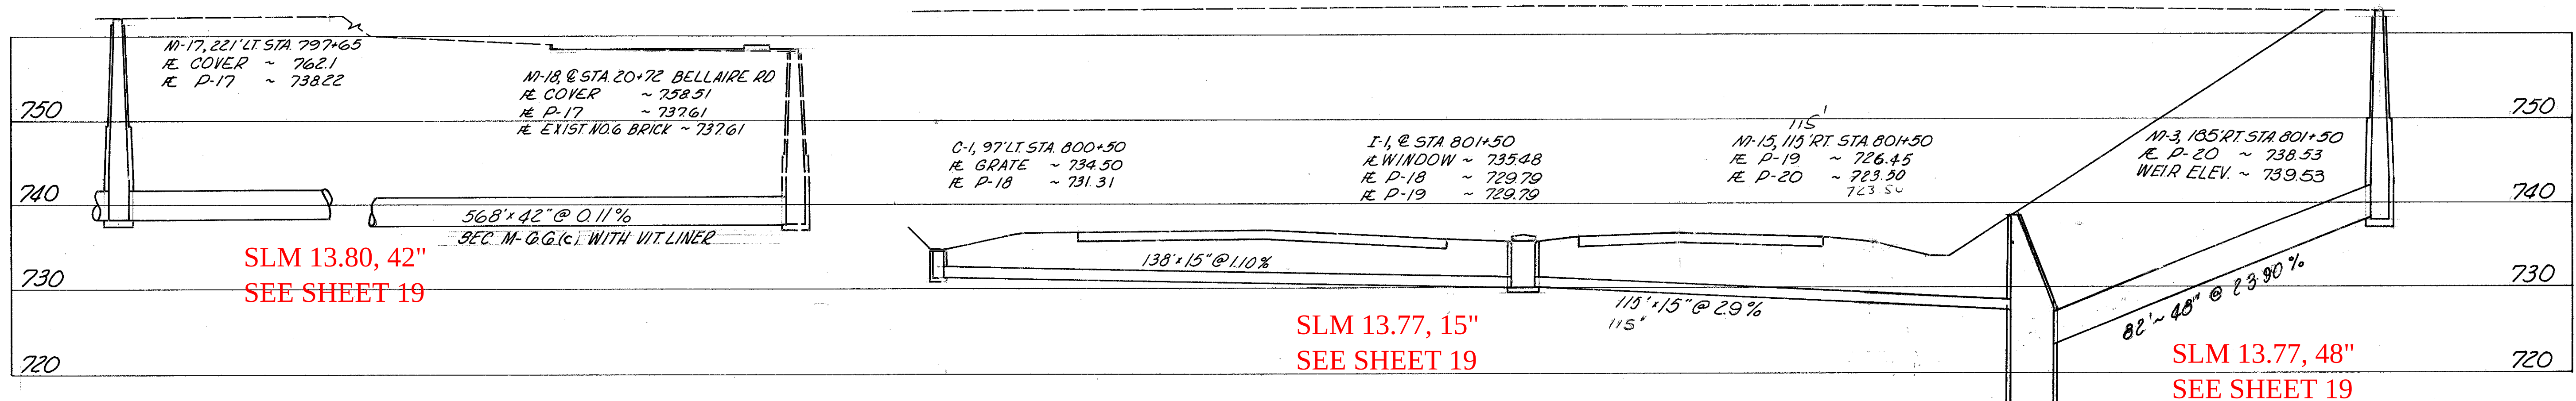


CLASS B-1
P-17

CLASS J-1
P-18

CLASS J-1
P-19

CLASS B-1 SEC. M-G.G(d)
P-20

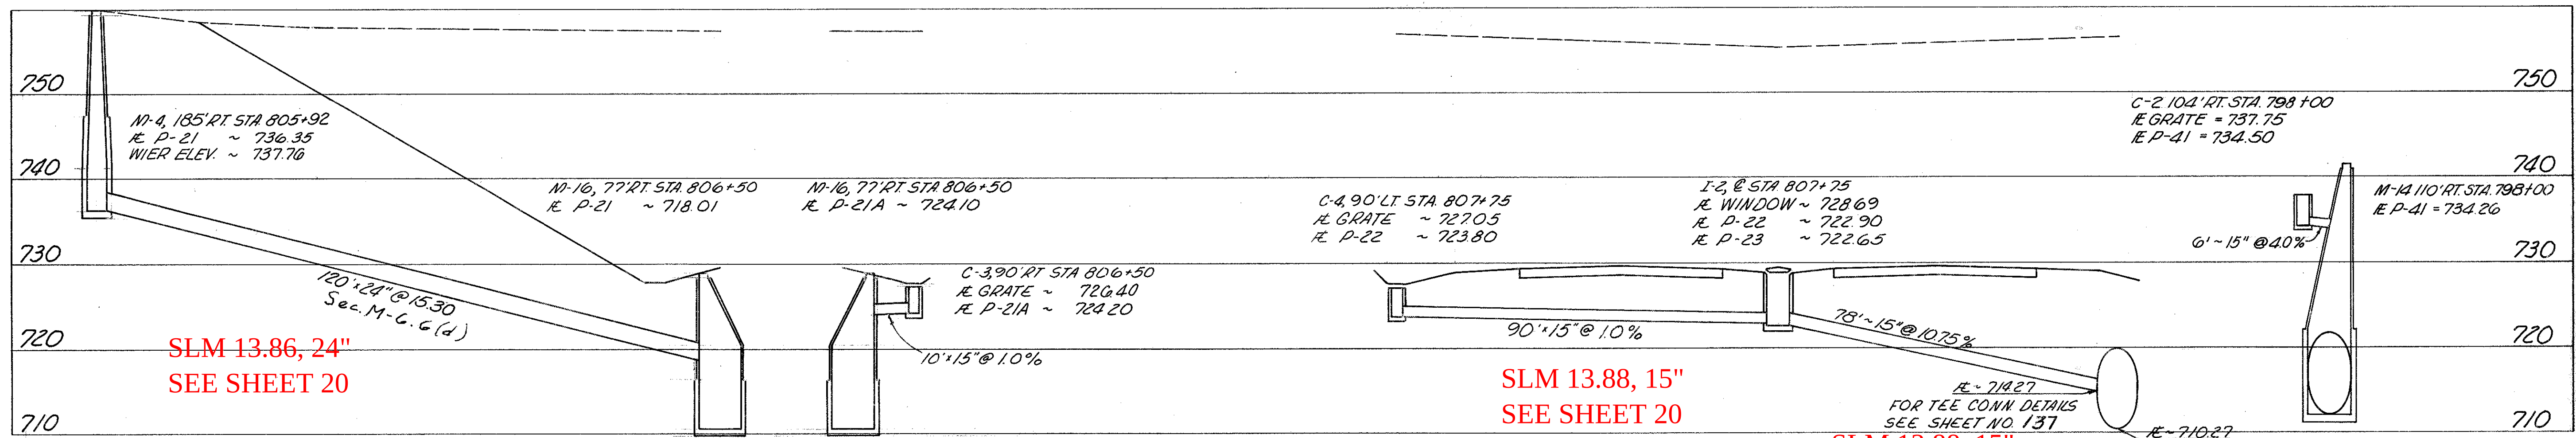

CLASS B-1 SEC. M-G.G(d)
P-21

CLASS E-1
P-21A

CLASS J-1
P-22

SLM 13.88, 15"
SEE SHEET 20
CLASS J-1 SEC. M-G.G(b)
P-23

P-41

* CODE Y060 + SEC. M-G.G(b) or G.B(b)

ESTIMATED QUANTITIES															SEE SHEET NO.
PIPE REFERENCE	STRUCTURES INCLUDED	I-1					I-8					I-8		L-120	
		CLASS J-1		CLASS B-1			STANDARD NO. 5 CATCH BASIN	SPECIAL INLET NO. 2-G	SPECIAL INLET NO. 2-10	STANDARD NO. 1 MANHOLE	MANHOLE ADJUSTED TO GRADE	SPECIAL NO. 4 CATCH BASIN	JUTE MATTING		
		CL. B-1 SEC. M- G.G.(c) #	SEC. M- G.G.(c) LIN. FT.	SEC. M- G.G.(d) LIN. FT.	SEC. M- G.G.(e) LIN. FT.	SEC. M- G.G.(f) LIN. FT.									
		12" LIN. FT.	15" LIN. FT.	42" LIN. FT.	24" LIN. FT.	48" LIN. FT.									
P-17	M-17, M-18			568*							1 *	1 *			
P-18	C-1		138				1							125	
P-19	I-1		115						1						
P-20															
P-21				120	82										
P-21A	C-3					10	1							125	
P-22	C-4		90				1							125	
P-23	I-2		78					1							
P-41	C-2					6	1							125	
P-12			23										1		
TOTALS		23	343	78	568*	120	82	16	4	1	1	1 *	1 *	500	

